



CITY OF ANN ARBOR, MICHIGAN
Public Services Area/Water Treatment
919 Sunset Road
Ann Arbor, Michigan 48103

Web: www.a2gov.org Printed on recycled paper

May 18, 2012

To: All Contract Document Holders

**RE: Addendum to the Contract Documents for the West High Service Pump Station
Bid No. ITB-4221**

Attached is a copy of Addendum Number Two for the West High Service Pump Station Project. This Addendum supersedes and updates the Contract Document information for Bid No. ITB-4221. All Bidders shall acknowledge receipt and acceptance of this Addendum Number Two by so indicating on the Invitation to Bid Form located in the existing Contract Documents. Bids submitted without acknowledgment of receipt of this Addendum will be considered informal. If you have any questions regarding the Contract Documents or this Addendum, please contact Glen Wiczorek, PE, Stantec Consulting, Project Manager by email at glen.wiczorek@stantec.com.

Sincerely,

Brian Steglitz, P.E.
Sr. Utilities Engineer
City of Ann Arbor Water Treatment Plant

enc.

May 18, 2012

**ADDENDUM NO. 2
TO
BID DOCUMENTS
FOR
WEST HIGH SERVICE PUMP STATION
FOR THE
CITY OF ANN ARBOR, MICHIGAN**

The following changes, additions, and/or deletions shall be made to the Bid Documents for the West High Service Pump Station Project for the City of Ann Arbor, Michigan, Bid No. ITB – 4221 on which bids were to be received, on or before, 10:00 A.M. Thursday, May 31, 2012.

**PROPOSALS SHALL NOW BE RECEIVED ON, OR BEFORE, 3:00 P.M., THURSDAY,
MAY 31, 2012.**

The information contained herein shall take precedence over the original documents and all previous addenda, and is appended thereto.

All Bidders shall acknowledge receipt and acceptance of this Addendum No. 2, including all attachments, by so indicating on page ITB-1 of the Invitation to Bid Form. Bids submitted without acknowledgement of receipt of this addendum will be considered informal.

Changes in the Bid Documents which are outlined below are referenced to a page or drawing in which they appear conspicuously. The Bidder is to take note in its review of the documents and include these changes as they affect work or details in other areas not specifically referenced here. Changes to the original text are bolded, underlined and italicized.

GENERAL

Attached at the end of the addendum is the sign-in sheet for the Site Walkthrough held on Thursday, May 17, 2012.

DETAILED SPECIFICATIONS

SPECIFICATION SECTION 15400 – PLUMBING AND DRAINAGE

Add Paragraph 2.2.C, as follows:

A. Compressed Air Piping

- 1. Compressed air pipes shall be Schedule 40, black continuous weld steel pipe in accordance with ASTM A53 or ASTM A120.**
- 2. Fittings 2" and smaller to be 150 lb. black malleable iron, screwed ends, in**

accordance with ASTM A197. Unions to be 300 lb., malleable iron, ground joint with brass seat.

3. Provide and install shut-off valve on the main line and on the line to each outlet. Valve working pressure to be 150 psi, stainless steel ball and stem, steel lever-handle standard, blowout-proof stem, UL listed. Similar to Jenkins Brass Ball Valve Figure 201SJ or approved equal.

SPECIFICATION SECTION 03300 – CAST-IN-PLACE CONCRETE

Add Paragraph 3.9.C.2, as follows:

2. Crack Repair – Any structural cracks in the concrete that manifest themselves shall be repaired by pressure injection methods.
 - a. Pressure injection shall be performed per all manufacturer recommendations.
 - b. Injection grout shall be Sikadur 31 and 35; overlay patching materials shall be SikaTop 123 Plus. Equivalent products by Master Builders shall be acceptable.

SPECIFICATION SECTION 13200 – SURGE TANK

Add Paragraph 2.4, as follows:

2.4 MANUFACTURERS / SUPPLIERS

- A. The surge tank and all related system components, including but not limited to the following: 5,000 gallon tank with fittings, air compressor, solenoid valves, air relief valve, safety relief valves, electrodes, sight glass assembly, pressure gauges, and control panel, shall be provided as a complete and operational transient mitigation system with single source responsibility. Single source responsibility shall specifically include shop drawing submittal, furnishing, startup, testing, commissioning, functionality, and warranty of the surge tank system.
- B. The surge tank system shall be as supplied by Pulsco (represented by Dale Bentley, Peterson & Matz, 248-476-3204), or Approved Equal.

SPECIFICATION SECTION 17010 – INSTRUMENTATION GENERAL CONDITIONS

Revise Paragraph 1.5.K.1, as follows:

1. Existing SCADA Server located in the SCADA server cabinet in the main control room: (not in contract).

SPECIFICATION SECTION 17015 – I&C SCOPE OF WORK

Revise Paragraph 1.1.A.2.d, as follows:

- d. ~~DeviceNet~~, Fieldbus and Modbus wiring and communication equipment.

Delete Paragraph 1.3.A.6:

6. ~~Provide setup and commission DeviceNet networks. Terminate both ends of each DeviceNet bus.~~

SPECIFICATION SECTION 17330 – SPARE PARTS

Revise Paragraph 2.2.A, as follows:

- A. Provide the following spare parts:

No.	Description	Qty.
1.	PLC Power Supply 1756-PA75 <u>CompactLogix</u>	1
2.	PLC DeviceNet Module 1756-DNB <u>CompactLogix</u>	1
3.	PLC Ethernet <u>Analog Out</u> Module 1756-ENBT <u>CompactLogix</u>	1
4.	PLC Analog Input Module 1756-IA32 <u>CompactLogix</u>	1
5.	PLC Analog Input Module 1756-IA16 <u>CompactLogix</u>	1
6.	One Pressure Transducer	1
7.	One Float	1

SPECIFICATION SECTION 17440 – CONTROL PANEL - PLC

Revise Paragraph 2.9.I.1, as follows:

1. Programmable Controller shall provide high reliability in industrial applications. The internal wiring of the controller is to be fixed, with the logic functions it must perform in a given application to be programmed into its memory. The controller shall be supplied with the CPU, memory (program and data) input/output modules, ~~DeviceNet scanners~~, Ethernet TCP/IP modules, power supply, and all power and interface cables necessary to function as a complete, reliable and operable system.

Revise Paragraph 2.9.I.10, as follows:

1. Programmable Controller shall have at least two ~~DeviceNet Scanner~~ **Ethernet TCP/IP** modules for connection to associated MCC.

SPECIFICATION SECTION 17701 – INSTRUMENT SPEC SHEETS

Revise Magnetic Flow Meter Instrument Data Sheet per attachment.

Revise Pressure Transmitter Instrument Data Sheet per attachment.

DRAWINGS

Revise Drawing C-104 to reflect an ADA compliant ramp on the south side of the pump station.

Revise Drawing C-105 to reflect grade changes for the ADA compliant ramp.

Revise Drawing P-102 to reflect the valve type change on the WHS discharge.

Revise Drawing P-107 to reflect a change in the surge tank manhole dimensions.

Revise Drawing E-120 to update conduit note.

Revise Drawing E-122 to show the homeruns for electrical feeders to the sump pumps and surge tank control panel.

Revise Drawing E-123 to show the location of power conduit P26.

Revise Drawing E-607 to reflect the feeder breakers for the sump pumps, air compressor, and surge tank control panel. Also updated the Power Conduit Schedule so P9 requires a total of 5 conduits and P10 will require a total of 2 conduits. Also updated to reflect additional conduit and conductors.

Revise Drawing I-105 to add a second PLC for the monitoring of medium voltage service breakers.

QUESTIONS AND ANSWERS

- Q: On Drawing M-104 the CW to BFP-1 is shown as 1-1/2" down, and on Drawing M-105 the same CW is shown as 3/4" up. What is correct diameter of this CW pipe?
- A. **The CW pipe to BFP-1 shall be 1-1/2".**
- Q. On Drawing M-105 the FFD serving the Air Compressor is shown on Plan El. 978.25. Should this FFD be shown on Plan El. 963.0?
- A. **The FFD serving the Air Compressor should be shown on Plan El. 963.0. The air compressor drain shall be piped directly to the FFD with copper piping and secured to the floor. The FFD shall tie into the 6-inch sanitary on the north end of the building shown on Plan El. 963.0.**

- Q. In Detail 2 on Drawing S-100 there is a note on the north side of the building stating “New 6” dia. perforated drain connect to storm drain.” On what drawing is this connection shown and what is the proposed invert?
- A. **The drain connects to the 2-foot diameter catch basin shown on Drawing C-107. The invert at the proposed catch basin shall be changed to 978.50’.**
- Q. On Drawing A-600, what is the size of the window in Door Type “A”?
- A. **Provide 6-inch clearance top and sides, and approximately 6-inch clearance above panic hardware.**
- Q. Are there any MDOT permits required?
- A. **There are no MDOT permits required on this project.**
- Q. Domestic 30” x 24” flange 90° bends and 30" x 30” x 36" flange tees are not available. Can these be imported?
- A. **Only the 30” x 24” flange 90° bends and the 30” x 30” x 36” flange tee can be imported. Imported fittings must be manufactured by American Cast Iron Pipe Company, Clow, or Tyler Union.**
- Q. On Drawing P-104, the suction header 30"x12" tees are drawn with 46" laying length. They are actually 36" face to face. Should a spool piece be included?
- A. **Contractors shall include a spool piece in their bid anywhere the drawn laying length does not meet the available fitting laying length.**
- Q. On Drawing P-104, the discharge piping shows an 18" dia. x 2'9" flg x flg spool piece between the 18"x16" reducer and the check valve. On Drawing P-103 this is shown as an 18” x 4" flange tee. Which drawing is correct?
- A. **Contractor shall provide an 18” diameter spool piece as shown on Drawing P-104 with a 1” tap per the pressure gauge detail on Drawing P-106.**
- Q. Tyler/Union does not shop prime their fittings with Tnemec F.C. Typoxy Series 27 primer. Is Tnemec Series 66 shop primer acceptable?
- A. **Yes, Tnemec Series 66 is an acceptable alternative shop primer on process piping.**
- Q. In the surge tank detail on Drawing P-107, the tank tangent length is shown as 17’-6” and the diameter is shown as 7’-0”. Specification Section 13200-Surge Tank indicates that the nominal tank capacity should be 5,000 gallons. Is a tank with a 16’-0” tangent length, 7’-0” diameter, and a capacity of 5,195 gallons acceptable?
- A. **Tank diameter may not change. Length may change so long as the volume requirements in the specifications are met.**
- Q. Specification Section 13200, Paragraph 3.1.C. states “The Contractor and fabricator shall plan to have the tank delivered to the site in sections and welded together at the project site for installation at the location indicated in the drawings.” Typically tanks of this type are built in a fabrication shop and delivered complete. Is it necessary to weld the tank in the field?
- A. **The Contractor, at his option, can either have the tank delivered complete and**

installed before the placement of the floor slab above the tank, or can have the tank delivered in sections and assembled in place after the placement of the floor slab. In either case, protection of the equipment is critical. The means and methods used to provide a complete and working surge tank system at the location indicated in the plans is the responsibility of the Contractor.

- Q. The surge tank detail on Drawing P-107 requires three (3) tank supports. Can the tank be installed with only two (2) supports?
- A. **The three (3) saddle supports were designed to resist the buoyant forces resulting from a station flood (to elev. 990.0) with the tank empty. Two (2) saddles are acceptable, provided that a new design and supporting calculations for the anchoring of the tank to the foundation slab are prepared and submitted by a Professional Engineer licensed in the State of Michigan.**
- Q. The profiles on Drawings C-201, C-202 and C-203 show butterfly valves on the yard piping and the plan on Drawing C-106 show gate valves. Which drawing is correct?
- A. **Where conflict exists, all valve types shall be per Drawing C-106.**
- Q. On Drawing I-122 the Conduit & Cable Schedule shows four vendor control panels for the Vertical Turbine Pumps with regard to the analog signals. The same schedule, as well as the other Contract Drawings show two vendor control panels total for the four pumps. Please address this discrepancy.
- A. **There are only two vendor control panels for the four pumps. Each vendor control panel will be for the vibration/temperature system monitoring. Each individual panel can monitor two pumps/motors.**
- Q. The vendor control panels for the vertical turbine pumps are not specified in Specification Section 11214. Where are these vendor control panels specified?
- A. **Please refer to Specification Sections 17325 and 17326 for the equipment related to the pump vibration and temperature monitoring systems.**
- Q. Based on Drawing Nos. E-105 and E-603, with regards to Circuit P3, the cables for the feeder from SB-Gen to Red SB1 will be spliced to existing conductors in manhole PHH2. Please verify that this is correct.
- A. **No splices will be allowed below grade. The Contractor will pull back the existing generator feed for reconnection to the RSB1. Please refer to Drawings E-103, E-106 and E-123 for further details.**
- Q. Drawing E-120, Note 26 identifies a 4" conduit with 12 strand multi-mode fiber going from the existing fiber termination point. Is it correct to assume that this is Circuit P25 as shown on Drawing E-123?
- A. **Yes.**
- Q. Is the existing fire alarm system simplex?
- A. **Yes.**

- Q. Specification Section 17010, Paragraph 1.5.K.1 indicates a server is to be provided; however, Drawing I-600 is not represented as such. Please Clarify.
- A. **The server is existing and is not part of this contact.**
- Q. Specification Section 17010, Paragraph 1.5.K.6 indicates only one (1) main PLC panel is to be provided by the system integrator; however, on Drawing I-105 a switchgear monitoring PLC panel is shown for monitoring purposes. Furthermore, Specification Section 16245 does not indicate this panel is to be provided nor does it indicate that any communication protocol is required. Please clarify the intent of this control panel and further indicate if this control panel should be added to Section 17010, Paragraph 1.5.K.6.
- A. **A second PLC is required for the monitoring of medium voltage service breakers. Drawing I-105 is being updated in this addendum.**
- Q. Specification Section 17330 includes a list of ControlLogix spare parts to be provided; however, Drawings I-700 thru I-708 represent a CompactLogix platform. Please clarify if ControlLogix cards are indeed what are required.
- A. **The spare parts will be for the Allen-Bradley Compact Logic controllers. Specification 17330 has been updated for spare part requirements as part of this addendum.**
- Q. Specification Section 17440 describes at least two DeviceNet Scanner modules are required to communicate with the motor control center; however, Specification Section 16483 and Drawings I-601 thru I-603 do not describe or represent DeviceNet communications are required. Furthermore, it is mentioned in Specification Section 17015, Paragraph 1.1.D.4.e as a device for the system integrator to provide power monitoring for the motor control centers. Please clarify.
- A. **The references to DeviceNet are in error and will be removed from the contract documents. The power monitors will communicate via the Ethernet backbone system.**
- Q. Process and Instrumentation Drawings do not show PI/PIT-101B; however, in Specification Section 17701 the instrument data sheets provided for Specification Section 17322 indicate a “redundant” pressure transmitter & gauge is required for the West High Service Pump Station discharge header. Please clarify if this will be added to the Drawings or if the unit is not required.
- A. **PI/PIT-101B will be removed from the data sheets.**
- Q. In Specification Section 17701 the instrument data sheets provided for Specification Section 17324 indicate that FIT/Fe-105 is for “EHPS Effluent” flow; however, with the drawings this tag ID corresponds to the WHPS effluent flow. Please clarify.
- A. **The Instrument Data sheet will be updated to reflect West High Service Pump Station effluent flow.**
- Q. Specification Section 17720 describes acceptable process automation equipment as Allen-Bradley ControlLogix for Control; however, the Drawings are represented as a CompactLogix platform. Please clarify.
- A. **All controls will be CompactLogix.**

- Q. On Drawing I-701, the I/O card description indicates a part number for an analog input module. Please confirm if the part number should actually be 1769-OF4CI.
- A. **The correct part number for analog card is 1769-OF4CI.**
- Q. Specification Section 16700- Low Voltage Cabling is included in the Contract Documents; however, there are no drawings related to this section.
- A. **Drawings E-123, E-124, E-153 and E-800 show the various requirements for the low voltage cabling. Drawing E-607 has been updated as part of this addendum to reflect additional requirements to related to Section 16700.**
- Q. On Drawing AD-100, the drawing note indicates that the two openings (32 x 32 and 92 x 38) shall be primed and painted. Is that correct?
- A. **The two openings shall be wallpapered (vinyl) to match existing.**
- Q. What is the size of the existing gas line downstream of the gas meter where the point of connection is being made?
- A. **The size is 4-inch diameter.**
- Q. On Drawing P-102 in the Valve Schedule, please clarify the comment in the Valve ID column.
- A. **All valves and tags shall be provided by the Contractor. Only the number scheme for identification shall be provided by the Owner/Engineer.**

END OF ADDENDUM



Stantec

**CITY OF ANN ARBOR WATER TREATMENT PLANT
WEST HIGH SERVICE PUMP STATION
ITB #4221
SITE WALKTHROUGH ATTENDANCE
THURSDAY, MAY 17, 2012; 9:00 AM to 2:00 PM**

Name/Representing	Address	e-mail address	Phone/Fax
Brian Steglitz, PE City of Ann Arbor	919 Sunset Rd. Ann Arbor, MI 48103		P
			f
Glen Wiczorek, PE Stantec Consulting	3754 Ranchero Drive Ann Arbor, MI 48108	<u>Glen.Wiczorek@Stantec.com</u>	P
			f (734) 761-1200
Chris Elenbaas and Greg Schofer Stantec Consulting	3754 Ranchero Drive Ann Arbor, MI 48108	<u>Chris.Elenbaas@stantec.com</u> <u>Greg.Schofer@stantec.com</u>	P
			f
Steve Warrnack Lake Erie Electric	20800 Chesley Dr Farmington, MI 48336	Swarnack.electric.com	P 248 473 6222
			f
Tim Hall 3LK Coatings	18401 Weaver Detroit, 48228	thalle3lkconstruction.com	P 313 999-0251
			f 313 493-9091
BEN ROSENBERG ROTON ELECTRICS	9522 E RIVERLY DETROIT, 48213	benrosenbergrotonelectric.com	P 313 891-0331
			f (313) 891-0511
MAURICE P MONTPAS SORENSEN GROSS CONSTRUCTION SERVICE	3407 TORREY RD FLINT MI 48507	mpmontpas@sacs.net	P 616-235-3200
			f 810 238-6222



Stantec

**CITY OF ANN ARBOR WATER TREATMENT PLANT
WEST HIGH SERVICE PUMP STATION
ITB #4221
SITE WALKTHROUGH ATTENDANCE
THURSDAY, MAY 17, 2012; 9:00 AM to 2:00 PM**

Name/Representing	Address	e-mail address	Phone/Fax #
MIKE NASH WALSH CONSTRUCTION	3011 West Grand Blvd. Detroit, MI 48202	mnash@walshgroup.com	313-873-6600
Jay Nault	25365 Interchange E Ct. Farmington Hills	jerome.nault@ otis.com	248-755-2623
Christine Pierson		Christine.pierson@ otis.com	248-807-8749
OTIS Elevator			
DARREK BOEHEMA F.H.C.	2830 Wyoming MI	DBSEHEMA@ FRANKLINHOLDING.COM	416-538-3231 616-538-2797
MIKE CARLYON E:P.L	2830 LIPENCOTT BLVD. FLINT, MI 48501	mikec@earthgroup.com	810-744-4300 810- 527 744-1735
OWENS CORNING ELECTRIC	MADISON HILLS	ckol170@Shawmut .com	810 248-556-7200
KEN PERKO BRENCAI.	26079 SCHOENHERR WARREN, MI 48087	BRENCAI@ COMCAST.NET	586-752 6000 6006



Stantec

**CITY OF ANN ARBOR WATER TREATMENT PLANT
 WEST HIGH SERVICE PUMP STATION
 ITB #4221
 SITE WALKTHROUGH ATTENDANCE
 THURSDAY, MAY 17, 2012; 9:00 AM to 2:00 PM**

Name/Representing	Address	e-mail address	Phone/Fax #
MATT MELLEN E&L CONSTRUCTION	FLINT, MI	mattmceandlgroup.com	517.744.4300
MIKE CARROLL ANDREW SMITH PPE	435 OVID MILFORD, MI	processpiping@comcast.net	248.684.5330 5526
Darrell Rush PPE	"	"	419-704-2481
Kevin Brickel Brenco Contractors	26079 Schoenherr Rd Warren, MI 48084	brenco@comcast.net	586-758-6000 586-758-6006
Ken Perks Brenco	"	"	"
STEVE LIEBLECK ROCKWELL AUTOMATION	"	"	"
DON TIMMER TIMMER CONSTR	"	"	"



Stantec

**CITY OF ANN ARBOR WATER TREATMENT PLANT
 WEST HIGH SERVICE PUMP STATION
 ITB #4221
 SITE WALKTHROUGH ATTENDANCE
 THURSDAY, MAY 17, 2012; 9:00 AM to 2:00 PM**

Name/Representing	Address	e-mail address	Phone/Fax #
Bel Hossain	7310 Woodward Ave. Detroit, MI 48202	belayet.hossain@lakeshoretoltest.com	p 313-304-2415
MIKE CLARKE	50850 Berkis	M. Clarke	p 734.481.1565
Lawrence M. Clarke	Belleville MI 48111	L.M. Clarke .COM	f 481.8795
Leonard Schneider	3200 JAMES SAVAGE RD Midland MI 48642	Leonard35construction@valtoo.com	p 989 496 2609
3-S const			f 989 496 0840
COLT ODEH	7310 WOODWARD AVE	COLT.ODEH@LAKESHORETOLTEST.COM	p 513) 887-5771
LAKESHORE TOLTEST COLL.	DETROIT, MI 48202		f
MIKE FORD	730 Woodward	Michael.Ford@lakeshoretoltest.com	p 313 215 1518
Lakeshore Toltest	Detroit, MI 48202		f
ERIC DOVAS	23894 Amber WARREN, MI	Edovas@ blue @bluestardemo.com	p 586-427-9933
BLUE STAR DEMITITION			f 427-9934
			p
			f

INSTRUMENT DATA SHEET

**MAGNETIC
FLOW METER**

Client: City of Ann Arbor
Location: West High Service Pump Station

Project No. 2075117301
Instrument Spec. 17324

Revision A

	Tag Number	FIT/FE 105	FIT/FE 151	
G E N	Service	EHPS <i>WHSPS DISCHARGE</i>	PLANT WATER	
	P&ID No.	I-603	N/A	
	Line/Equipment			
	Line Size Line Spec	24	6	
P R O C E S S	Fluid			
	Oper. Press Norm/Max (kPa)			
	Oper. Temp Norm/Max (°C)			
	Ambient Temperature (°C)			
	S.G. @ Oper. Temp.			
	Viscosity @ Oper. Temp.			
	Measurement Function			
T R A N S M I T T E R	Tag No.	FIT-105	FIT-151	
	Transmitter type	Remote	Remote	
	Power Requirement	120 Vac	120 Vac	
	Electrical Connection			
	Contact Type			
	Display Type	LCD	LCD	
	Instrument Range on Solid			
	Operating Range			
	Output Signal	4 - 20 mA	4 - 20 mA	
	Accuracy	±0.25 % of range	±0.25 % of range	
	Enclosure Rating	NEMA 4X	NEMA 4X	
	Enclosure Material			
Mounting	Wall Mount	Wall Mount		
E L E M E N T	Tag No.	FE-105	FE-151	
	Sensor Type	DC MAG	DC MAG	
	Operating range	100 - 15,000 GPM	50 - 2,000 GPM	
	Measurement Range			
	Lining Material	PFA	PFA	
	Electrode material	SS 316 Ti	SS 316 Ti	
	Tube Size	100 mm	100 mm	
	Enclosure Material			
Process Connection				
A C C E S S	Cable Length	As Required	As Required	
	Nameplate	Yes	Yes	
	Grounding Rings	SS 316 Ti	SS 316 Ti	
	Mounting Straps			
Approval / Enclosure	CSA	NEMA 4X	CSA	NEMA 4X
Class / Division / Group	General		General	
Manufacturer	ABB		ABB	
Model Number	Magmaster Loflo		Magmaster Loflo	
Alternates	E&H Promag 50W		E&H Promag 50W	

NOTES:

1. Vendor is to supply Stainless Steel Tag with Instrument Tags Number clearly Stamped on it.
2. Vendor is to fill missing data in this specification sheet relevant to the device (i.e. model #).
3. Minimum straight pipe required: 5 dia. upstream of flowmeter and 3 dia. Downstream
4. Contractor is to supply mounting hardware appropriate for the application

No	Date	By	Chkd	Appd	Revision



INSTRUMENT DATA SHEET

PRESSURE TRANSMITTER


Client: City of Ann Arbor


Project No. 2075117301

Location: West High Service Pump Station

Instrument Spec. 17322

Revision A

	Tag Number	PIT/PE 101A	PIT/PE 101B	PIT/PE 105		
G E N	Service	INFLUENT HEADER		EFFLUENT HEADER		
	P&ID No.	I-601	I-604	I-603		
	Line/Equipment					
	Line Size(mm) Line Spec					
P R O C E S S	Fluid	POTABLE WATER		POTABLE WATER		
	Oper. Press Norm/Max (PSI)	0 100	0 100	0 100		
	Oper. Temp Norm/Max (°F)	40 90	40 90	40 90		
	Ambient Temperature	32.0 110	32.0 110	32.0 110		
	S.G. @ Oper. Temp.	N/A	N/A	N/A		
	Viscosity @ Oper. Temp.	N/A	N/A	N/A		
T R A N S M I T T E R	Measurement Function	Pressure	Pressure	Pressure		
	Tag No.	PIT-101A	PIT-101B	PIT-105		
	Transmitter type	Loop Powered	Loop Powered	Loop Powered		
	Power Requirement	24VDC	24VDC	24VDC		
	Electrical Connection					
	Contact Type					
	Display Type	Digital LCD integral display	Digital LCD integral display	Digital LCD integral display		
	Instrument Range on Solid					
	Operating Range	0 - 300 PSI	0 - 300 PSI	0 - 300 PSI		
	Output Signal	4 - 20 mA c/w Hart	4 - 20 mA c/w Hart	4 - 20 mA c/w Hart		
	Accuracy	±0.075%	±0.075%	±0.075%		
	Enclosure Rating	NEMA 4X	NEMA 4X	NEMA 4X		
Enclosure Material	Aluminum Alloy	Aluminum Alloy	Aluminum Alloy			
Mounting						
E L E M E N T	Element Type	Integral Sensor	Integral Sensor	Integral Sensor		
	Material of Element	SS	SS	SS		
	Enclosure Material	AISI 316L SS	AISI 316L SS	AISI 316L SS		
	Measurement Range	0 - 300 PSI	0 - 300 PSI	0 - 300 PSI		
	Process Range	0 - 300 PSI	0 - 300 PSI	0 - 300 PSI		
	Process Connection	1/2 - 14 NPT male	1/2 - 14 NPT male	1/2 - 14 NPT male		
A C C E S S	Nameplate	Yes	Yes	Yes		
	Connection Plug	Yes	Yes	Yes		
	Mounting Bracket	Yes	Yes	Yes		
	Isolation Valve and/or Manifold	Isolation Valve	Isolation Valve	Isolation Valve		
Approval / Enclosure	CSA	NEMA 4X	CSA	NEMA 4X	CSA	NEMA 4X
Class / Division / Group	General		General		General	
Manufacturer	ABB		ABB		ABB	
Model Number	E&H		E&H		E&H	
Alternates						
NOTES:						
1. Vendor is to supply Stainless Steel Tag with Instrument Tags Number clearly Stamped on it.						
2. Vendor is to fill missing data in this specification sheet relevant to the device (i.e. model #).						
3. Contractor is to supply mounting hardware appropriate for the application.						
No	Date	By	Chkd	Appd	Revision	
						

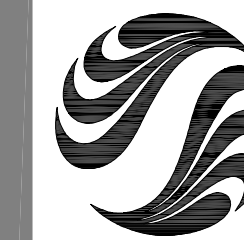

Stantec Consulting Michigan Inc.
 3754 Ranchero Drive
 Ann Arbor, MI U.S.A.
 48108
 Tel. 734.761.1010
 Fax. 734.761.1200
 www.stantec.com

Stantec


Copyright Reserved

The Contractor shall verify and be responsible for all dimensions. DO NOT scale the drawing - any errors or omissions shall be reported to Stantec without delay.
 The Copyrights to all designs and drawings are the property of Stantec. Reproduction or use for any purpose other than that authorized by Stantec is forbidden.

Consultants

Legend

Notes

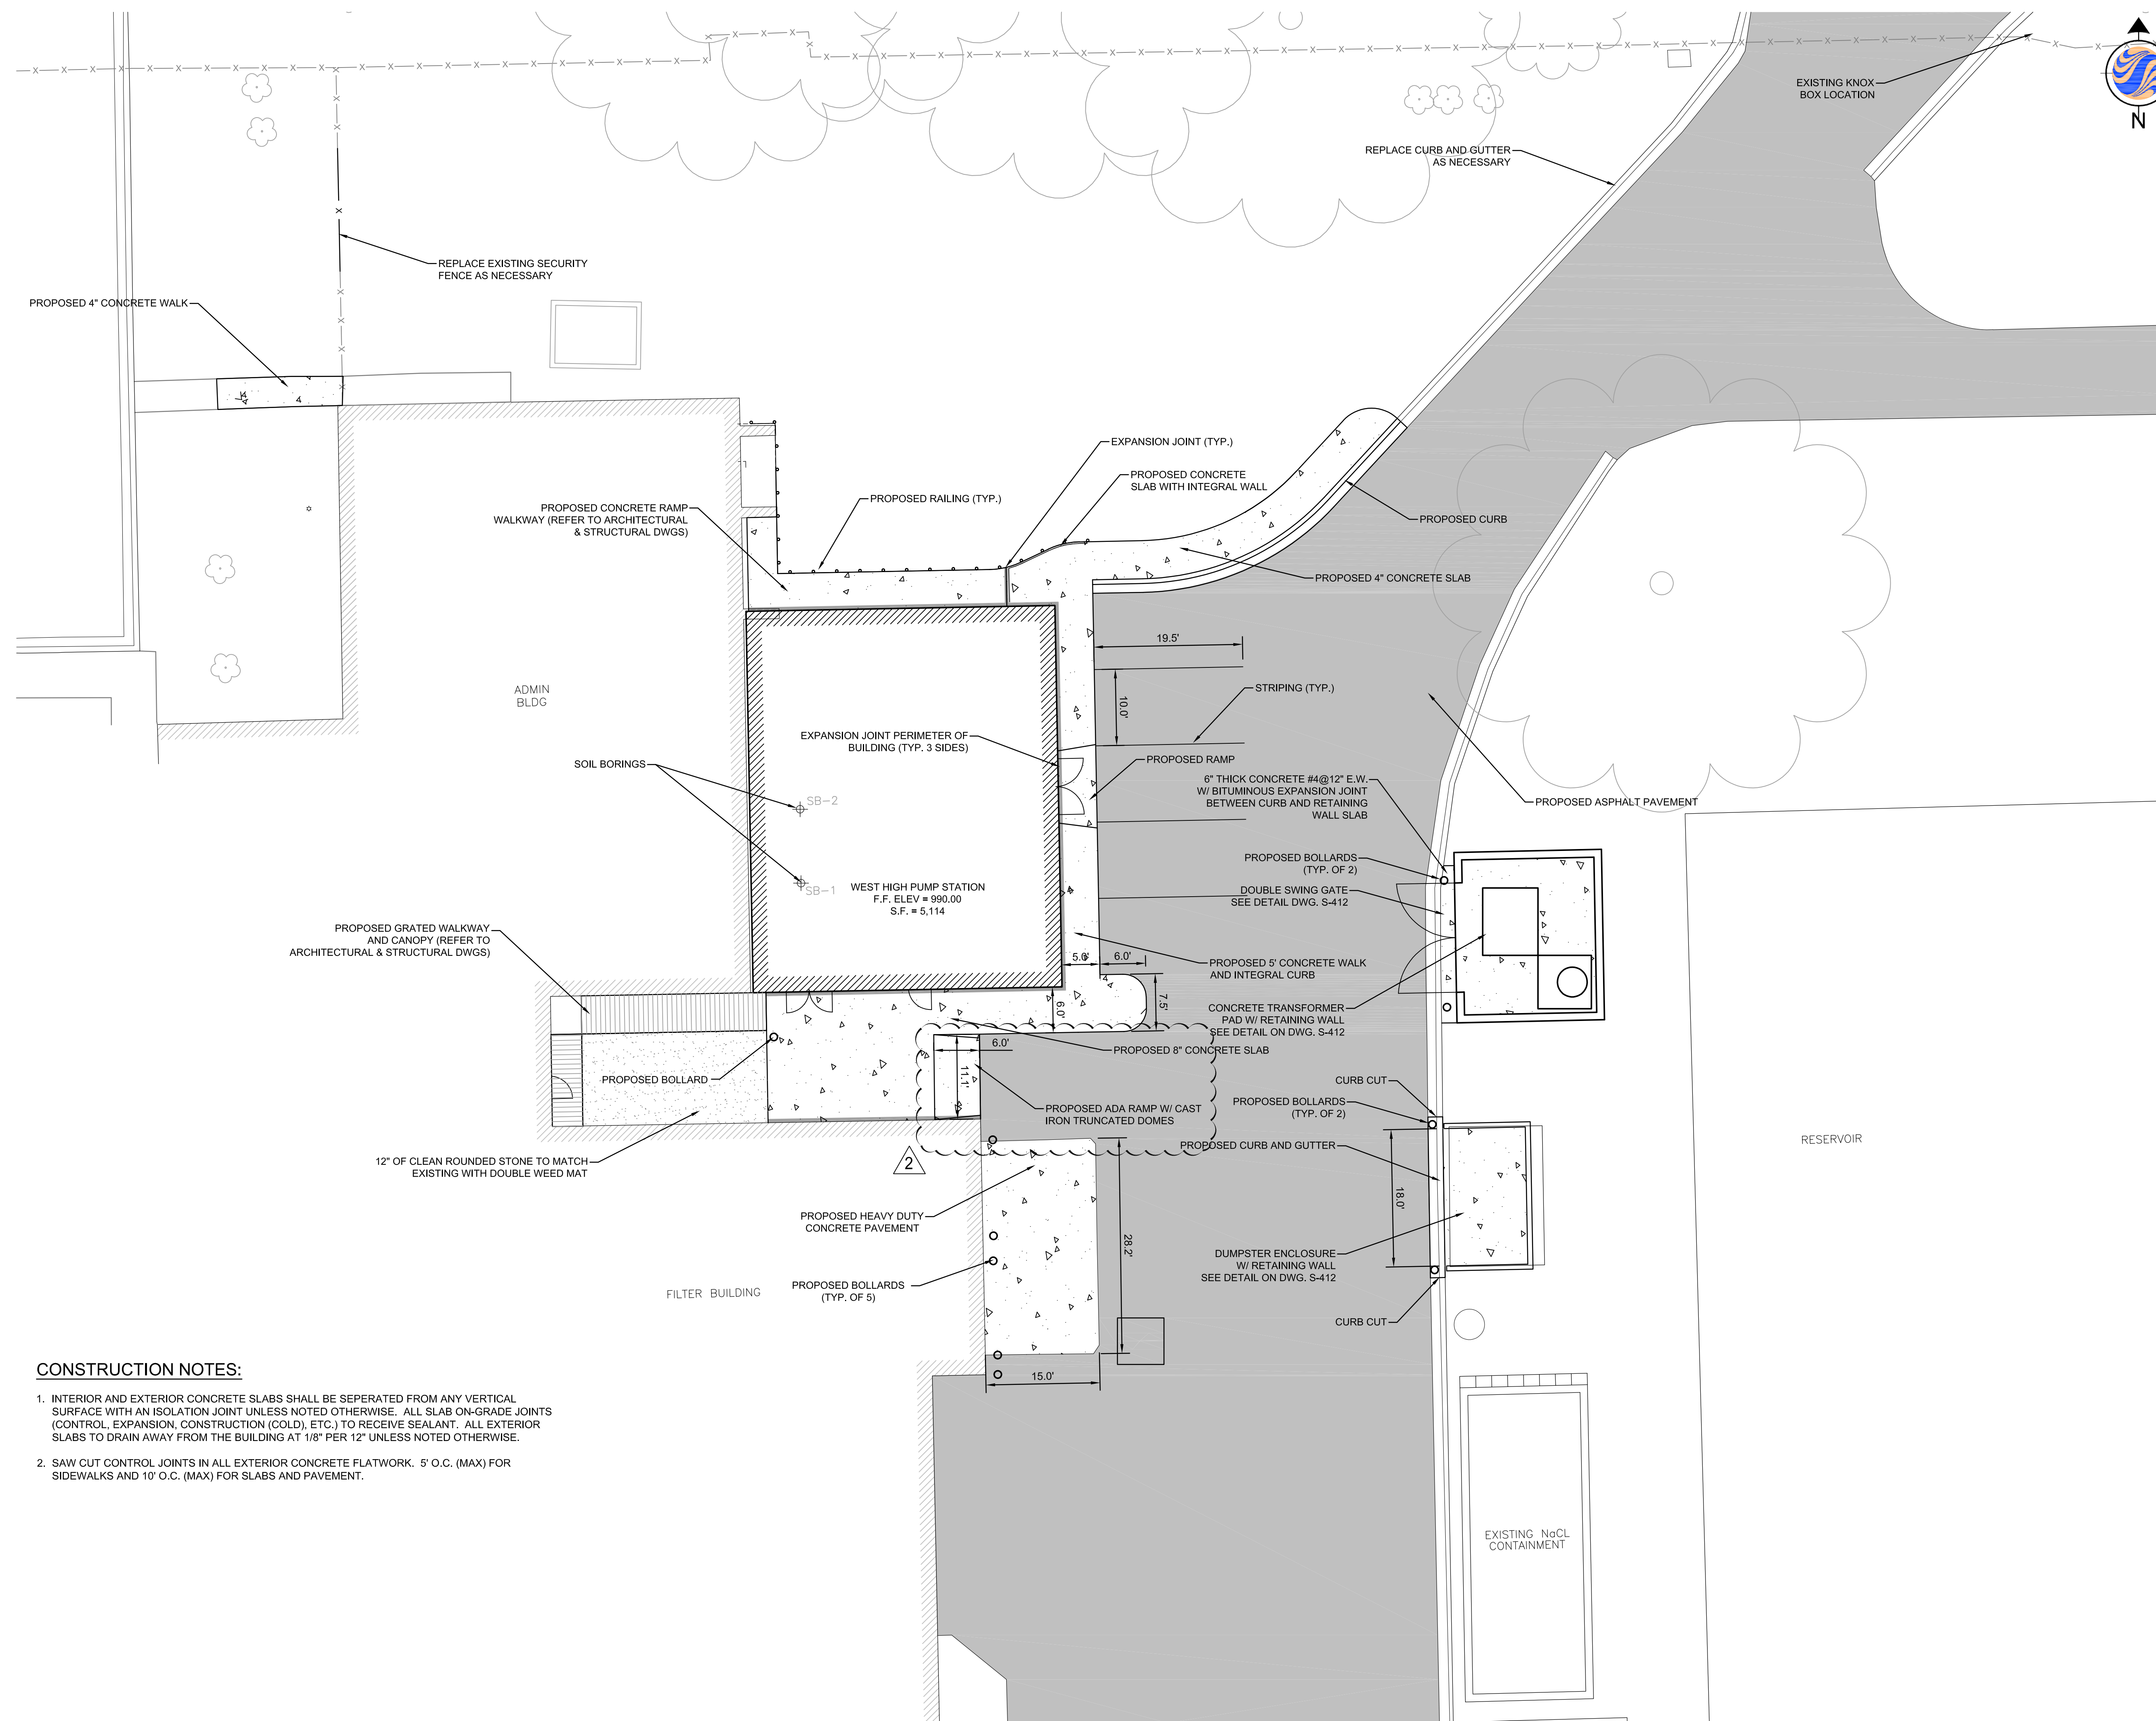

CONSTRUCTION NOTES:

1. INTERIOR AND EXTERIOR CONCRETE SLABS SHALL BE SEPERATED FROM ANY VERTICAL SURFACE WITH AN ISOLATION JOINT UNLESS NOTED OTHERWISE. ALL SLAB ON-GRADE JOINTS (CONTROL, EXPANSION, CONSTRUCTION (COLD), ETC.) TO RECEIVE SEALANT. ALL EXTERIOR SLABS TO DRAIN AWAY FROM THE BUILDING AT 1/8" PER 12" UNLESS NOTED OTHERWISE.
2. SAW CUT CONTROL JOINTS IN ALL EXTERIOR CONCRETE FLATWORK. 5' O.C. (MAX) FOR SIDEWALKS AND 10' O.C. (MAX) FOR SLABS AND PAVEMENT.

Revision	By	Appd.	YY.MM.DD
F ADDENDUM NO. 2	GRW	GRW	12.05.18
E BID SET	GRW	GRW	12.05.01
D MDEQ DRAFT SUBMITTAL	GRW	GRW	12.03.14
C PLANNING COMMISSION SUBMITTAL	GRW	GRW	12.01.27
B 90% REVIEW	GRW	GRW	12.01.13
A 30% REVIEW	GRW	GRW	11.12.15
Issued	By	Appd.	YY.MM.DD

File Name: 17301-C-104.DWG 11.12.15

Permit-Seal

Client/Project

CITY OF ANN ARBOR


WEST HIGH SERVICE PUMP STATION

Ann Arbor, Michigan

Title

CIVIL SITE PLAN

Project No.
2075117301

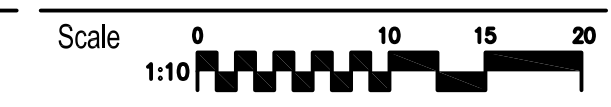

Drawing No.


Sheet

Revision

C-104

08 of 144

0

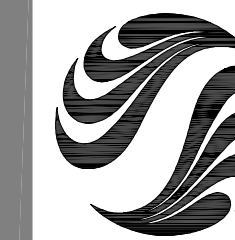


Copyright Reserved

The Contractor shall verify and be responsible for all dimensions. DO NOT scale the drawing - any errors or omissions shall be reported to Stantec without delay.
 The Copyrights to all designs and drawings are the property of Stantec. Reproduction or use for any purpose other than that authorized by Stantec is forbidden.

Consultants

Legend

Notes

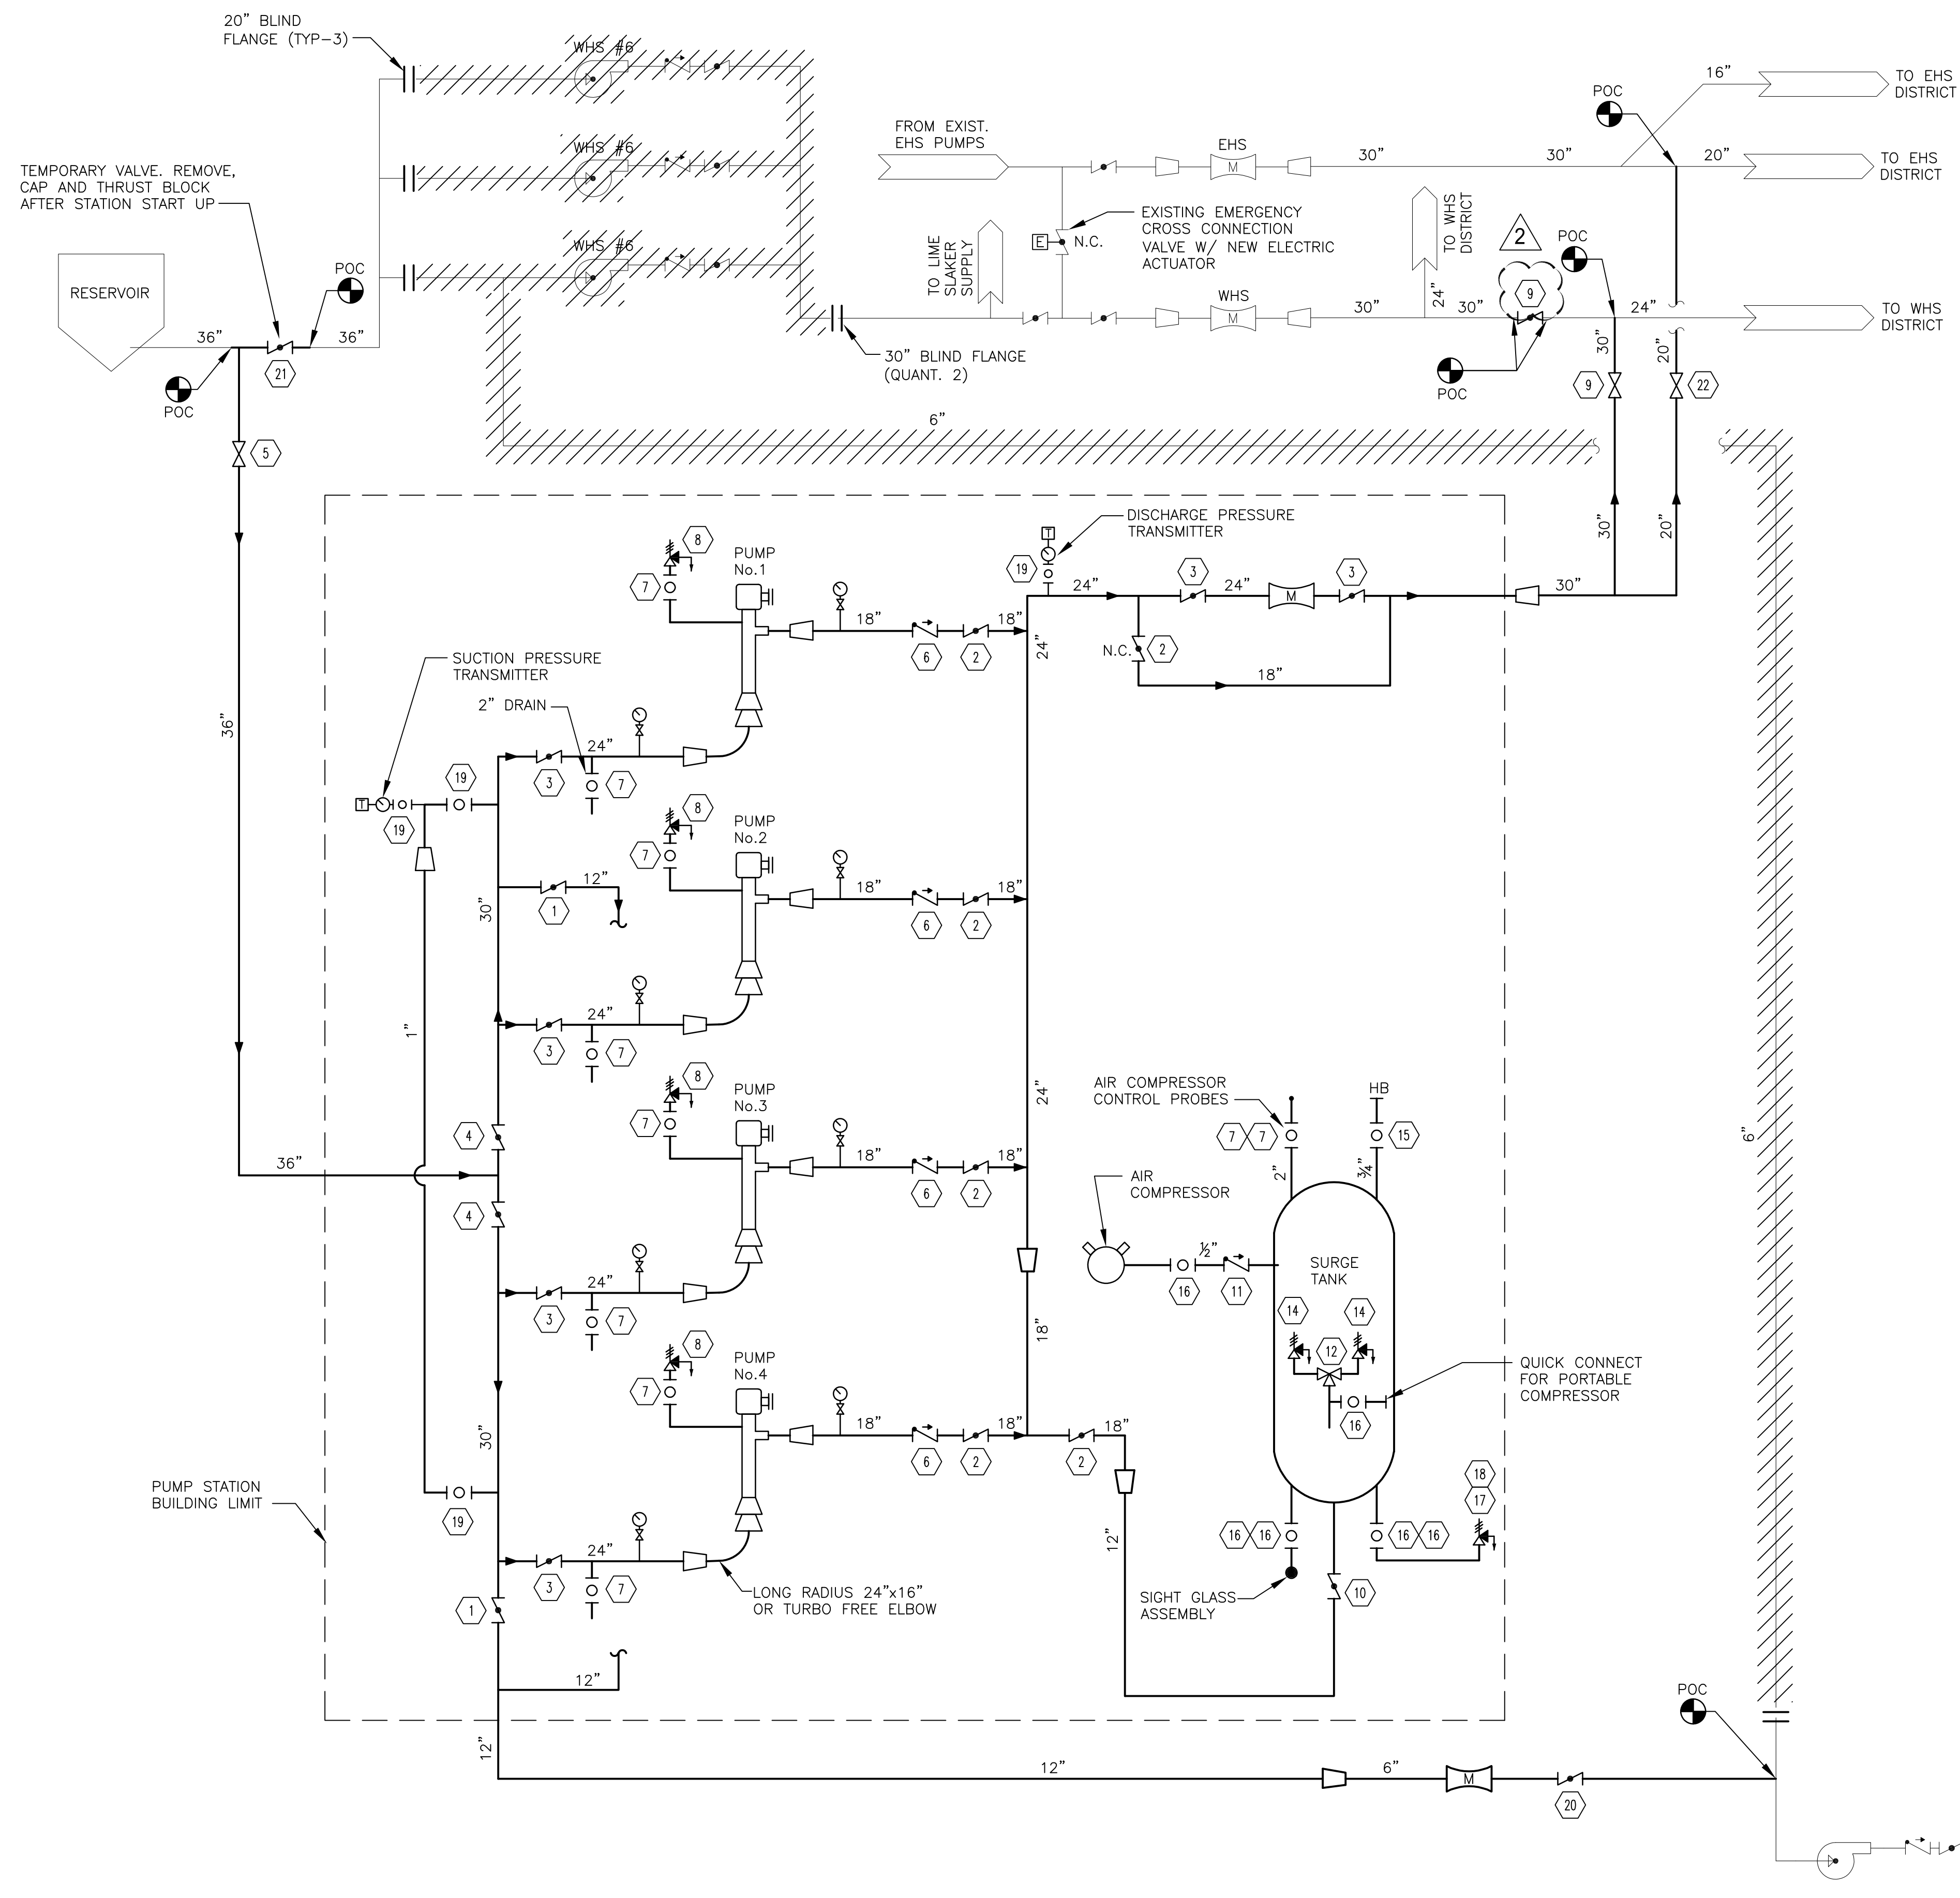

VALVE SCHEDULE						
MARK	VALVE I.D.	TYPE	SIZE	JOINT	RATING (PSI)	OPERATOR
1		BUTTERFLY VALVE	12"	FLANGE	150	GEAR W/ HANDWHEEL
2		BUTTERFLY VALVE	18"	FLANGE	150	GEAR W/ HANDWHEEL, NOTE 3
3		BUTTERFLY VALVE	24"	FLANGE	150	GEAR W/ HANDWHEEL
4		BUTTERFLY VALVE	30"	FLANGE	150	GEAR W/ HANDWHEEL
5		RESILIENT WEDGE GATE VALVE	36"	M.J.	150	GEAR W/ 2" OPERATING NUT
6		CHECK VALVE	18"	FLANGE	150	CUSHIONED
7		BALL VALVE (SS)	2"	THREADED	150	LEVER
8		AIR/VACUUM VALVE	2"	THREADED	150	-
9		RESILIENT WEDGE GATE VALVE	30"	M.J.	150	GEAR W/ 2" OPERATING NUT
10		BUTTERFLY VALVE	12"	FLANGE	150	GEAR W/ HANDWHEEL
11		CHECK VALVE (SS)	½"	THREADED	250	-
12		3-WAY BALL VALVE (SS)	1"	THREADED	250	LEVER
13		BUTTERFLY VALVE	4"	FLANGE	150	LEVER
14		POPPET AIR RELIEF VALVE (SS)	1"	THREADED	250	-
15		BALL VALVE (SS)	¾"	THREADED	250	LEVER
16		BALL VALVE (SS)	½"	THREADED	250	LEVER
17		AIR RELIEF VALVE	¾"	THREADED	250	-
18		PRESSURE RELIEF VALVE	½"	THREADED	250	-
19		BALL VALVE (SS)	NOTE 2	THREADED	250	LEVER
20		BUTTERFLY VALVE	6"	FLANGE	150	GEAR W/ HANDWHEEL
21		BUTTERFLY VALVE	36"	M.J.	150	GEAR W/ 2" OPERATING NUT
22		RESILIENT WEDGE GATE VALVE	20"	M.J.	150	GEAR W/ 2" OPERATING NUT

NOTES:
 1. NOT ALL YARD PIPING SHOWN.
 2. COORDINATE VALVE & REDUCER SIZE WITH PRESSURE TRANSMITTERS.
 3. PROVIDE WITH CHAIN FALL FOR VALVES 6' AND GREATER ABOVE FLOOR.

1 PROCESS FLOW DIAGRAM
 P-102 N.T.S.

Revision	By	Appd.	YY.MM.DD
F ADDENDUM NO. 2	GRW	GRW	12.05.18
E BID SET	GRW	GRW	12.05.01
D MDEQ DRAFT SUBMITTAL	GRW	GRW	12.03.14
C PLANNING COMMISSION SUBMITTAL	GRW	GRW	12.01.27
B 90% REVIEW	GRW	GRW	12.01.13
A 30% REVIEW	GRW	GRW	11.12.15

Issued By Appd. YY.MM.DD


File Name: 17301-P-102.DWG
 11.12.15

Permit-Seal

Client/Project
 CITY OF ANN ARBOR
 WEST HIGH SERVICE PUMP STATION
 Ann Arbor, Michigan

Title
 PROCESS FLOW DIAGRAM

Project No. 2075117301
 Drawing No. Sheet Revision
 Scale AS NOTED

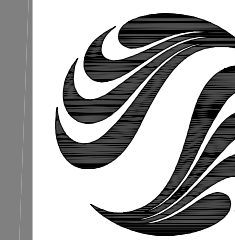

Copyright Reserved
The Contractor shall verify and be responsible for all dimensions. DO NOT scale the drawing - any errors or omissions shall be reported to Stantec without delay.
The Copyrights to all designs and drawings are the property of Stantec. Reproduction or use for any purpose other than that authorized by Stantec is forbidden.

Consultants

Legend

Notes

Revision	By	Appd.	YY.MM.DD
F ADDENDUM NO. 2	GRW	GRW	12.05.18
E BID SET	GRW	GRW	12.05.01
D MDEQ DRAFT SUBMITTAL	GRW	GRW	12.03.14
C PLANNING COMMISSION SUBMITTAL	GRW	GRW	12.01.27
B 90% REVIEW	GRW	GRW	12.01.13
A 30% REVIEW	GRW	GRW	11.12.15
Issued	By	Appd.	YY.MM.DD


File Name: 17301-P-107.DWG
Date: 11.12.15

Permit-Seal


Client/Project
CITY OF ANN ARBOR
WEST HIGH SERVICE PUMP STATION
Ann Arbor, Michigan

Title
PROCESS SURGE TANK DETAILS


Project No.	Scale	
2075117301	AS NOTED	
Drawing No.	Sheet	Revision

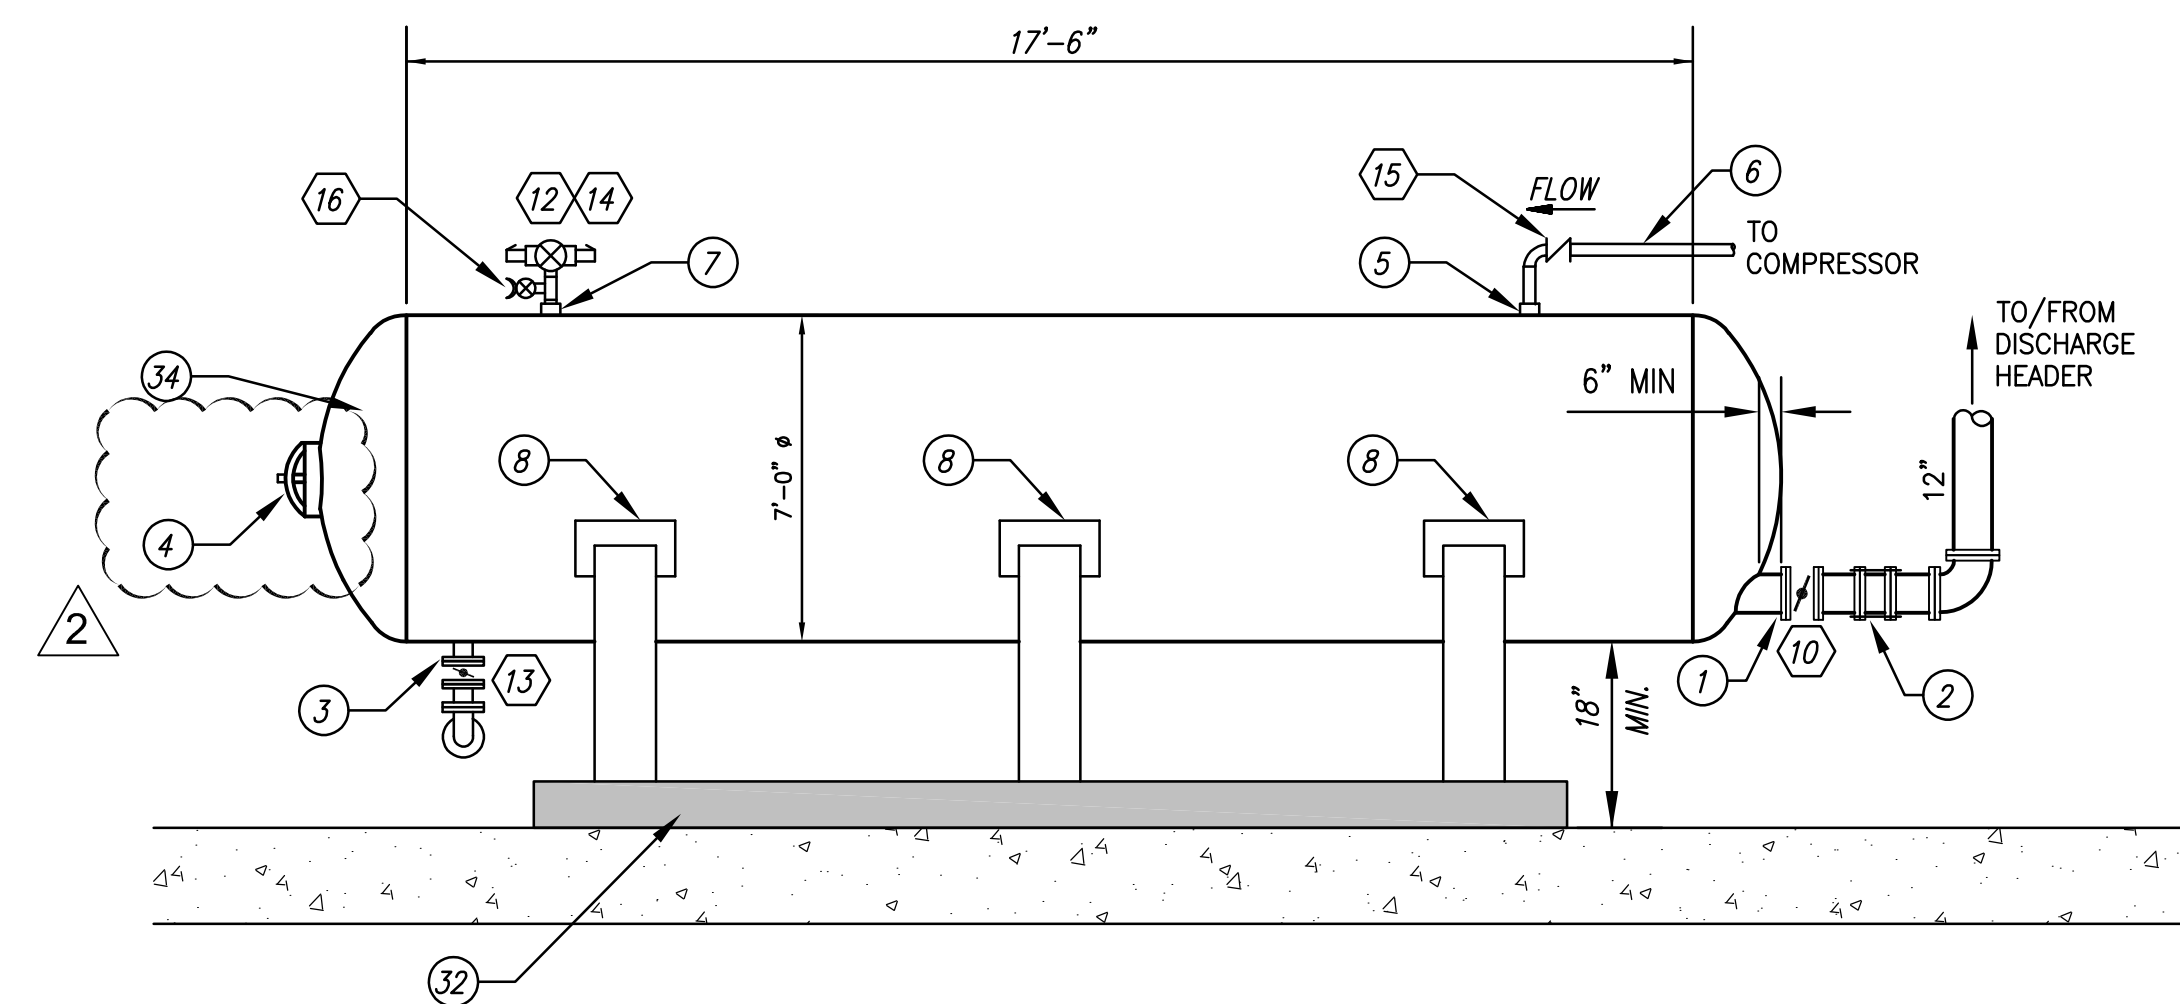

SURGE TANK DETAIL
N.T.S.

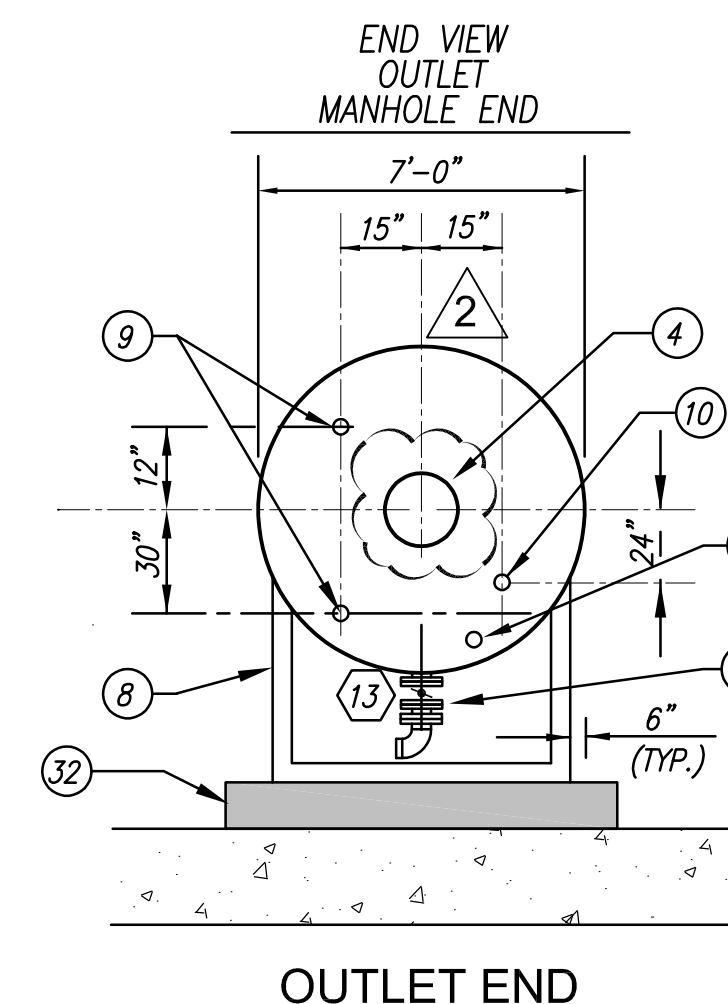

OUTLET END

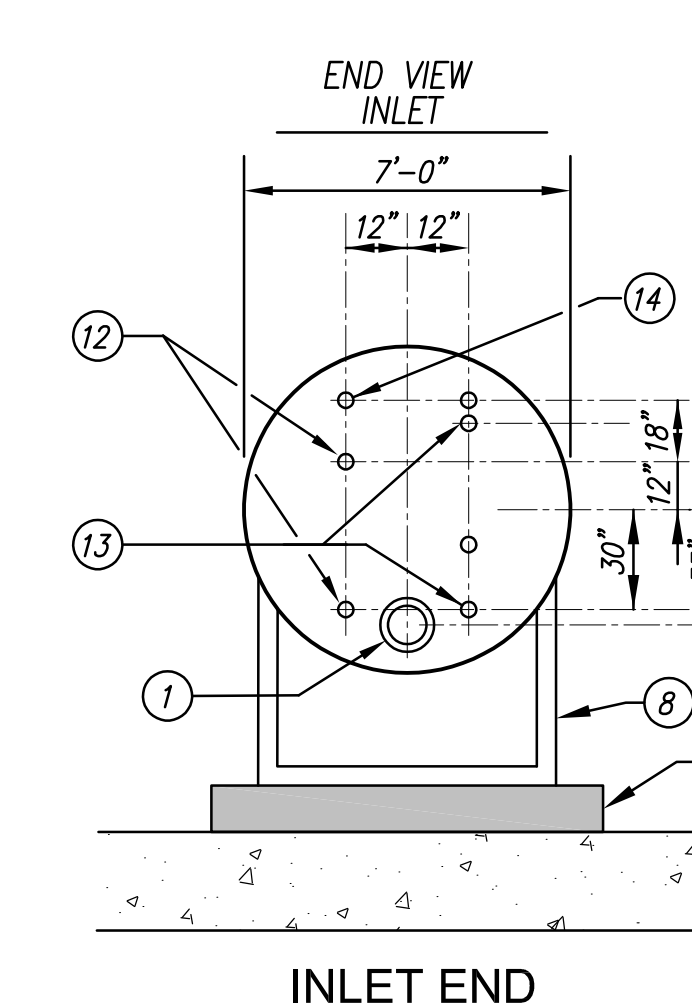


INLET END

NOTE:
ALL PRESSURE TANK FITTINGS AND VALVES SHALL BE RATED FOR 150 PSI WORKING PRESSURE, MINIMUM. ALL HALF COUPLINGS SHALL BE EXTRA HEAVY SERIES, 3,000# RATED.


SURGE TANK END ELEVATION DETAILS
N.T.S.

SHEET NOTES





- 1 12" FLANGED INLET WITH ISOLATION BUTTERFLY VALVE - PROVIDE 6" MINIMUM CLEARANCE BETWEEN FLANGE AND HEAD.
- 2 12" DISMANTLING JOINT WITH TIE RODS.
- 3 4" FLANGED DRAIN OUTLET WITH ISOLATION BUTTERFLY VALVE, 90 DEG. ELBOW REDUCER AND QUICK CONNECT FITTING TO A FIRE HOSE CONNECTION.
- 4 24" DIA. A.S.M.E. MANHOLE.
- 5 3/4" EXTRA HEAVY HALF COUPLING FOR AIR COMPRESSOR LINE.
- 6 3/4" 10S STAINLESS STEEL AIR LINE.
- 7 1" EXTRA HEAVY HALF COUPLING FOR SAFETY AIR RELIEF - SEE DETAIL 1 THIS SHEET.
- 8 STEEL TANK SUPPORTS (TYPICAL OF 3) - SEE STRUCTURAL DRAWINGS FOR TANK ANCHORING DETAILS.
- 9 2" EXTRA HEAVY HALF COUPLINGS (2) FOR AIR COMPRESSOR CONTROL PROBES - SEE DETAIL 5 THIS SHEET.
- 10 2" EXTRA HEAVY HALF COUPLING W/ PLUG.
- 11 3/4" EXTRA HEAVY HALF COUPLING FOR HOSE BIB - SEE DETAIL 2 THIS SHEET.
- 12 1/2" EXTRA HEAVY HALF COUPLINGS (2) FOR SIGHT GLASS ASSEMBLY - SEE DETAIL 3 THIS SHEET.
- 13 3/4" EXTRA HEAVY HALF COUPLINGS (2) FOR AIR RELEASE VALVE ASSEMBLY - SEE DETAIL 4 THIS SHEET.
- 14 1" EXTRA HEAVY HALF COUPLING WITH PLUG.
- 15 STAINLESS STEEL POPPET SAFETY AIR RELIEF VALVES (2) SET AT 120 PSI.
- 16 1" STAINLESS STEEL 3-WAY BALL VALVE FOR SAFETY AIR VALVE ISOLATION.
- 17 3/4" STAINLESS STEEL BALL VALVE FOR HOSE BIB ISOLATION.
- 18 3/4" STAINLESS STEEL HOSE BIB W/ VACUUM BREAKER.
- 19 1/2" STAINLESS STEEL BALL VALVES (2) FOR SIGHT GLASS ISOLATION.
- 20 STAINLESS STEEL SIGHT GLASS ASSEMBLY WITH GLASS PROTECTOR AND INTEGRAL DRAIN VALVE.
- 21 0-200 PSI PRESSURE GAUGE.
- 22 3/4" STAINLESS STEEL BALL VALVES (2) FOR AIR RELIEF VALVE ISOLATION.
- 23 3/4" AIR RELEASE VALVE (APCO 55).
- 24 PRESSURE RELIEF VALVE (APCO 54).
- 25 1/2" BALL VALVE AND QUICK CONNECT FITTING FOR PORTABLE AIR COMPRESSOR.
- 26 2" BALL VALVES(2) FOR CONTROL PROBE ISOLATION.
- 27 WARRICK SERIES 3E3A ELECTRODE FITTING.
- 28 2" SCHEDULE 40 STAINLESS STEEL PIPE.
- 29 2 PVC COATED ELECTRODES FOR COMPRESSOR ON & OFF.
- 30 STAINLESS STEEL PLUG.
- 31 BASE MOUNTED AIR COMPRESSOR.
- 32 HOUSEKEEPING PAD.
- 33 4" x 3/4" ANCHOR BOLT (TYP. OF 4) FOR ATTACHING COMPRESSOR.
- 34 ENTIRE SURGE TANK SHALL BE INSULATED AND PVC JACKET AFTER PAINTING.
- 35 PIPE AIR RELEASE DISCHARGE TO FLOOR DRAIN.
- 36 SOUND ATTENUATING ENCLOSURE. HINGES FOR ACCESS. COORDINATE VENTING DETAILS WITH THE MECHANICAL DRAWINGS.

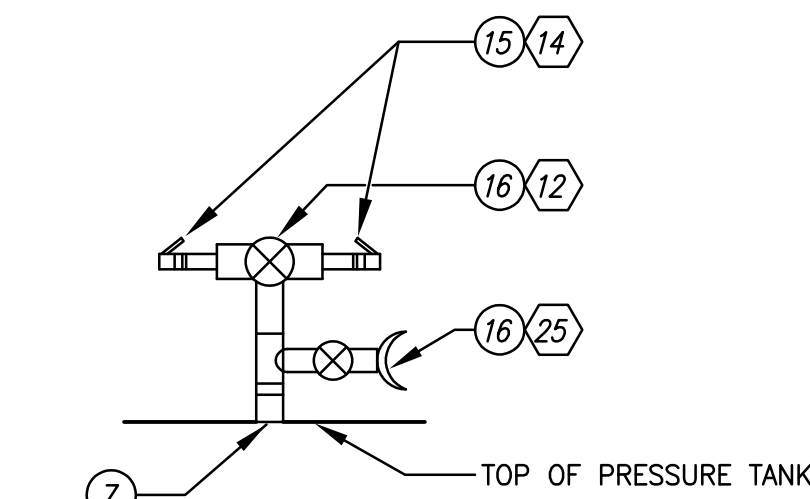



NOTE:
1. ENTIRE ASSEMBLY TO BE 316 STAINLESS STEEL.

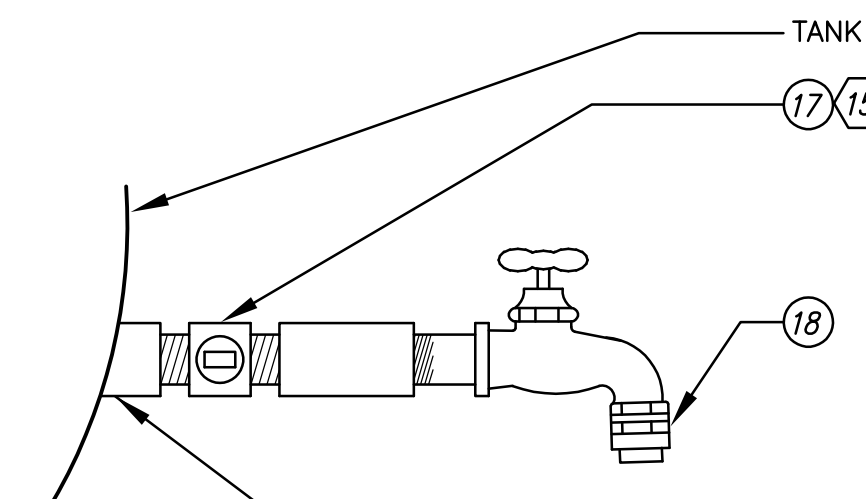

NOTE:
1. ENTIRE ASSEMBLY TO BE 316 STAINLESS STEEL.

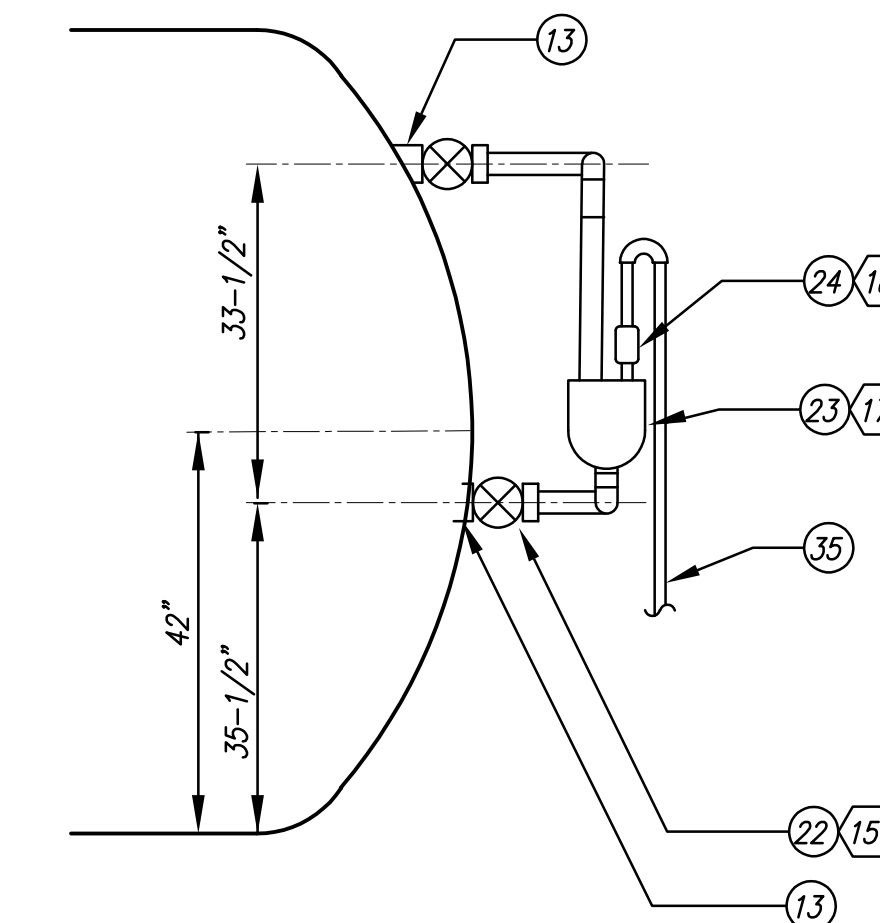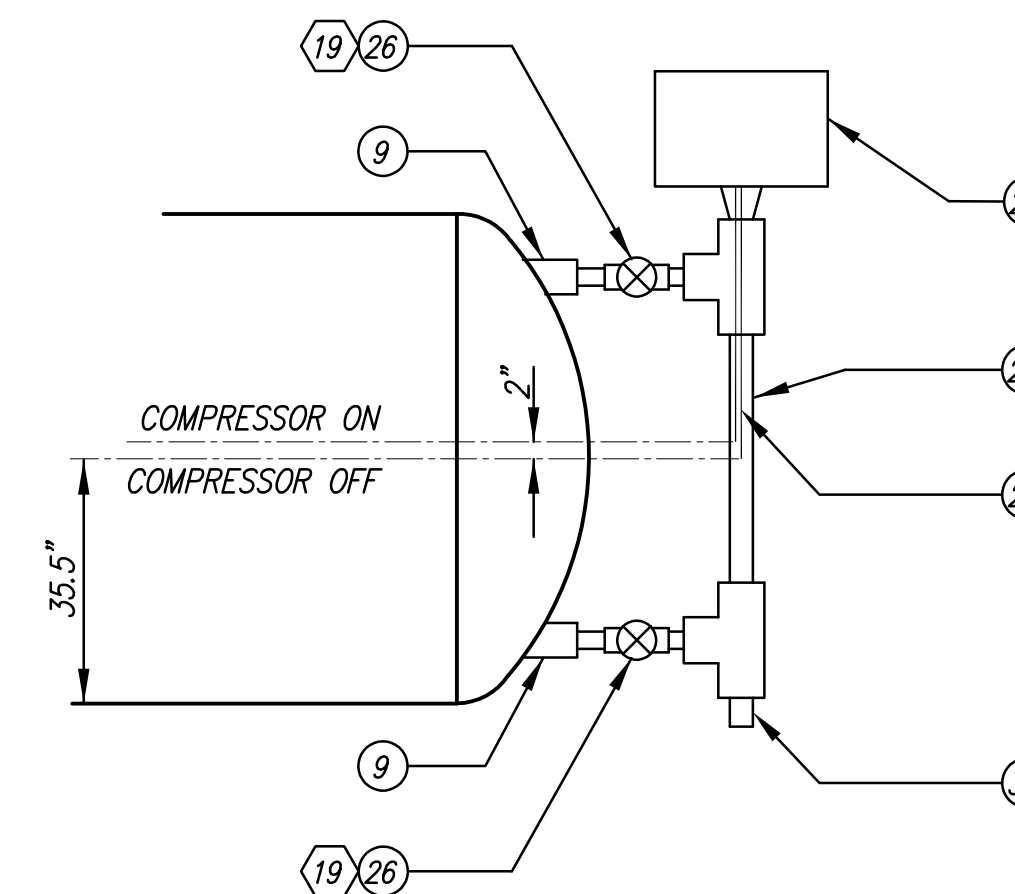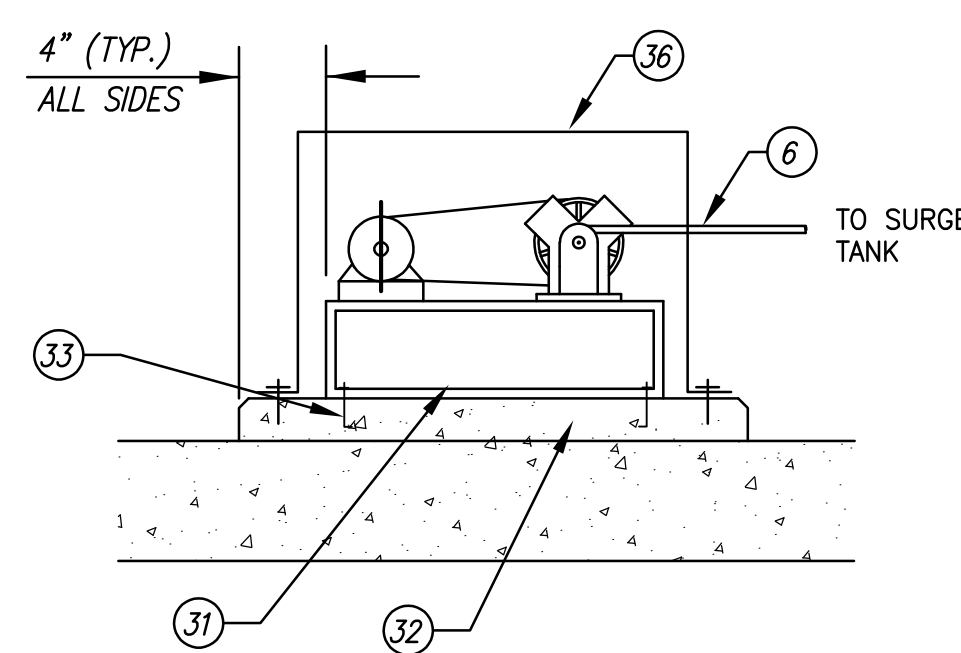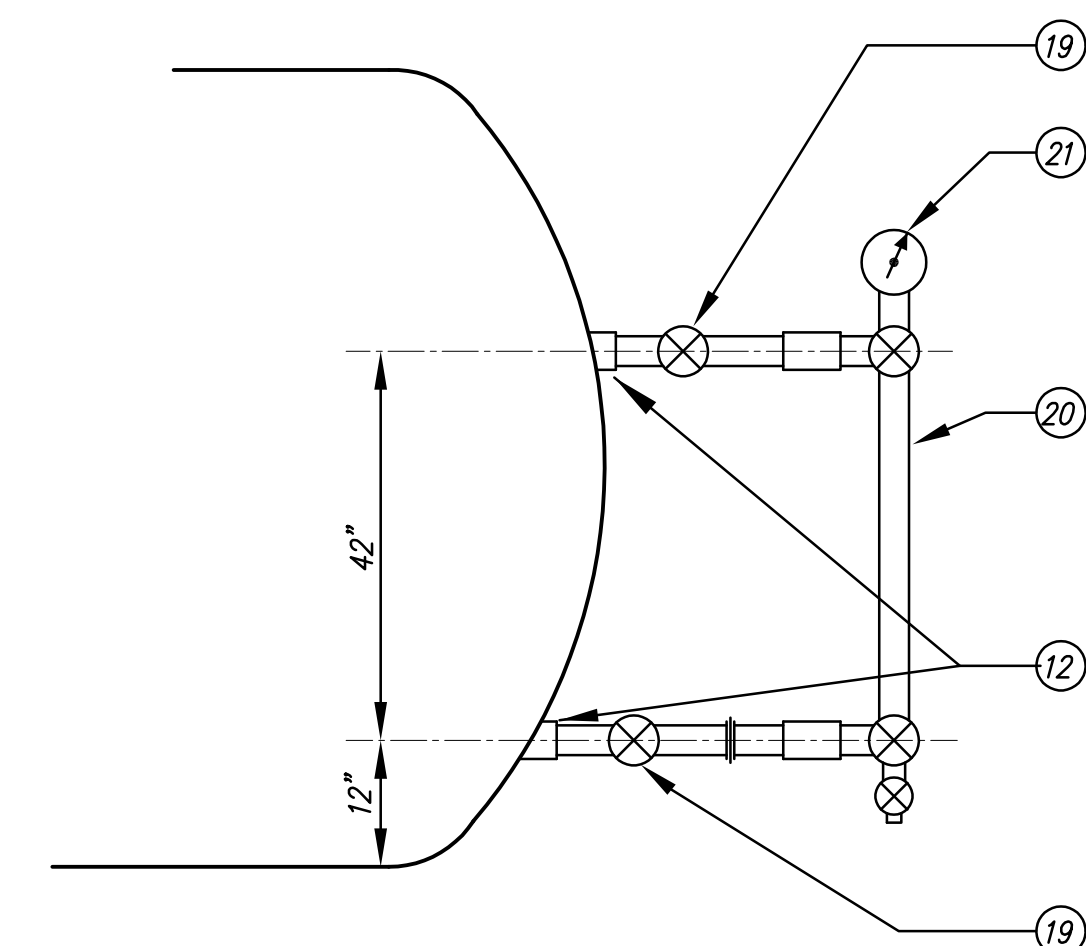

NOTE:
1. SECURE DISCHARGE PIPE AS NECESSARY WITH SS UNISTRUT.

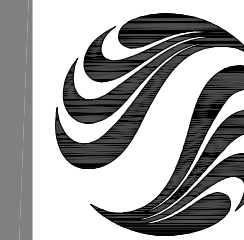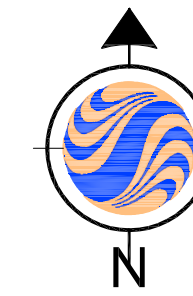

Stantec Consulting Michigan Inc.
 3754 Ranchero Drive
 Ann Arbor, MI U.S.A.
 48108
 Tel. 734.761.1010
 Fax. 734.761.1200
 www.stantec.com

Stantec

Copyright Reserved
 The Contractor shall verify and be responsible for all dimensions. DO NOT scale the drawing - any errors or omissions shall be reported to Stantec without delay.
 The Copyrights to all designs and drawings are the property of Stantec. Reproduction or use for any purpose other than that authorized by Stantec is forbidden.

Consultants

Legend

- SEE SHEET E-101.

Notes

- ALL WORK SHALL COMPLY WITH PROJECT SPECIFICATIONS.
- CONTRACTOR TO REFEED EXISTING LP-E LOADS. APPROXIMATELY 24 LOADS TO BE TRACED AND RECONNECTED TO THE NEW PANELBOARD.
- ALL CONDUITS TO BE ROUTED OVER THE TOP OF THE MONORAIL.
- ALL SUPPORTS/HANGERS SHALL BE THREADED ROD/UNISTRUT STAINLESS STEEL AND EPOXY ANCHORED TO CONCRETE CEILING.

Revision	By	Appd.	YY.MM.DD
F ADDENDUM NO. 2	GRW	GRW	12.05.18
E BID SET	GRW	GRW	12.05.01
D MDEQ DRAFT SUBMITTAL	GRW	GRW	12.03.14
C PLANNING COMMISSION SUBMITTAL	GRW	GRW	12.01.27
B 90% REVIEW	GRW	GRW	12.01.13
A 30% REVIEW	GRW	GRW	11.12.15

Issued By Appd. YY.MM.DD

File Name: 17301E-120.DWG 11.12.15

Permit-Seal

Client/Project
 CITY OF ANN ARBOR


WEST HIGH SERVICE
 PUMP STATION
 Ann Arbor, Michigan

Title
 ELECTRICAL
 POWER PLAN
 PUMP ROOM #2

Project No. 2075117301 Scale 1/4"=1'-0"


Drawing No. Sheet Revision

E-120 73 of 144 0

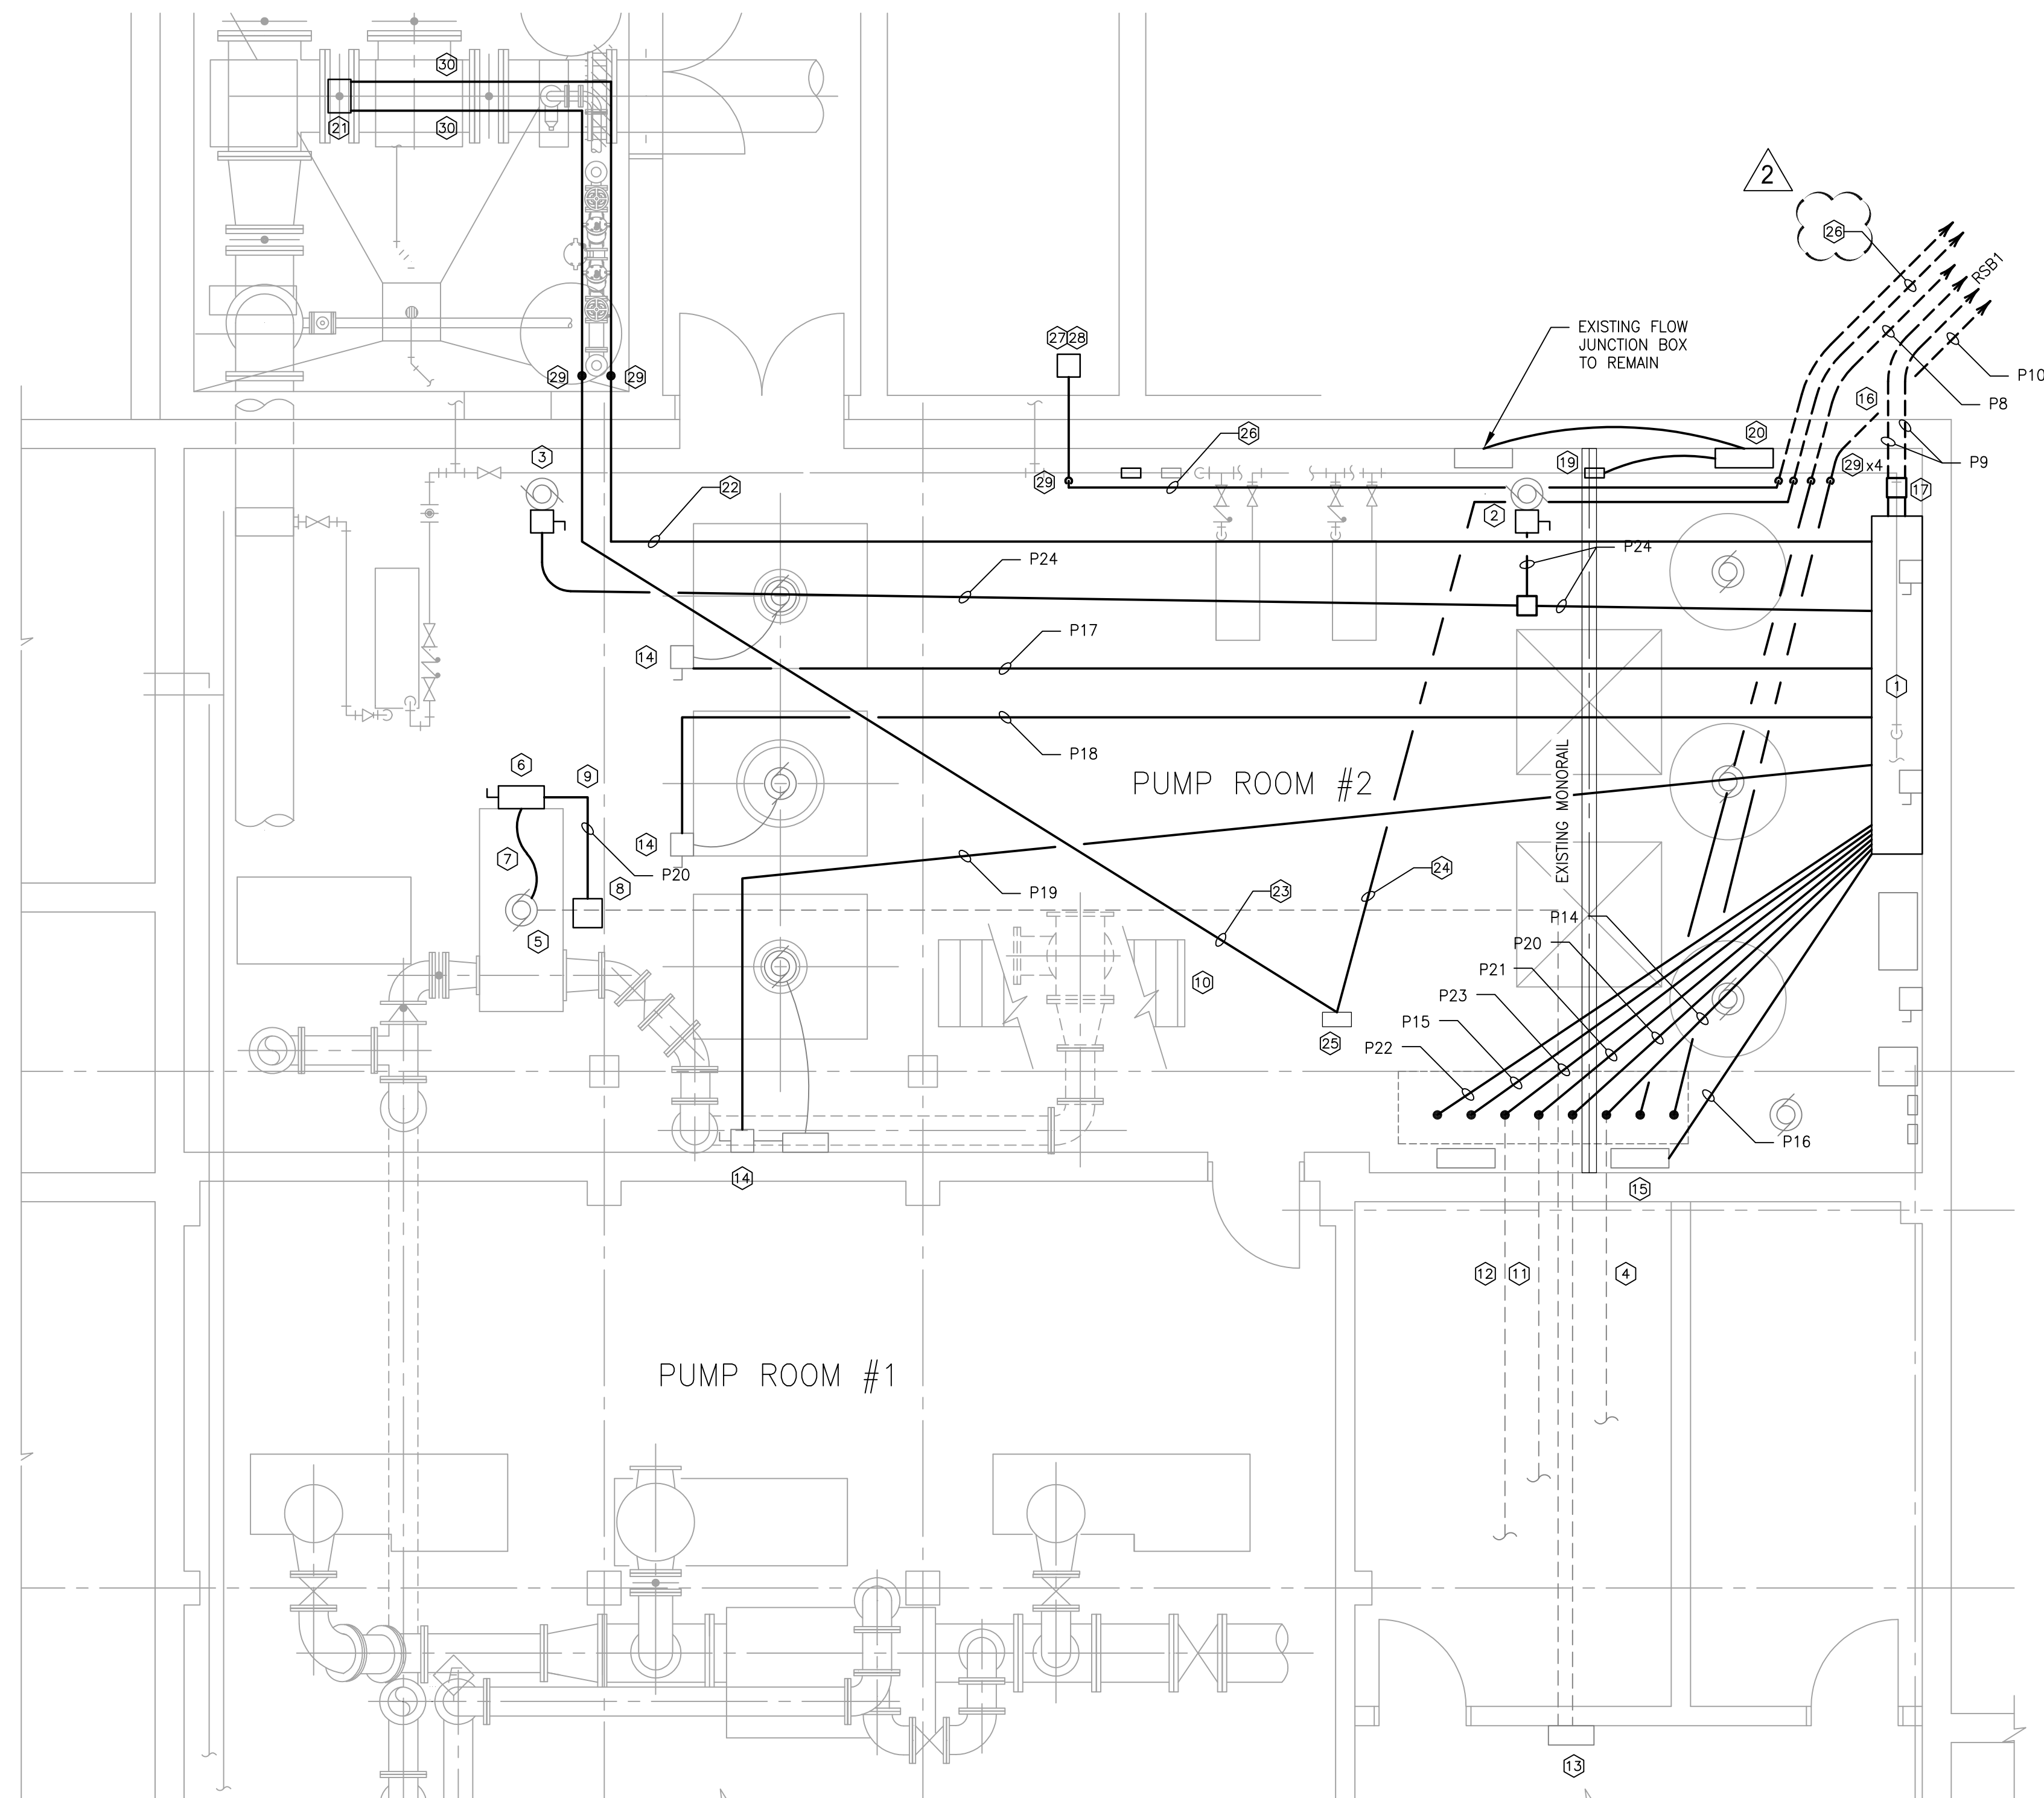



KEY NOTES

- PROVIDE NEMA 3R MOTOR CONTROL CENTER, RED MCC1.
- EXISTING EF-5, PROVIDE NEMA 3R, 2HP COMBINATION STARTER.
- EXISTING EF-6, PROVIDE NEMA 3R, 2HP COMBINATION STARTER.
- EXISTING CONDUIT TO PP-1A/1B. PROVIDE PULL BOX AND EXTEND FEEDER TO RED MCC1, AS REQUIRED.
- EXISTING WASH WATER PUMP #2.
- PROVIDE 400A NON-FUSED DISCONNECT, NEMA 3R.
- PROVIDE SEAL-TIGHT FROM MOTOR TO DISCONNECT.
- PROVIDE PULL BOX/J-BOX.
- PROVIDE FEEDER FROM PULL BOX TO DISCONNECT.
- EXISTING CONDUIT/CONDUCTORS.
- EXISTING CONDUIT TO T-13. PROVIDE PULL BOX AND EXTEND FEEDER TO RED MCC1.
- EXISTING CONDUIT TO FIRST FLOOR LOADING DOCK. PROVIDE PULL BOX AND EXTEND FEEDER TO RED MCC1.
- EXISTING WASH WATER #2 COMBINATION STARTER. PROVIDE PULL BOX AND EXTEND FEEDER TO RED MCC1.
- EXISTING DISCONNECT, PROVIDE FEEDER TO RED MCC1.
- POWER PANEL #4, PROVIDE FEEDER FROM RED MCC1.
- CORE EXISTING WALL, ROUTE CONDUIT UNDERGROUND. PROVIDE SS LINK-SEAL AND GROUT.
- PROVIDE JUNCTION BOX w/ DRAIN HOLE, SLOPE CONDUITS TO PREVENT WATER FROM FLOWING INTO RED MCC1.
- EXISTING INTERCOM SYSTEM. PROVIDE FEEDER TO NEW INTERCOM SYSTEM ON SHEET E-153.
- NEW MAGNETIC FLOW METER.
- NEW FLOW METER CONTROL PANEL, EXTEND EXISTING FEEDER FROM LP-E AS REQUIRED.
- NEW 480V 3 ϕ ROTORK ACTUATOR.
- 1" RGS w/ 3#12, 1#12G.
- 1" RGS w/ 12#14, 1#14G.
- 4" RGS w/ 2#18 PAIR GAI-TRONIC 60029-101 (INTERCOM) AND 4#14 (FIRE ALARM STATION).
- EXISTING ALLEN-BRADLEY SLC-5 ON UPPER FLOOR.
- 4" RGS w/ 12 STRAND MULT-MODE FIBER.
- EXISTING FIBER TERMINATION.
- CONTRACTOR TERMINATION AND CONNECT FIBER OPTIC CABLES AS REQUIRED.
- CORE THROUGH BLOCK WALLS, ADD LINK SEALS AS REQUIRED, TYP. ALL PENETRATIONS.
- ROUTE CONDUIT DOWN ALONG STRUCTURAL STEEL.

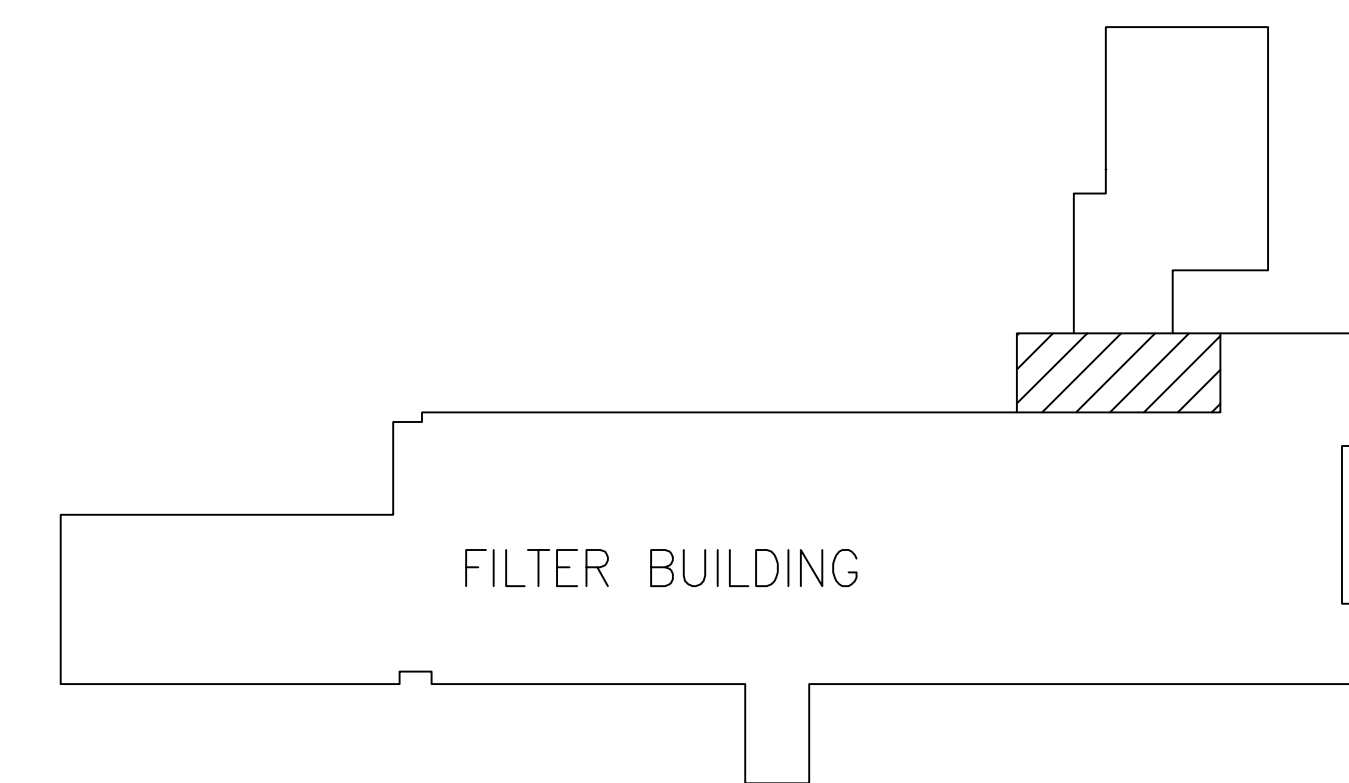

KEY PLAN

I:\2075117301\pump\pump\electrical\17301E-120.dwg, 5/6/2013 8:46:44 AM, eLD_v02.dwg

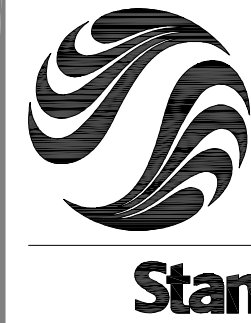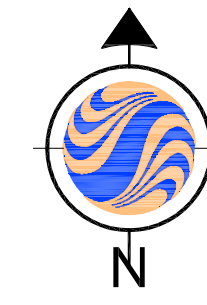

Stantec Consulting Michigan Inc.
 3754 Ranchero Drive
 Ann Arbor, MI U.S.A.
 48108
 Tel. 734.761.1010
 Fax. 734.761.1200
 www.stantec.com

KEY NOTES ☒

1. PROVIDE DEDICATED RECEPTACLE FOR METER FROM MCP.
2. PROVIDE SURGE TANK CONTROL PANEL.
3. PROVIDE SUMP PUMP CONTROL PANEL.

Copyright Reserved

The Contractor shall verify and be responsible for all dimensions. DO NOT scale the drawing - any errors or omissions shall be reported to Stantec without delay.
 The Copyrights to all designs and drawings are the property of Stantec. Reproduction or use for any purpose other than that authorized by Stantec is forbidden.

Consultants

Legend

1. SEE SHEET E-001.

Notes

- A. ALL WORK SHALL COMPLY WITH PROJECT SPECIFICATIONS.
- B. GROUND REBAR IN TWO PERPENDICULAR DIRECTIONS OR AT LEAST FOUR POINTS AT OPPOSITE SIDES OF THE BUILDING
- C. REFER TO SHEET E-503 FOR GROUNDING INFORMATION.

Revision	By	Appd.	YY.MM.DD
F ADDENDUM NO. 2	GRW	GRW	12.05.18
E BID SET	GRW	GRW	12.05.01
D MDEQ DRAFT SUBMITTAL	GRW	GRW	12.03.14
C PLANNING COMMISSION SUBMITTAL	GRW	GRW	12.01.27
B 90% REVIEW	GRW	GRW	12.01.13
A 30% REVIEW	GRW	GRW	11.12.15
Issued	By	Appd.	YY.MM.DD

File Name: 17301E-122.DWG 11.12.15

Permit-Seal

Client/Project

CITY OF ANN ARBOR

WEST HIGH SERVICE
PUMP STATION

Ann Arbor, Michigan

Title

ELECTRICAL
POWER PLAN
EL. 963.0 AND 978.25




Project No. 2075117301 Scale 1/4"=1'-0"

Drawing No. Sheet Revision


E-122

75 of 144

0

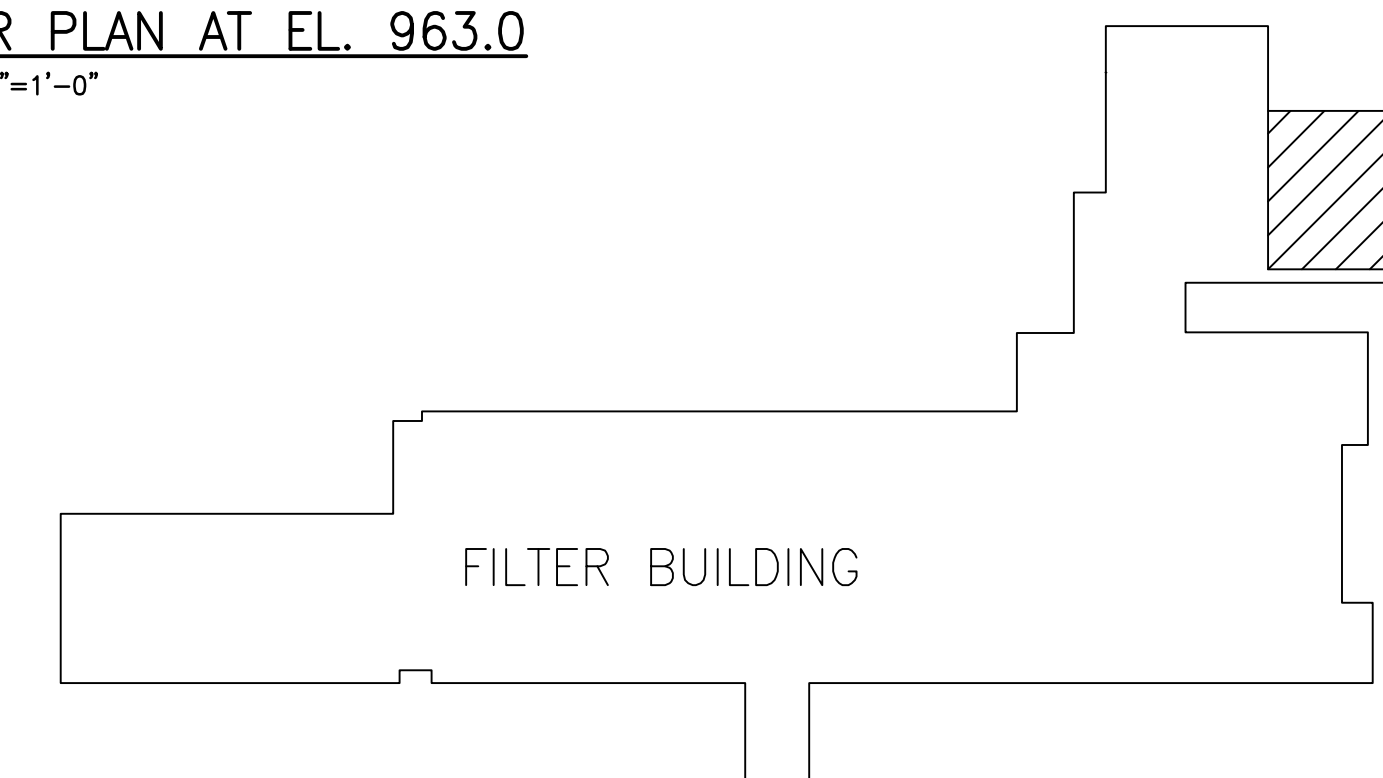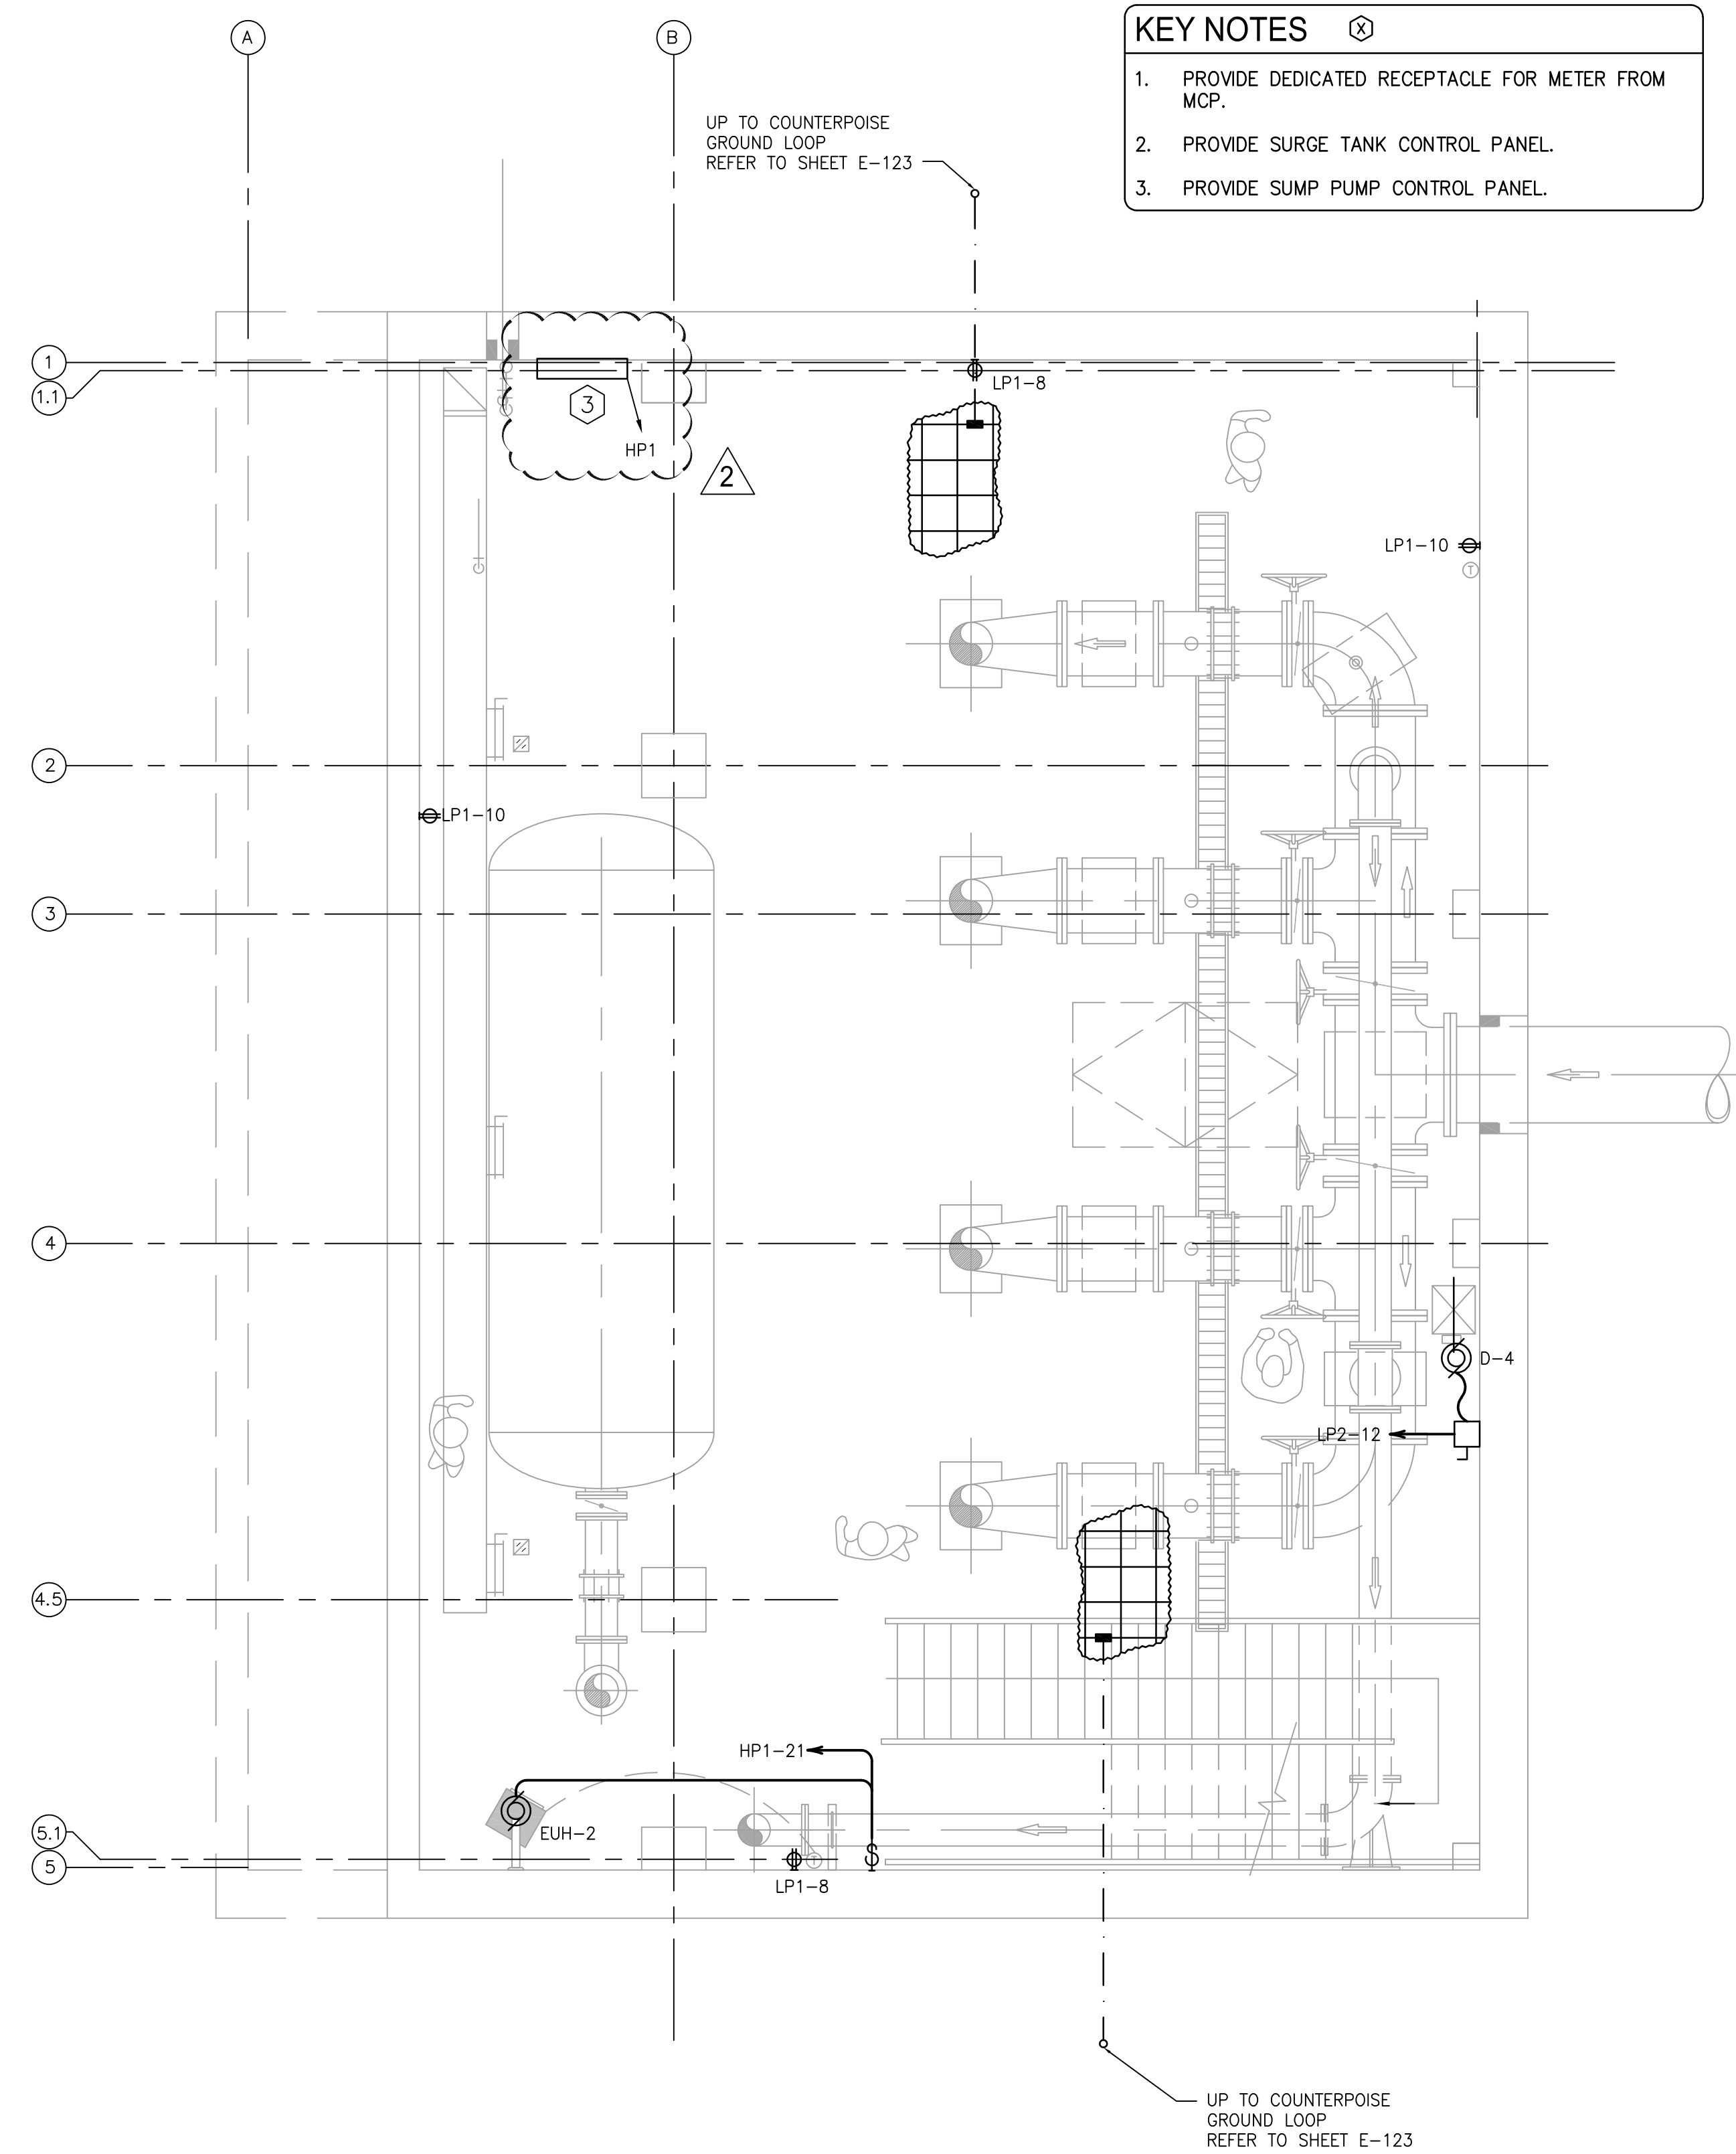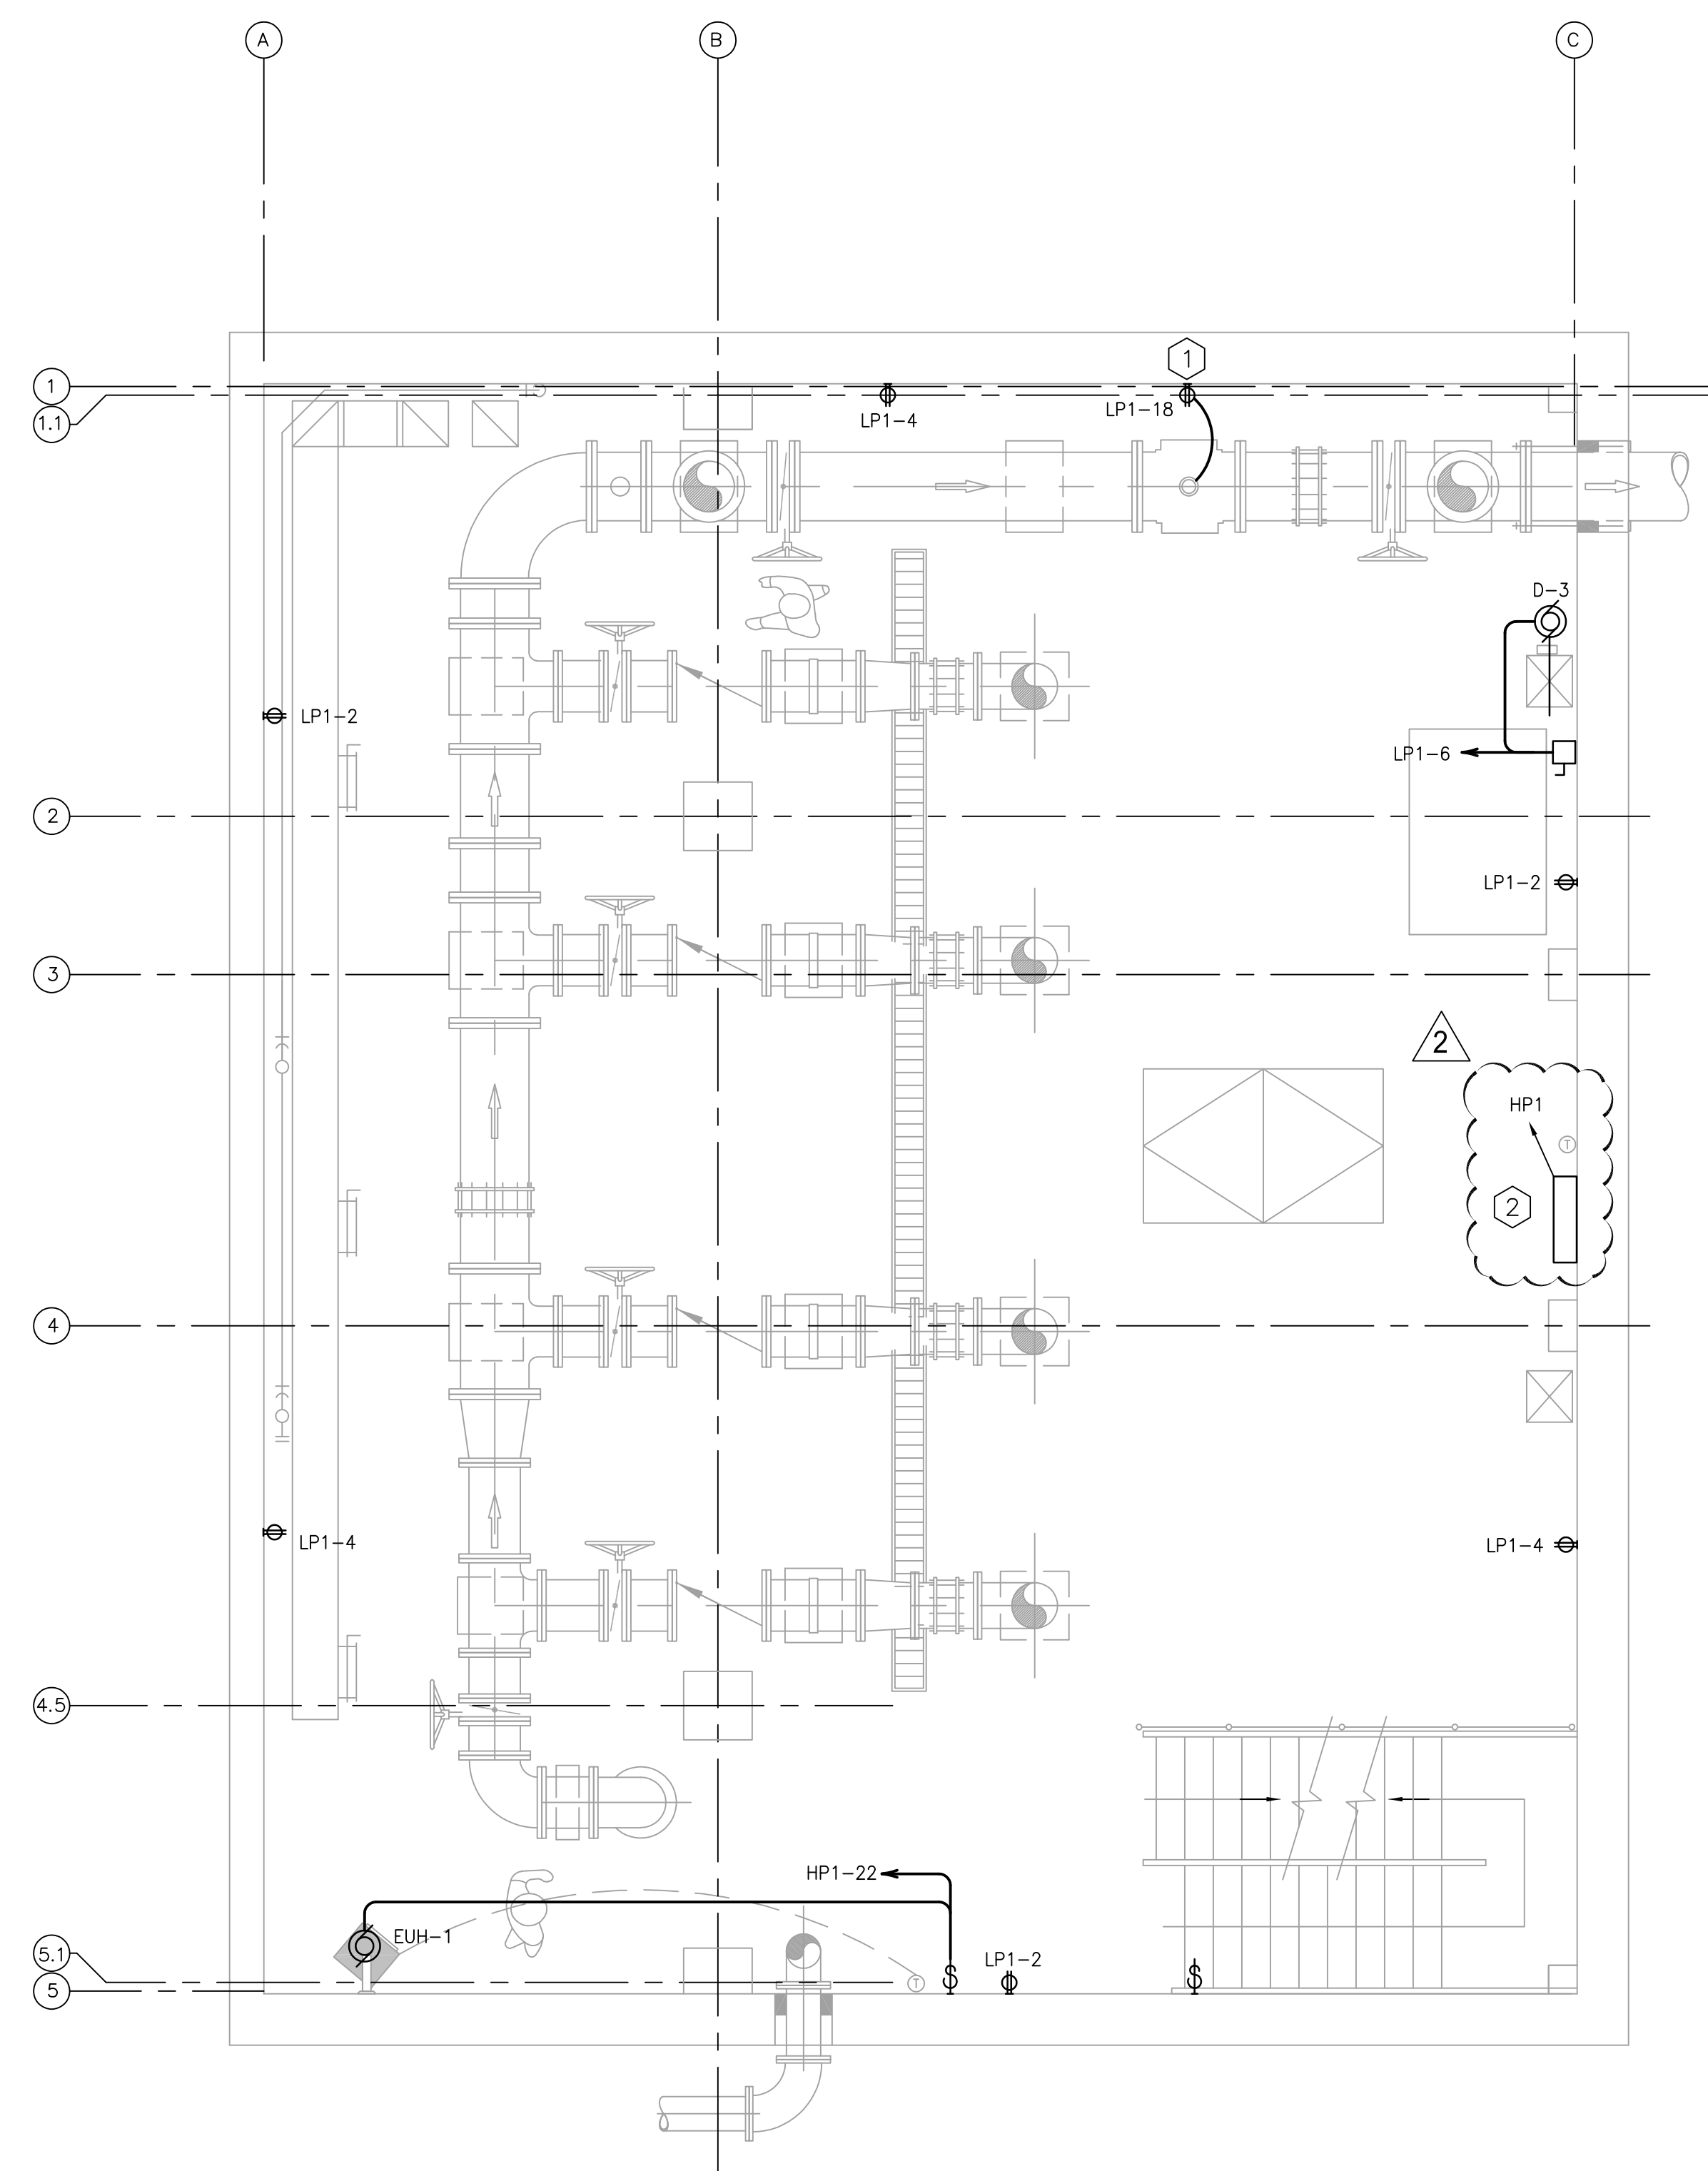

I:\2075117301\dwg\17301E-122.dwg, 5/6/2013 8:37:50 AM, eLD_wd01.dwg

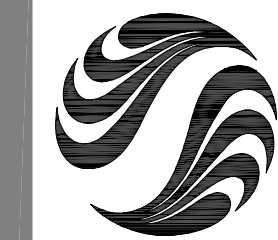

Stantec Consulting Michigan Inc.
3754 Ranchero Drive
Ann Arbor, MI U.S.A.
48108
Tel. 734.761.1010
Fax. 734.761.1200
www.stantec.com

Copyright Reserved

The Contractor shall verify and be responsible for all dimensions. DO NOT scale the drawing - any errors or omissions shall be reported to Stantec without delay.
The Copyrights to all designs and drawings are the property of Stantec. Reproduction or use for any purpose other than that authorized by Stantec is forbidden.

Consultants

Legend

- SEE SHEET E-001.

Notes

- ALL WORK SHALL COMPLY WITH PROJECT SPECIFICATIONS.

Revision	By	Appd.	YY.MM.DD
F ADDENDUM NO. 2	GRW	GRW	12.05.18
E BID SET	GRW	GRW	12.05.01
D MDEQ DRAFT SUBMITTAL	GRW	GRW	12.03.14
C PLANNING COMMISSION SUBMITTAL	GRW	GRW	12.01.27
B 90% REVIEW	GRW	GRW	12.01.13
A 30% REVIEW	GRW	GRW	11.12.15

Issued By Appd. YY.MM.DD

File Name: 17301E-607.DWG 11.12.15

Permit-Seal Dwn. Chkd. Dsgn. YY.MM.DD

Client/Project
CITY OF ANN ARBOR
WEST HIGH SERVICE PUMP STATION
Ann Arbor, Michigan

Title
ELECTRICAL SCHEDULES

Project No. 2075117301
Drawing No. E-607
Scale AS NOTED
Sheet
Revision

LUMINAIRE SCHEDULE

No.	DESCRIPTION	MANUFACTURER	MODEL No.	LAMP No.	LAMP TYPE	MOUNTING	REMARKS	WATTS
A	PETROLUX 98 LED, HIGH ANGLE, 5000K, SURFACE MOUNTED FIXTURE	LITHONIA THOMAS HOLOPHANE	PLED 98 35 5K AS CE NA G L5H	98	98 NICHIA 119 LED ARRAY, 5000K	SURFACE	-	113.6
B	PETROLUX 98 LED, LOW ANGLE, 4000K, SURFACE MOUNTED FIXTURE	LITHONIA THOMAS HOLOPHANE	PLED 98 35 4K AS CE NA G L5	98	98 NICHIA 119 LED ARRAY, 4000K	SURFACE	-	114.3
C	PETROLUX 70 LED, LOW ANGLE, 4000K, SURFACE MOUNTED FIXTURE	LITHONIA THOMAS HOLOPHANE	PLED 70 35 4K AS CE NA G L5	70	70 NICHIA 119 LED ARRAY, 4000K	SURFACE	-	82.5
D	13 LED, WALL MOUNT FIXTURE	LITHONIA THOMAS HUBBELL	QSPC-13LU-SK	13	LED	WALL	MOTION SENSOR	23.3
E1	QUANTUM THERMOPLASTIC, WHITE LOW PROFILE CORROSION-PROOF EMERGENCY WALL PACK FIXTURE	LITHONIA THOMAS	ELM2	2	WEDGE-BASED KYPTON	WALL	-	12
E2	QUANTUM DIE-CAST ALUMINUM WITH MATTE BLACK HOUSING AND BRUSHED ALUMINUM FACE, EMERGENCY EXIT FIXTURE	LITHONIA THOMAS	LOQ 1 R EL N	-	LED	WALL/CEILING	12" PENDANT-MOUNT KIT: ELA B US12	0.6
E3	QUANTUM THERMOPLASTIC, BLACK HOUSING, EMERGENCY EXIT FIXTURE w/ SIDE-MOUNT LAMP HEADS	LITHONIA THOMAS	LHOM S 3 R HO	-	LED	WALL	-	5.4
F	HT24, RECESSED IN GRID, WHITE	LITHONIA THOMAS	HT24 G 2 32 A12 120 GEB10IS	2	32W T8 FLUOR.	RECESSED	-	54

POWER CONDUIT SCHEDULE

ITEM	FROM	TO	FEEDER	NOTES
P1	SWG1	RT1	3#750KCMIL, 1#1G - 4°C	MV-10S CABLE
P2	RT1	RSB1	8(3#750KCMIL, 1#750KCMIL G) - 8(4°C)	
P3	SB-GEN	RSB1	2(3#500KCMIL, 1#2/OG) - 2(4°C)	
P4	RSB1	VP#1	3#350KCMIL, 1#4G - 4°C	
P5	RSB1	VP#2	3#350KCMIL, 1#4G - 4°C	
P6	RSB1	VP#3	3#350KCMIL, 1#4G - 4°C	
P7	RSB1	VP#4	3#350KCMIL, 1#4G - 4°C	
P8	RSB1	GMCC3	3#500KCMIL, 1#3G - 4°C	
P9	RSB1	RMCC1	5(3#500KCMIL, 1#250KCMIL G) - 5(4°C)	
P10	RSB1	RMCC2	2(3#500KCMIL, 1#3/OG) - 2(4°C)	
P11	RSB1	HP1	2(3#500KCMIL, 1#2G) - 4°C	
P12	RSB1	TI	3#2, 1#6G - 2°C	
P13	TI	LP1	3#300KCMIL, 1#4G - 3°C	
P14	RMCC1	PP-1A/PP-1B	3#400KCMIL, 1#3C - 4°C	
P15	RMCC1	PP#3	2(3#500KCMIL, 1#2G) - 4°C	
P16	RMCC1	PP#4	2(3#500KCMIL, 1#2G) - 4°C	
P17	RMCC1	TP#4	3#1, 1#6G - 2°C	
P18	RMCC1	TP#5	3#1, 1#6G - 2°C	
P19	RMCC1	TP#6	3#1, 1#6G - 2°C	
P20	RMCC1	WWP#2	3#2/0, 1#6G - 2°C	
P21	RMCC1	T-13	3#8, 1#10G - 1°C	
P22	RMCC1	LP-G	3#3, 1#8G - 1 1/2°C	
P23	RMCC1	T-25KVA	3#3, 1#8G - 1 1/2°C	
P24	RMCC1	ET-5	3#2, 1#10G - 1°C	
P25	COMM	COMM	FIBER OPTICS	FIBER CABLE
P26	COMM	FYC/INTERCOMM	2#18, 4#14-4"	

PANEL SCHEDULE

LOAD DESCRIPTION	CON SIZE	WIRE SIZE	BKR	#	PHASE LOAD-KVA			#	BKR	CON SIZE	WIRE SIZE	LOAD DESCRIPTION
					A	B	C					
EXHAUST FAN - EF-2	3/4"	#12	20	0.44			20		#12	3/4"		EXHAUST FAN - EF-1
CONDENSING UNIT - CU-2	3/4"	#8	40	7.38			40		#8	3/4"		CONDENSING UNIT - CU-1
AIR CONDITIONER - AC-2	3/4"	#8	40	7.38			40		#8	3/4"		AIR CONDITIONER - AC-1
FORCED FAN HEATER - FFH-2	3/4"	#10	30	10			30		#10	3/4"		FORCED FAN HEATER - FFH-1
ELECTRIC UNIT HEATER - EUH-2	3/4"	#8	40	9.375			40		#8	3/4"		ELECTRIC UNIT HEATER - EUH-1
SUMP PUMP CONTROL PANEL #1	3/4"	#12	20	2.1			20					SPARE
SUMP PUMP CONTROL PANEL #2	3/4"	#12	20	2.1			20					SPARE
SURGE TANK CONTROL PANEL	3/4"	#12	20	4.8			20					SPARE
TOTAL CONNECTED LOAD				68.4	70.15	48.4						HIGH LEG LOAD
C=CONTINUOUS X 125% (NEC 210.20A)				0.00	0.00	0.00						52.90 KVA 0.48 KV = 110.21 AMPERES
N=NON-CONTINUOUS				0.00	0.00	0.00						
M=LARGEST MOTOR X 125% (NEC 220-14)				52.90	51.49	32.25						
TOTAL CALCULATED NEC LOAD				52.90	51.49	32.25						

PANEL SCHEDULE - HP1
NO SCALE

PANEL SCHEDULE

LOAD DESCRIPTION	CON SIZE	WIRE SIZE	BKR	#	PHASE LOAD-KVA			#	BKR	CON SIZE	WIRE SIZE	LOAD DESCRIPTION
					A	B	C					
RECEPTS - EXTERIOR PUMP BUILDING	3/4"	#12	20	0.9			20		#12	3/4"		RECEPTS - EL 978 25
RECEPTS - PUMP ROOM	3/4"	#12	20	0.54			20		#12	3/4"		RECEPTS - EL 978 25
RECEPTS - PUMP ROOM	3/4"	#12	20	0.54			20		#12	3/4"		DAMPER - D-3
GAS UNIT HEATER - GUH-1	3/4"	#12	20	0.03			20		#12	3/4"		RECEPTS - EL 963
GAS UNIT HEATER - GUH-2	3/4"	#12	20	0.36			20		#12	3/4"		RECEPTS - EL 963
DAMPER - D-1	3/4"	#12	20	0.01			20		#12	3/4"		DAMPER - D-4
DAMPER - D-2	3/4"	#12	20	1.08			20		#12	3/4"		RECEPTS - EL 1004 83
SPARE				0			40		#12	3/4"		WATER HEATER - EWH-1
RECEPTS - ELECTRICAL ROOM	3/4"	#12	20	0.36			20		#12	3/4"		RECEPT - EL 978 25 DEDICATED METER
SPARE				0			20					SPARE
SPARE				0			20					SPARE
SECURITY CONTROL PANEL	3/4"	#12	20	1.92			20		#12	3/4"		EMERGENCY LIGHTING - PUMP ROOM
EXHAUST FAN - EF-3	3/4"	#12	20	0.53			20		#12	3/4"		EMERGENCY LIGHTING - ELECTRICAL ROOM
EXHAUST FAN - EF-4	3/4"	#12	20	0.53			20		#12	3/4"		LIGHTING - EL 963.0
LIGHTING CONTROLLER - LC1	3/4"	#12	20	1.44			20		#12	3/4"		EMERGENCY LIGHTING - EL 963.0
SPACE				0			20		#12	3/4"		LIGHTING - EL 978 25
SPACE				0			20		#12	3/4"		EMERGENCY LIGHTING - EL 978 25
TOTAL CONNECTED LOAD				4.17	9.15	2.81						HIGH LEG LOAD
C=CONTINUOUS X 125% (NEC 210.20A)				0.90	3.45	1.46						8.85 KVA 0.12 KV = 82.06 AMPERES
N=NON-CONTINUOUS				2.88	6.36	1.08						
M=LARGEST MOTOR X 125% (NEC 220-14)				0.70	0.04	0.69						
TOTAL CALCULATED NEC LOAD				4.48	9.85	3.24						

PANEL SCHEDULE - LP1
NO SCALE

