




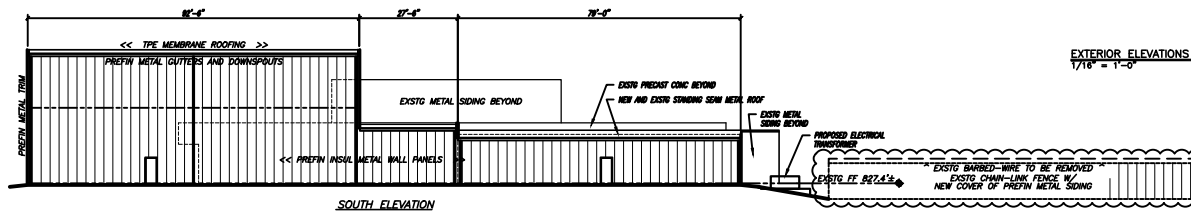


AREAL PHOTO W/ PROPOSED ADDITION - 100' EXTENSION
 ALL DIMENSIONS SHOWN ARE UNLESS NOTED OTHERWISE AND REFERRED TO AS PROPOSED ADDITION.

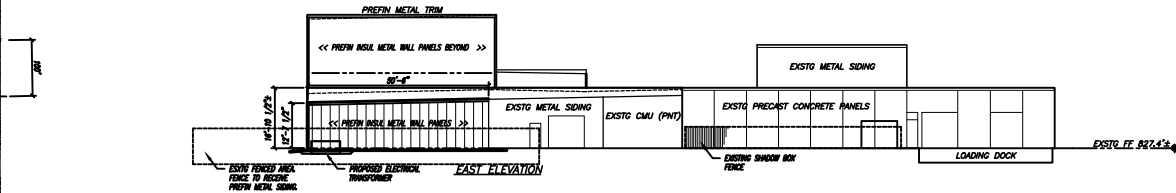

EXTERIOR ELEVATIONS
 1/16" = 1'-0"

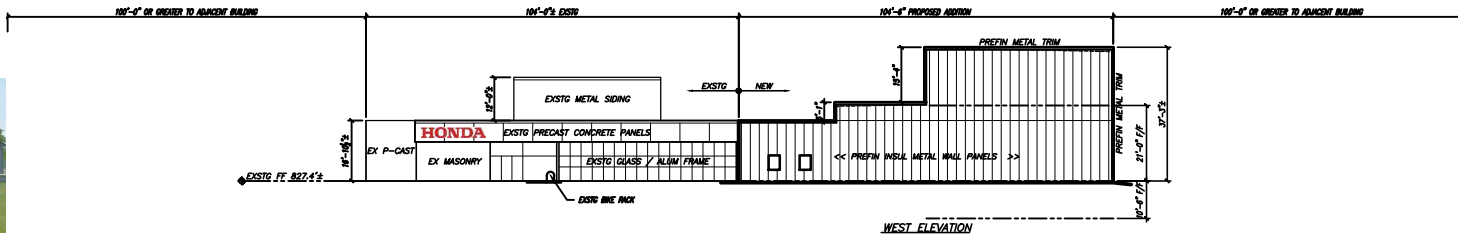

EXISTING BUILDING FACADE

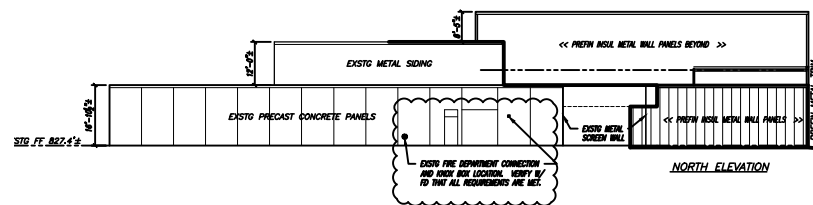

NO.	DATE	DESCRIPTION
1	7/22/13	REVISED FOR ANN ARBOR PLAN REVIEW REVISIONS
2	8/26/13	REVISED FOR ANN ARBOR PLAN REVIEW



POGEMEYER DESIGN GROUP, INC.
 ARCHITECTS
 1188 NORTH MAIN STREET (419) 562-7537 BOWLING GREEN, OHIO 43402

Honda Corporation USA Office
 10000 WEST GRAND AVENUE, SUITE 200
 FARMINGTON HILLS, MI 48334
 M.A.A.E.A.

HONDA
 TESTING FACILITY EXPANSION
 ANN ARBOR, MICHIGAN

PROPOSED ELEVATIONS

NO.	DATE	DESCRIPTION
1	7/22/13	REVISED FOR ANN ARBOR PLAN REVIEW REVISIONS
2	8/26/13	REVISED FOR ANN ARBOR PLAN REVIEW

4 OF 20
 8119-004