

STAYBRIDGE SUITES & RETAIL CENTER

3850 RESEARCH PARK DRIVE

CITY OF ANN ARBOR, WASHTENAW COUNTY, MICHIGAN

SITE PLAN APPROVAL FOR PLANNING COMMISSION
CONSTRUCTION PLANS

PROPERTY OWNER/
PETITIONER / APPLICANT

STELLAR HOSPITALITY ANN ARBOR, LLC
2600 AUBURN ROAD, SUITE 240
AUBURN HILLS, MI 48326


CONTACT: JIMMY ASMAR
PHONE: (248) 419-5555

CIVIL ENGINEER

STELLAR DEVELOPMENT, LLC
2600 AUBURN ROAD, SUITE 160
AUBURN HILLS, MI 48326

CONTACT: ANDREW ANDRE, P.E.
PHONE: (810) 444-7815

STAYBRIDGE SUITES & RETAIL CENTER
3850 RESEARCH PARK DRIVE
ANN ARBOR, MI 48108

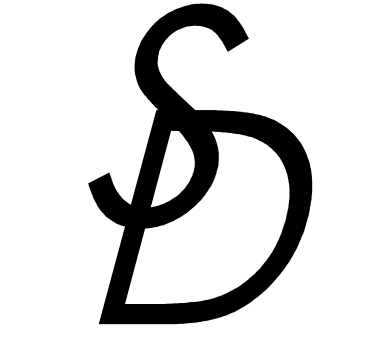

STELLAR DEVELOPMENT, LLC
2600 AUBURN ROAD, SUITE 160
AUBURN HILLS, MI 48326
PH 810-444-7815
FX 248-553-4218

PREPARED UNDER THE DIRECTION OF:
ANDREW ANDRE, P.E.
MI #47380

APPLICANT:
STELLAR HOSPITALITY ANN ARBOR, LLC
2600 AUBURN ROAD, SUITE 240
AUBURN HILLS, MI 48326
PH 248-419-5551

DEVELOPMENT PROGRAM

- A) THE PROPOSED LAND USE IS ZONED RE AND IS MASTERPLANNED FOR MIXED USE (COMMERCIAL/OFFICE/RESIDENTIAL) IN ACCORDANCE WITH THE "SOUTH STREET CORRIDOR PLAN" ADOPTED BY CITY PLANNING COMMISSION ON MAY 21, 2013 AND CITY COUNCIL ON JULY 15, 2013. THIS PROJECT CONSISTS OF THE DEMOLITION OF AN EXISTING BUILDING AND CONSTRUCTION OF AN EXTENDED STAY HOTEL AND RETAIL CENTER FOR A MIXED USE COMMERCIAL DEVELOPMENT. THIS PROJECT INCLUDES NEW LANDSCAPING AND STORM WATER IMPROVEMENTS. PARKING AND DENSITY CALCULATIONS ARE PROVIDED ON THE SITE LAYOUT AND PAVING PLAN INCLUDED WITHIN THIS SET.
- B) THERE IS NO PROPOSED PHASING. THE ESTIMATED CONSTRUCTION COST IS IN THE RANGE OF \$6,000,000.
- C) THE SUBMISSION IS FOR A PLANNED PROJECT.

COMMUNITY ANALYSIS

- A) THIS PROJECT WILL NOT HAVE AN IMPACT ON THE PUBLIC SCHOOLS.
- B) THE RELATIONSHIP OF THIS PROJECT TO THE NEIGHBORING USE SHOULD NOT CHANGE.
- C) THERE SHOULD BE NO CHANGE TO ADJACENT USES.
- D) THIS PROJECT WILL NOT CHANGE THE AIR QUALITY, IT WILL IMPROVE STORMWATER MANAGEMENT BY PROVIDING DETENTION THAT IS NOT CURRENTLY PROVIDED FOR ON THE PROPERTY, IT WILL IMPROVE THE NATURAL FEATURES WITH NEW LANDSCAPING.
- E) THIS PROJECT IS NOT LOCATED WITHIN A HISTORIC DISTRICT AND WILL NOT IMPACT ANY KNOWN HISTORIC SITES OR STRUCTURES.

NATURAL FEATURES STATEMENT OF IMPACT

THE IMPACT UPON THE NATURAL FEATURES WILL BE MINIMAL SINCE THE PROPERTY HAS PREVIOUSLY BEEN DEVELOPED. THERE ARE SOME ANTICIPATED REMOVAL OF TREES ON THE PROPERTY, HOWEVER REPLACEMENT TREES AND LANDSCAPE IMPROVEMENTS WILL BE PROVIDED FOR. THE EXISTING CONDITIONS ARE CONTINUING TO DETERIORATE, THEREFORE RE-DEVELOPMENT OF THE PROPERTY WILL IMPROVE THE CURRENT CONDITIONS. BASED ON THE TREE INVENTORY CONDUCTED BY ERIC OLSON, RLA, THERE ARE NOT WOODLANDS ON THE PROPERTY. THERE ARE A TOTAL OF 66 TREES IDENTIFIED ON THE PROPERTY, OF WHICH 17 ARE NOT REGULATED, 30 ARE REGULATED AS LANDMARK TREES. THERE IS AN ENCROACHMENT INTO THE CRITICAL ROOT ZONE OF THE PROTECTED LANDMARK TREES, HOWEVER THE EXISTING SITE HAS PAVEMENT WITHIN THE CRITICAL ROOT ZONE OF THE TREES. THE PROPOSED DEVELOPMENT ACTIVITIES WILL KEEP THE ENCROACHMENT AT THE SAME LOCATION. REMOVAL OF 9 LANDMARK TREES ARE PROPOSED AND THE REMAINING TREES WILL BE PROTECTED BY THE USE OF PERIMETER PLASTIC MESH FENCING PLACED AT THE DRIP LINE OF THE TREES.

TRAFFIC STATEMENT


THE TRAFFIC IMPACT STUDY WILL BE SUBMITTED UNDER SEPARATE COVER.

STATEMENT OF INTEREST

THE APPLICANT IS THE OWNER OF THE PROPERTY.

SITE ANALYSIS

- A) THE EXISTING LAND USE IS MASTERPLANNED FOR MIXED USE. CURRENTLY, THERE IS AN EXISTING BUILDING AND THE PROPERTY IS IN A DETERIORATED STATE.
- B) A TREE INVENTORY HAS BEEN CONDUCTED FOR THE PROPERTY. THE SITE IS RELATIVELY FLAT WITH SOME RELIEF ACROSS THE PROPERTY. SOIL CONDITIONS WERE IDENTIFIED AS "FILL LAND" ACCORDING TO THE USDA-NRCS "WEB SOIL SURVEY"
- C) NATURAL FEATURES
 - i) ENDANGERED SPECIES: THE U.S. FISH & WILDLIFE SERVICE ENDANGERED SPECIES LIST FOR WASHTENAW COUNTY WAS REVIEWED, AND THE HABITAT OF THE SUBJECT PROPERTY DOES NOT MATCH THE REQUIREMENTS FOR CORRESPONDING SPECIES
 - ii) 100-YEAR FLOODPLAIN: ACCORDING TO FEMA COMMUNITY PANEL 26161C04P1E EFFECTIVE 04/03/2012, THE PROPERTY IS LOCATED IN ZONE "X", WHICH IS AREAS DETERMINED TO BE OUTSIDE 0.2% ANNUAL CHANCE FLOODPLAIN.
 - iii) LANDMARK TREES: A TREE INVENTORY WAS CONDUCTED FOR THE PROPERTY AND IS INCLUDED WITHIN THE PLAN SET.
 - iv) STEEP SLOPES: THERE ARE NO STEEP SLOPES ON THE PROPERTY.
 - v) WATERCOURSES: THERE ARE NO WATERCOURSES ON THE PROPERTY.
 - vi) WETLANDS: THERE ARE NO WETLANDS ON THE PROPERTY AS INDICATED ON THE NATIONAL WETLAND INVENTORY MAP.
 - vii) WOODLANDS: ACCORDING TO THE TREE INVENTORY THAT WAS CONDUCTED, THERE ARE NO WOODLANDS ON THE PROPERTY.
- D) THERE IS AN EXISTING BUILDING ON THE PROPERTY THAT IS SITUATED ON THE NORTHERN PORTION OF THE SITE WITH A LARGER PARKING LOT IN THE REAR.
- E) EXISTING AND PROPOSED VEHICULAR, PEDESTRIAN AND BICYCLE WAYS AND ACCESS POINTS ARE INDICATED ON THE SITE LAYOUT AND PAVING PLAN.
- F) UTILITIES AND PROPOSED CONNECTIONS ARE SHOWN ON THE UTILITY PLAN INCLUDED IN THE PLAN SET.
- G) EXISTING AND PROPOSED GENERAL DRAINAGE PATTERN ON THE PROPERTY ARE INDICATED ON THE STORM MANAGEMENT PLANS IN THE PLAN SET.
- H) THE PROPOSED MIXED USE IS CONSISTENT WITH THE MASTER PLAN. THE PROJECT WILL ENHANCE THE RESEARCH PARK AREA BY PROVIDING FOR NON-EXISTENT USES OF A HOTEL AND RETAIL. THIS PROJECT WILL ENHANCE THE AREA WITH NEW LANDSCAPING IMPROVEMENTS.

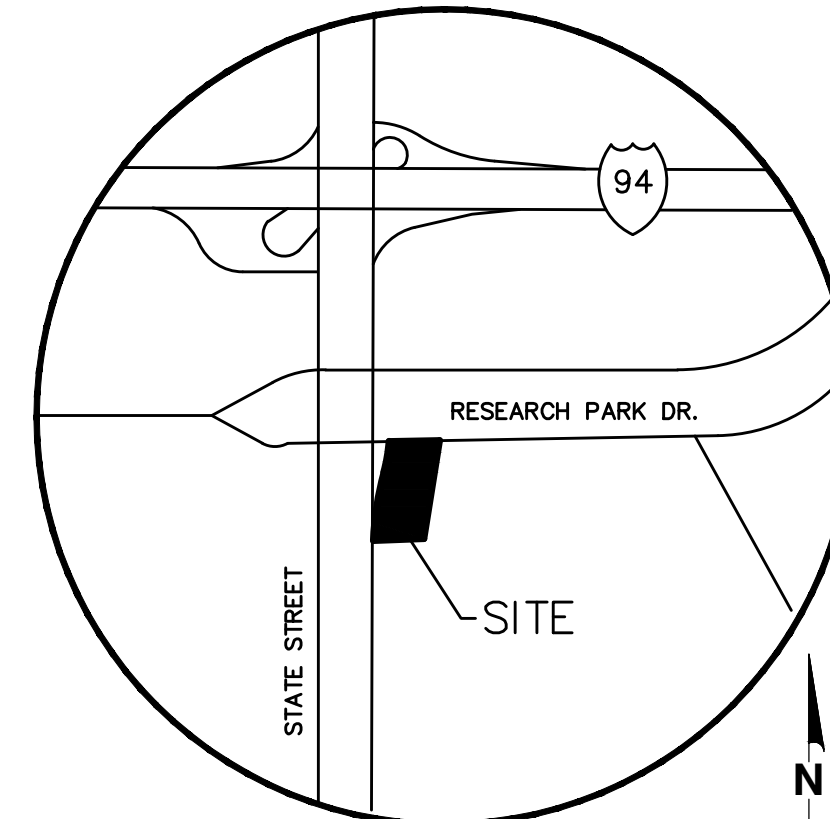

LOCATION MAP
NOT TO SCALE



Know what's below.
Call before you dig.

DRAWING INDEX

- C1.0 COVER SHEET
- C2.0 ALTA/NSPS LAND TITLE SURVEY
- ~~C2.1 TREE INVENTORY PLAN~~
- ~~C2.2 SOIL BORING PLAN~~
- ~~C2.3 NATURAL FEATURES ALTERNATIVE ANALYSIS PLAN~~
- C3.0 SITE LAYOUT AND PAVING PLAN
- ~~C3.1 SITE PHOTOMETRIC PLAN~~
- ~~C4.0 OVERALL GRADING AND EROSION CONTROL PLAN~~
- ~~C4.1 ENLARGED GRADING PLAN~~
- ~~C4.2 ENLARGED GRADING PLAN~~
- C5.0 UTILITY PLAN
- C5.1 STORM LAYOUT PLAN
- C5.2 STORM MANAGEMENT PLAN
- C5.3 STORM MANAGEMENT DETAILS
- ~~C5.4 FIRE COVERAGE PLAN~~
- ~~C5.5 WATER MAIN PROFILES~~
- ~~C5.6 WATER MAIN PROFILES~~
- ~~C5.7 STORM SEWER PROFILES~~
- C5.8 UNDERGROUND DETENTION PLANS
- C5.9 UNDERGROUND DETENTION PLANS
- ~~C6.0 SITE DETAILS~~
- ~~C6.1 CITY OF ANN ARBOR STANDARD DETAILS~~
- ~~C6.2 CITY OF ANN ARBOR STANDARD DETAILS~~
- L1.0 LANDSCAPE PLAN AND DETAILS

STANDARD LEGEND		
DESCRIPTION	PROPOSED	EXISTING
BUILDING	[Symbol]	[Symbol]
STORM SEWER	--- 12" ---	--- 12" ---
SANITARY SEWER	-S-	--- 12" ---
WATER	--- W ---	--- W ---
GAS LINE	-G-	-G-
ELECTRIC LINE	-E-	-E-
TELEPHONE LINE	-T-	-T-
MANHOLE	●	⊙ ⊙
CATCH BASIN	⊙ ⊙	⊙ ⊙
ENDSECTION	[Symbol]	[Symbol]
FIRE HYDRANT	⊙	⊙
GATE VALVE & WELL	⊙	⊙ ⊙
UTILITY RISER	⊙	⊙
SIGN	[Symbol]	[Symbol]
LIGHT POLE	[Symbol]	[Symbol]
CURB & GUTTER	[Symbol]	[Symbol]
FENCE	[Symbol]	[Symbol]
SILT FENCE	[Symbol]	[Symbol]
TREE - DECIDUOUS	AS NOTED ON PLANS	
TREE LINE	[Symbol]	[Symbol]
SPOT ELEVATION	+ 100.00	+ 100.00
CONTOUR LINE	100	100
SECTION CORNER	[Symbol]	[Symbol]
FOUND PROPERTY IRON	[Symbol]	[Symbol]
SET PROPERTY IRON	[Symbol]	[Symbol]
GAS METER	⊙	⊙
ELECTRICAL METER	⊙	⊙
TELEPHONE RISER	[Symbol]	TREED
MAILBOX	[Symbol]	[Symbol]
SOIL BORING LOCATION	[Symbol]	[Symbol]



ANDREW ANDRE, P.E.
MICHIGAN PE 47380
STELLAR DEVELOPMENT, LLC

LEGAL DESCRIPTION
FIRST AMERICAN TITLE INSURANCE COMPANY COMMERCIAL TITLE SERVICES COMMITMENT NO. 14-8523 COMMITMENT DATE: SEPTEMBER 9, 2014 @ 8:00 AM LAND SITUATED IN THE CITY OF ANN ARBOR, COUNTY OF WASHTENAW, MICHIGAN, DESCRIBED AS: LOT 22, RESEARCH PARK, AS RECORDED IN LIBER 15 OF PLATS, PAGES 56 AND 57, WASHTENAW COUNTY RECORDS.

BENCHMARKS
B.M. #1 - SET BM ON LIGHT POLE NEAR THE NW COR OF PROPERTY ELEV. 834.30 NAVD 88
B.M. #2 - SET BM ON TOP OF NE BOLT ON LIGHT POLE BASE ON WEST SIDE OF PROPERTY ELEV. 835.78 NAVD 88

FLOODPLAIN INFORMATION
CITY OF ANN ARBOR WASHTENAW COUNTY, MICHIGAN MAP NUMBER: 26161C0401E EFFECTIVE DATE: APRIL 3, 2012 FLOOD ZONE: X AREA OUTSIDE OF THE 0.2% ANNUAL CHANCE FLOODPLAIN


UTILITY CONTACTS	
ELECTRIC DTE ONE ENERGY PLAZA ROOM 518 S.B. DETROIT, MI 48226 (313) 235-5632	GAS DTE ONE ENERGY PLAZA-WC81836 DETROIT, MI 48226 (313) 235-5111
ZONING CITY OF ANN ARBOR PLANNING & DEVELOPMENT 100 N FIFTH AVE. ANN ARBOR, MICHIGAN 48107 (734) 794-6265	WATER/SEWER CITY OF ANN ARBOR ENGINEERING DEPT. 301 E. HURON ANN ARBOR, MICHIGAN 48107 (734) 794-6410

UTILITY NOTE
THE UTILITY LOCATIONS AS HEREON SHOWN ARE BASED ON FIELD OBSERVATIONS AND A CAREFUL REVIEW OF MUNICIPAL AND UTILITY RECORDS. HOWEVER, IT IS NOT POSSIBLE TO DETERMINE THE PRECISE SIZE, LOCATION, DEPTH, PRESSURE, OR ANY OTHER CHARACTERISTICS OF UNDERGROUND UTILITIES, TANKS OR SEPTIC FIELDS WITHOUT EXCAVATION. THEREFORE, WE CANNOT GUARANTEE THE ACCURACY OF COMPLETENESS OF THE BURIED UTILITY INFORMATION HEREON SHOWN. THE CONTRACTOR SHALL CALL MISS DIG (1-800-482-7171) A MINIMUM OF THREE WORKING DAYS PRIOR TO ANY EXCAVATION. IT SHALL BE THE RESPONSIBILITY OF THE CONTRACTOR TO VERIFY THESE UTILITY LOCATIONS PRIOR TO CONSTRUCTION AND MAKE EVERY EFFORT TO PROTECT AND/OR RELOCATE THEM AS REQUIRED. THE CONTRACTOR SHALL NOTIFY THE ENGINEER/SURVEYOR AS SOON AS POSSIBLE IN THE EVENT A DISCREPANCY IS FOUND.

THIS DRAWING IS THE PROPERTY OF STELLAR DEVELOPMENT, LLC. IT IS TO BE USED ONLY FOR THE PROJECT AND SITE SPECIFICALLY IDENTIFIED HEREIN. ANY REUSE OR MODIFICATION OF THIS DRAWING WITHOUT THE WRITTEN PERMISSION OF STELLAR DEVELOPMENT, LLC IS STRICTLY PROHIBITED. THE USER ASSUMES ALL LIABILITY FOR ANY ERRORS OR OMISSIONS. THE USER SHALL BE RESPONSIBLE FOR OBTAINING ALL NECESSARY PERMITS AND APPROVALS. THE USER SHALL BE RESPONSIBLE FOR OBTAINING ALL NECESSARY INFORMATION FROM THE CITY OF ANN ARBOR AND WASHTENAW COUNTY RECORDS. THE USER SHALL BE RESPONSIBLE FOR OBTAINING ALL NECESSARY INFORMATION FROM THE CITY OF ANN ARBOR AND WASHTENAW COUNTY RECORDS. THE USER SHALL BE RESPONSIBLE FOR OBTAINING ALL NECESSARY INFORMATION FROM THE CITY OF ANN ARBOR AND WASHTENAW COUNTY RECORDS.

ISSUED FOR	DATE
SPA	12/29/14
SPA	02/20/15
SPA	03/23/15
SPA	04/23/15
PERMITS	06/12/15
SPA	07/28/15
SPA	08/17/15
CONST PLANS	09/05/15
CONST PLANS	10/02/15
CONST PLANS	11/05/15
CONST PLANS	12/09/15
UG DETENTION	03/06/16
SPA	01/21/21
SPA	02/28/21

DATE:	
DRAWN:	ACA
CHECKED:	
SCALE:	NTS
JOB NO:	BD-14-322
SHEET TITLE:	COVER SHEET
SHEET	
C1.0	

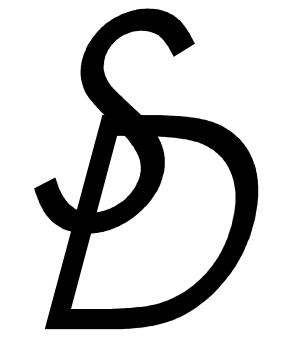

STELLAR DEVELOPMENT, LLC

2600 AUBURN ROAD, SUITE 160
AUBURN HILLS, MI 48326
PH 810-444-7815
FX 248-553-4218



PREPARED UNDER THE DIRECTION OF:
ANDREW ANDRE, P.E.
MI #47380

APPLICANT:
STELLAR HOSPITALITY ANN ARBOR, LLC
2600 AUBURN ROAD, SUITE 240
AUBURN HILLS, MI 48326
PH 248-419-5551

STAYBRIDGE SUITES & RETAIL CENTER

3850 RESEARCH PARK DRIVE

ANN ARBOR, MI 48108

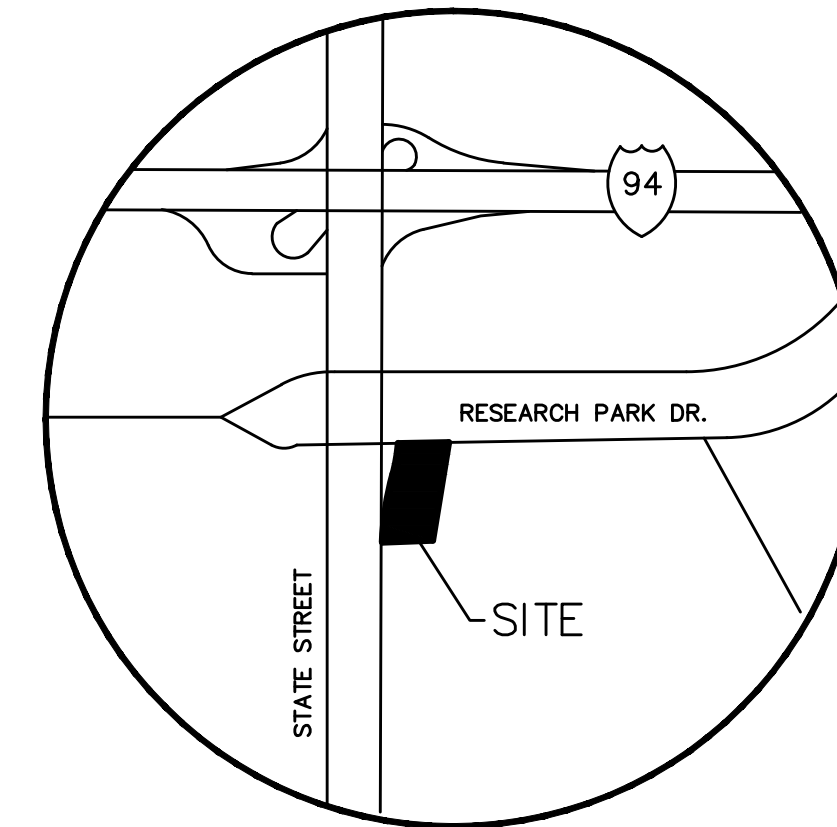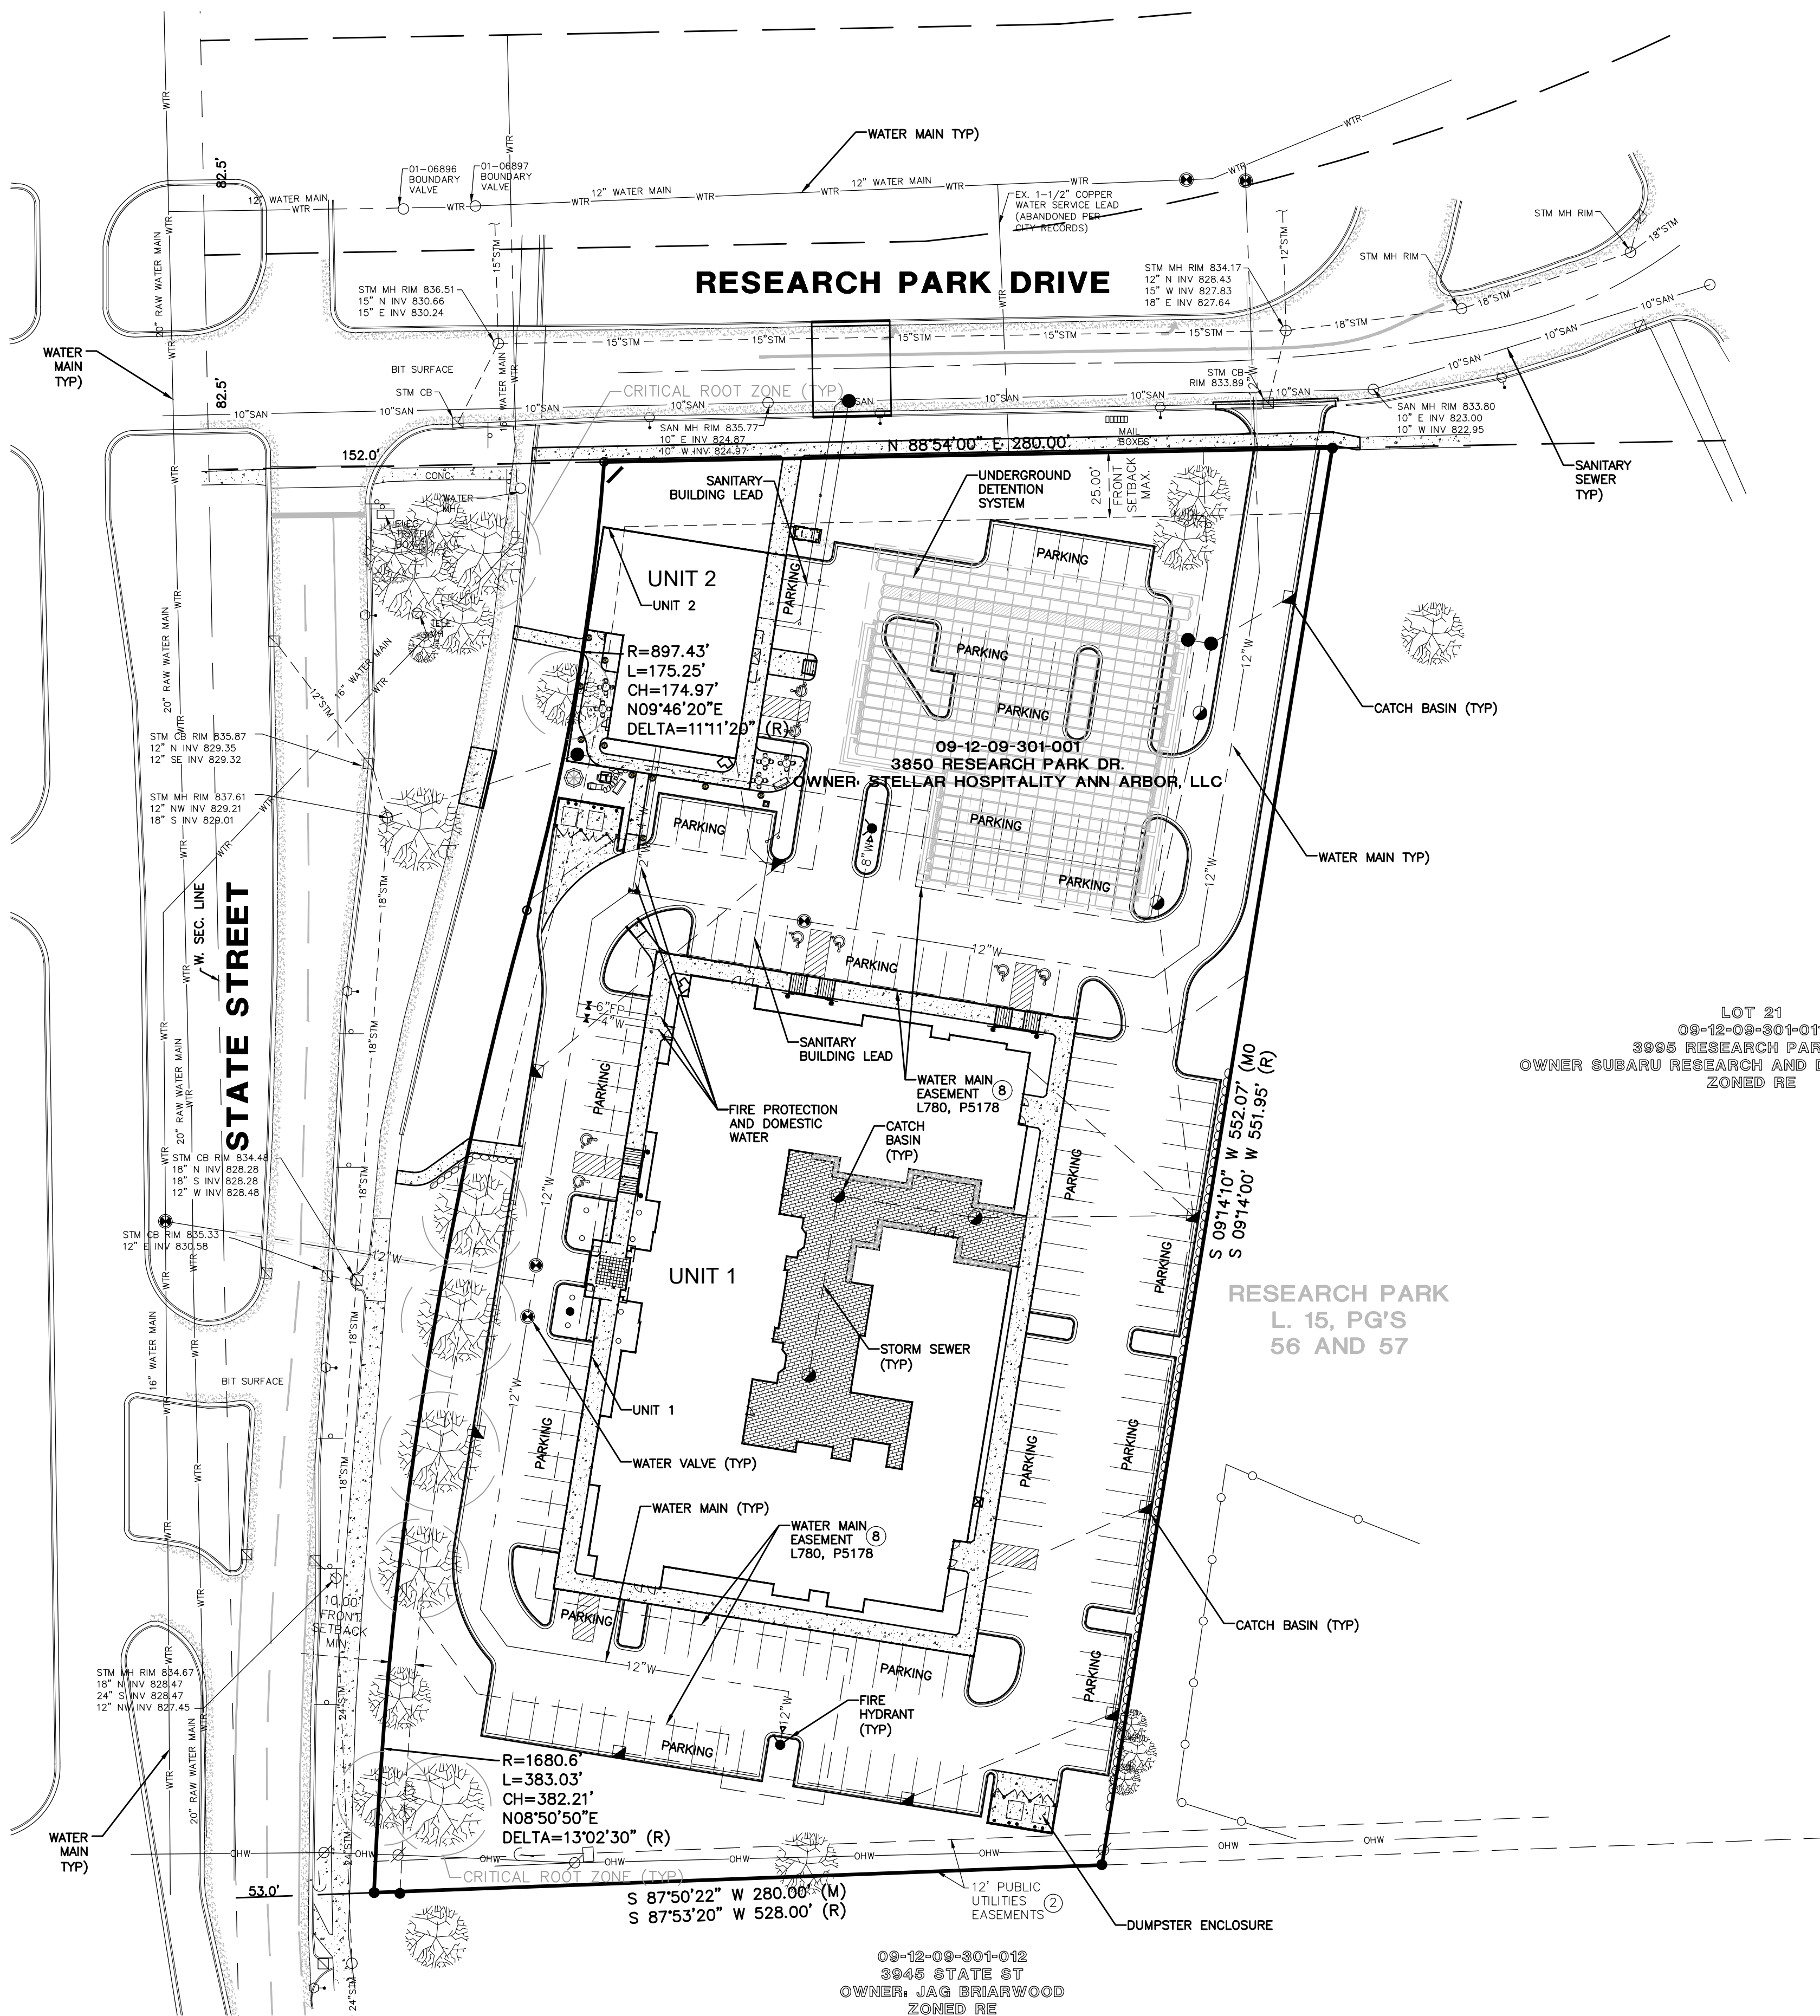

LOCATION MAP
NOT TO SCALE

LEGAL DESCRIPTION
LAND SITUATED IN THE CITY OF ANN ARBOR, COUNTY OF WASHTEENAW, MICHIGAN, DESCRIBED AS: LOT 22, RESEARCH PARK, AS RECORDED IN LIBER 15 OF PLATS, PAGES 56 AND 57, WASHTEENAW COUNTY RECORDS.
3850 RESEARCH PARK DRIVE: UNIT 1 RESEARCH PARK HOSPITALITY CONDOMINIUM SPLIT/COMBINED ON 11/06/2018 FROM 09-12-09-301-001
3860 RESEARCH PARK DRIVE: UNIT 2 RESEARCH PARK HOSPITALITY CONDOMINIUM SPLIT/COMBINED ON 11/06/2018 FROM 09-12-09-301-001

ZONING INFORMATION (REZONING FROM RE TO C-2B)
ZONED- REZONED C-2B (BUSINESS SERVICE)
SETBACKS-
FRONT: - 10' MIN / 25' MAX
REAR: - NONE
SIDE: - NONE

UTILITY CONTACTS

ELECTRIC	GAS
DTE ONE ENERGY PLAZA ROOM 518 S.B. DETROIT, MI 48226 (313) 235-5632	DTE ONE ENERGY PLAZA-WC81836 DETROIT, MI 48226 (313) 235-5111

ZONING
CITY OF ANN ARBOR
PLANNING & DEVELOPMENT
100 N FIFTH AVE.
ANN ARBOR, MICHIGAN 48107
(734) 794-6265

WATER/SEWER
CITY OF ANN ARBOR
ENGINEERING DEPT.
301 E. HURON
ANN ARBOR, MICHIGAN 48107
(734) 794-6410

UTILITY NOTE
THE UTILITY LOCATIONS AS HEREON SHOWN ARE BASED ON FIELD OBSERVATIONS AND A CAREFUL REVIEW OF MUNICIPAL AND UTILITY RECORDS. HOWEVER, IT IS NOT POSSIBLE TO DETERMINE THE PRECISE SIZE, LOCATION, DEPTH, PRESSURE, OR ANY OTHER CHARACTERISTICS OF UNDERGROUND UTILITIES, TANKS OR SEPTIC FIELDS WITHOUT EXCAVATION. THEREFORE, WE CANNOT GUARANTEE THE ACCURACY OF COMPLETENESS OF THE BURIED UTILITY INFORMATION HEREON SHOWN. THE CONTRACTOR SHALL CALL MISS DIG (1-800-482-7171) A MINIMUM OF THREE WORKING DAYS PRIOR TO ANY EXCAVATION. IT SHALL BE THE RESPONSIBILITY OF THE CONTRACTOR TO VERIFY THESE UTILITY LOCATIONS PRIOR TO CONSTRUCTION AND MAKE EVERY EFFORT TO PROTECT AND/OR RELOCATE THEM AS REQUIRED. THE CONTRACTOR SHALL NOTIFY THE ENGINEER/SURVEYOR AS SOON AS POSSIBLE IN THE EVENT A DISCREPANCY IS FOUND.

WETLANDS
WETLANDS WERE NOT INDICATED ON NEITHER THE NATIONAL WETLAND INVENTORY MAP NOR MIRS MAPS.

SOIL CONDITIONS
Fd - FILL LAND
OBTAINED FROM USDA (NRCS) "WEB SOIL SURVEY"

SCHEDULE B EXCEPTIONS

- EASEMENT FOR PUBLIC UTILITIES OVER THE SOUTH 12' OF SAID LAND, AS DISCLOSED BY THE RECORDED PLAT. (AS SHOWN).
- EASEMENT IN FAVOR OF DETROIT EDISON COMPANY AND COVENANTS, CONDITIONS AND RESTRICTIONS CONTAINED IN INSTRUMENT RECORDED IN LIBER 2009, PAGE 60. (AS SHOWN) (APPROX.)
- EASEMENT GRANT AND DECLARATION OF RESTRICTIONS AND THE COVENANTS, CONDITIONS AND RESTRICTIONS CONTAINED IN INSTRUMENT RECORDED IN LIBER 1248, PAGE 93, AND RE-RECORDED IN LIBER 1269, PAGE 197. (BLANKET EASEMENT).
- EASEMENT AGREEMENT IN FAVOR OF THE DETROIT EDISON COMPANY AND MICHIGAN BELL TELEPHONE COMPANY AND THE COVENANTS, CONDITIONS AND RESTRICTIONS CONTAINED IN INSTRUMENTS RECORDED IN LIBER 1248, PAGE 504.
- TERMS, CONDITIONS AND PROVISIONS OF UTILITY AGREEMENT RECORDED IN LIBER 935, PAGE 583.
- EASEMENT IN FAVOR OF THE CITY OF ANN ARBOR FOR WATER MAIN CONTAINED IN INSTRUMENT RECORDED IN LIBER 5178, PAGE 780 (AS SHOWN)

BENCHMARKS


B.M. #1 - SET BM ON LIGHT POLE NEAR THE NW COR OF PROPERTY
ELEV. 834.30 NAVD 88

B.M. #2 - SET BM ON TOP OF NE BOLT ON LIGHT POLE BASE ON WEST SIDE OF PROPERTY
ELEV. 835.78 NAVD 88

FLOODPLAIN INFORMATION
CITY OF ANN ARBOR
WASHTEENAW COUNTY, MICHIGAN
MAP NUMBER: 26161C0401E
EFFECTIVE DATE: APRIL 3, 2012
FLOOD ZONE: X
AREA OUTSIDE OF THE 0.2% ANNUAL CHANCE FLOODPLAIN

LEGEND
UNIT LINE

811 logo with text: Know what's below. Call before you dig.
Scale: 1" = 40'

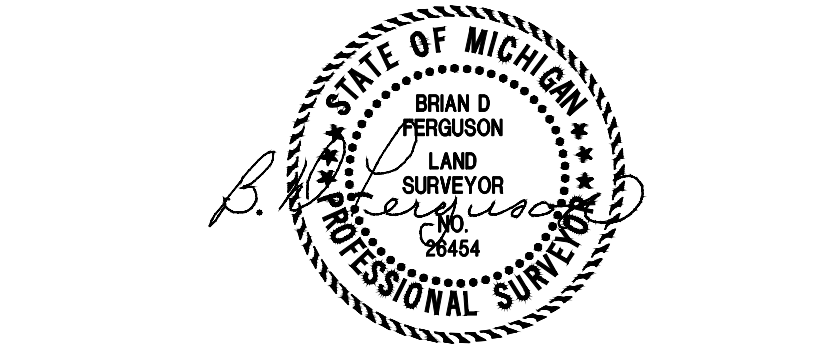

SURVEY PROVIDED BY:
D&M SITE INC.
Surveying • Inspection • Testing • Engineering
401 BALSAM STREET PO BOX 159, CARROLLTON, MICHIGAN 48724
PHONE (989) 752-8500 • FAX (989) 752-6600


THE LOCATION OF ALL UNDERGROUND UTILITIES AS SHOWN ON THESE DRAWINGS ARE BASED ON RECORDS PROVIDED BY THE UTILITY OWNERS AND VISIBLE EVIDENCE OBTAINED IN THE FIELD. NO GUARANTEE IS EITHER EXPRESSED OR IMPLIED TO THE COMPLETENESS OR ACCURACY THEREOF.

ISSUED FOR DATE

SPA	12/20/14
SPA	02/20/15
SPA	03/23/15
SPA	04/23/15
SPA	08/17/15
CONST PLANS	09/05/15
CONST PLANS	10/02/15
CONST PLANS	11/05/15
CONST PLANS	12/09/15
UG DETENTION	03/06/16
SPA	02/28/21

DATE:
DRAWN: ACA
CHECKED:
SCALE: 1"=40'
JOB NO: BD-14-322
SHEET TITLE:
ALTA/NSPS LAND TITLE SURVEY

SHEET
C2.0

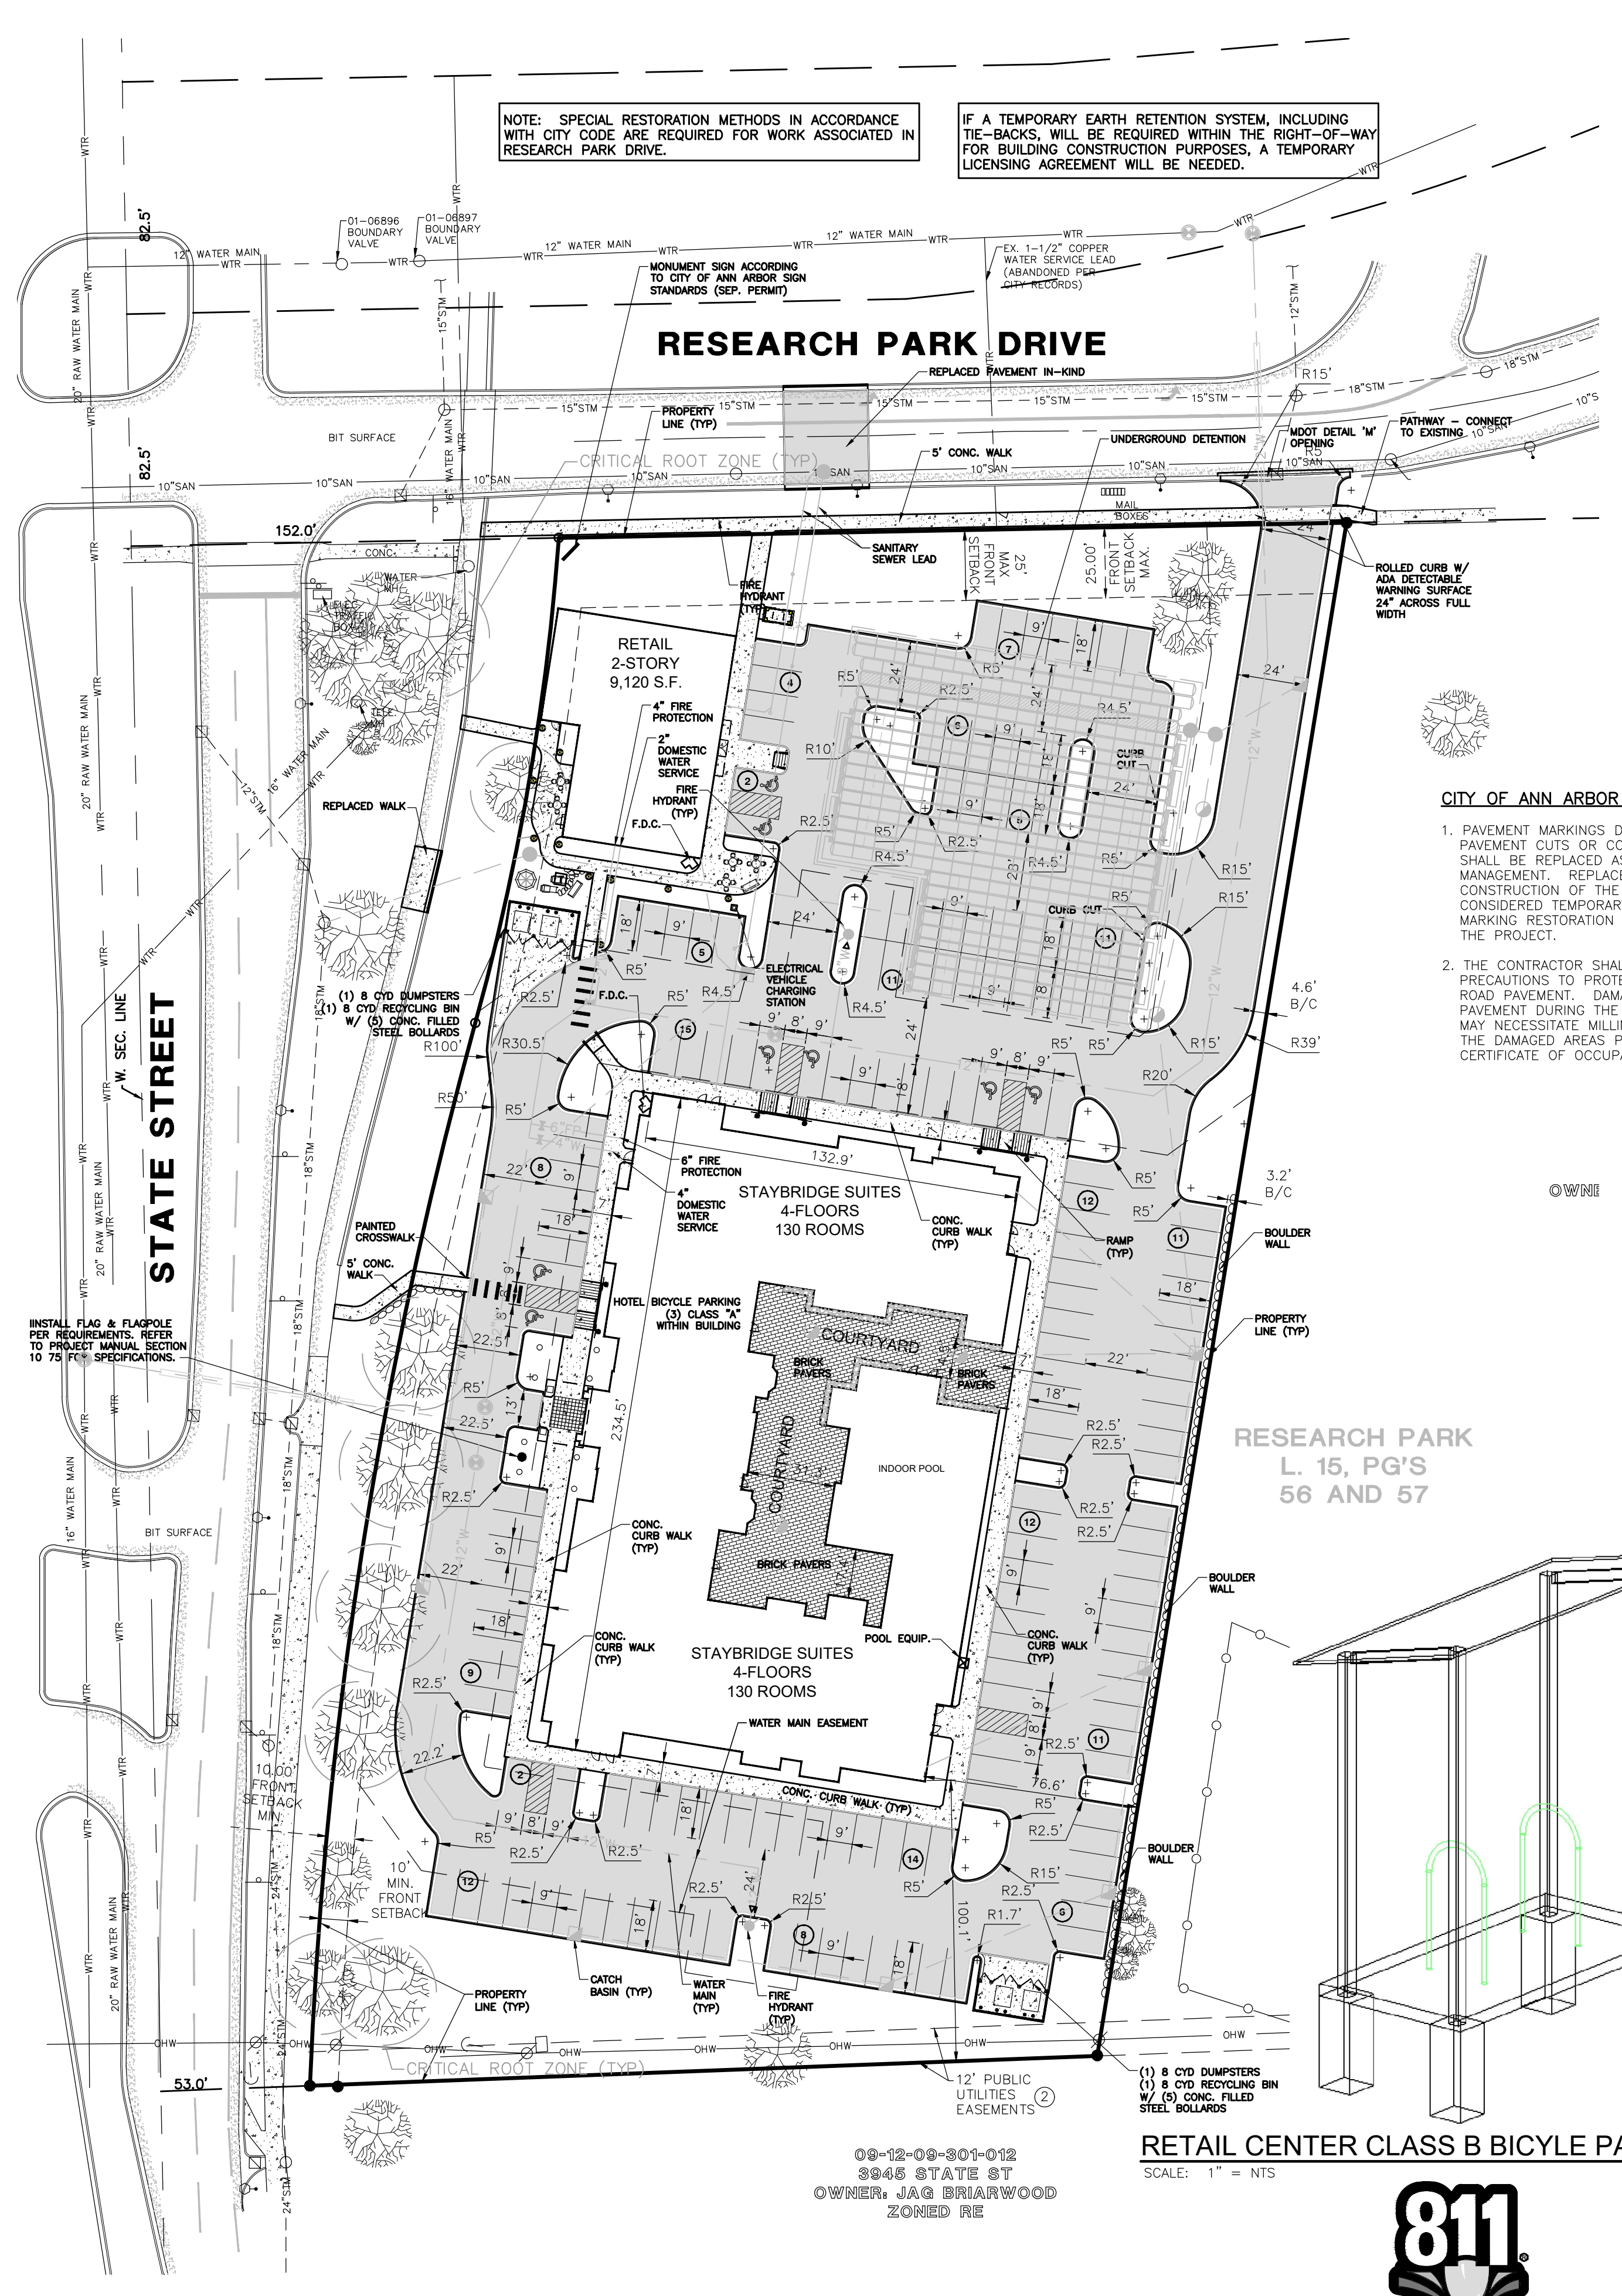

NOTE: SPECIAL RESTORATION METHODS IN ACCORDANCE WITH CITY CODE ARE REQUIRED FOR WORK ASSOCIATED IN RESEARCH PARK DRIVE.

IF A TEMPORARY EARTH RETENTION SYSTEM, INCLUDING TIE-BACKS, WILL BE REQUIRED WITHIN THE RIGHT-OF-WAY FOR BUILDING CONSTRUCTION PURPOSES, A TEMPORARY LICENSING AGREEMENT WILL BE NEEDED.

CITY OF ANN ARBOR CONSTRUCTION NOTES

1. PAVEMENT MARKINGS DISTURBED AS A RESULT OF PAVEMENT CUTS OR CONSTRUCTION ACTIVITIES SHALL BE REPLACED AS DIRECTED BY PROJECT MANAGEMENT. REPLACEMENT DURING CONSTRUCTION OF THE PROJECT MAY BE CONSIDERED TEMPORARY, WITH FINAL PAVEMENT MARKING RESTORATION TO OCCUR AT THE END OF THE PROJECT.
2. THE CONTRACTOR SHALL TAKE ALL NECESSARY PRECAUTIONS TO PROTECT THE EXISTING PUBLIC ROAD PAVEMENT. DAMAGE TO THE PUBLIC ROAD PAVEMENT DURING THE COURSE OF CONSTRUCTION MAY NECESSITATE MILLING AND RESURFACING OF THE DAMAGED AREAS PRIOR TO ISSUANCE OF THE CERTIFICATE OF OCCUPANCY.


GENERAL NOTES

1. IT IS THE CONTRACTOR'S RESPONSIBILITY TO SECURE ALL PERMITS AND POST ALL BONDS PRIOR TO CONSTRUCTION, OR ENSURE THAT ALL REQUIRED PERMITS AND BONDS HAVE BEEN OBTAINED PRIOR TO CONSTRUCTION.
2. THE CONTRACTOR SHALL BE FULLY RESPONSIBLE FOR THE LOCATION AND PROTECTION OF ALL EXISTING UTILITIES. THE CONTRACTOR SHALL VERIFY ALL UTILITY LOCATIONS PRIOR TO CONSTRUCTION BY CALLING MISS-DIG AT 1-800-482-7171 AT LEAST 3 WORKING DAYS PRIOR TO EXCAVATION.
3. THE CONTRACTOR SHALL ASSUME RESPONSIBILITY FOR THE PROTECTION OF ALL EXISTING UTILITIES DURING CONSTRUCTION. ALL UTILITIES DAMAGED DURING CONSTRUCTION SHALL BE REPAIRED WITH LIKE MATERIAL. THE EXACT LOCATION OF EXISTING UTILITIES SHALL BE LOCATED BY HAND DIGGING.
4. DIMENSIONS ARE TO FACE OF CURB, OUTSIDE FACE OF BUILDING, EDGE OF PAVEMENT, CENTER OF STRUCTURE OR OTHERWISE INDICATED.
5. ALL PAVING MATERIALS AND OPERATIONS SHALL BE IN CONFORMANCE WITH THE CITY OF ANN ARBOR STANDARD SPECIFICATIONS FOR CONSTRUCTION.
6. PARKING STALL SPACES TO BE 4" SOLID WHITE PAINT STRIPES. HANDICAP PARKING TO BE 4" SOLID BLUE PAINT STRIPES W/ BARRIER FREE STRIPPING TO BE 4" SOLID BLUE @ 2" O.C. ON 45° ANGLE.
7. ALL WORK WITHIN THE RIGHT OF WAY SHALL BE CONDUCTED IN ACCORDANCE WITH THE REQUIREMENTS OF THE CITY OF ANN ARBOR.
8. SPECIAL RESTORATION METHODS IN ACCORDANCE WITH CITY CODE ARE REQUIRED FOR WORK ASSOCIATED IN RESEARCH PARK DRIVE.
9. IF A TEMPORARY EARTH RETENTION SYSTEM, INCLUDING TIE-BACKS, WILL BE REQUIRED WITHIN THE RIGHT-OF-WAY FOR BUILDING CONSTRUCTION PURPOSES, A TEMPORARY LICENSING AGREEMENT WILL BE NEEDED.


CITY OF ANN ARBOR SIDEWALK REPAIR AND MAINTENANCE NOTE

SIDEWALK REPAIR AND MAINTENANCE NOTE: ALL SIDEWALKS ARE TO BE KEPT AND MAINTAINED IN GOOD REPAIR BY THE OWNER OF THE LAND ADJACENT TO AND ABUTTING THE SAME. PRIOR TO THE ISSUANCE OF THE FINAL CERTIFICATE OF OCCUPANCY FOR THIS SITE, ALL EXISTING SIDEWALKS IN NEED OF REPAIR MUST BE REPAIRED IN ACCORDANCE WITH CITY STANDARDS.

PAVEMENT INFORMATION

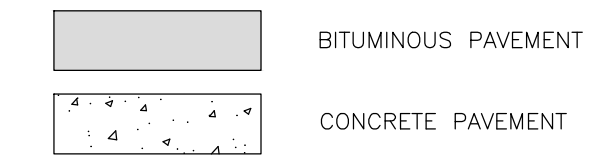

811
Know what's below.
Call before you dig.

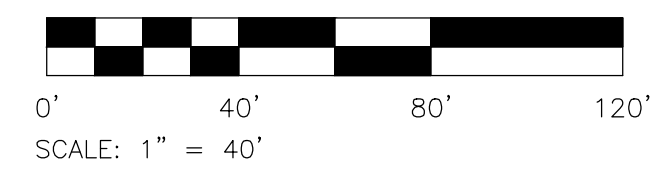

THE LOCATION OF ALL UNDERGROUND UTILITIES AS SHOWN ON THESE DRAWINGS ARE BASED ON RECORDS PROVIDED BY THE UTILITY OWNERS AND VISIBLE EVIDENCE OBTAINED IN THE FIELD. NO GUARANTEE IS EITHER EXPRESSED OR IMPLIED TO THE COMPLETENESS OR ACCURACY THEREOF.

STELLAR DEVELOPMENT, LLC

2600 AUBURN ROAD, SUITE 140
AUBURN HILLS, MI 48326
PH 810-444-7815
FX 248-553-4218

PREPARED UNDER THE DIRECTION OF:
ANDREW ANDRE, P.E.
MI #47380

APPLICANT:
STELLAR HOSPITALITY ANN ARBOR, LLC
2600 AUBURN ROAD, SUITE 240
AUBURN HILLS, MI 48326
PH 248-419-5551

STAYBRIDGE SUITES & RETAIL CENTER

3850 RESEARCH PARK DRIVE

ANN ARBOR, MI 48108

THE INFORMATION CONTAINED HEREIN IS THE PROPERTY OF STELLAR DEVELOPMENT, LLC. IT IS TO BE USED ONLY FOR THE PROJECT AND SITE SPECIFICALLY IDENTIFIED HEREIN. NO PART OF THIS DOCUMENT IS TO BE REPRODUCED, COPIED, OR TRANSMITTED IN ANY FORM OR BY ANY MEANS, ELECTRONIC OR MECHANICAL, INCLUDING PHOTOCOPYING, RECORDING, OR BY ANY INFORMATION STORAGE AND RETRIEVAL SYSTEM, WITHOUT THE WRITTEN PERMISSION OF STELLAR DEVELOPMENT, LLC. THE INFORMATION CONTAINED HEREIN IS PROVIDED AS IS, WITHOUT WARRANTY OF ANY KIND, EXPRESS OR IMPLIED, INCLUDING BUT NOT LIMITED TO THE WARRANTIES OF MERCHANTABILITY, FITNESS FOR A PARTICULAR PURPOSE, AND NONINFRINGEMENT. THE USER ASSUMES ALL LIABILITY FOR ANY DAMAGE OR LOSS OF PROFITS, BUSINESS, OR REPUTATION, OR FOR ANY OTHER DAMAGES, INCLUDING REASONABLE ATTORNEY'S FEES, ARISING FROM THE USE OF THIS INFORMATION.

© 2023 STELLAR DEVELOPMENT, LLC

ISSUED FOR	DATE
SPA	12/29/14
SPA	02/20/15
SPA	02/20/15
SPA	03/23/15
SPA	04/23/15
PERMITS	05/12/15
SPA	08/17/15
CONST PLANS	09/05/15
CONST PLANS	10/02/15
CONST PLANS	11/05/15
ING REVIEW	11/20/15
CONST PLANS	12/09/15
UG DETENTION	03/06/16
SPA	01/21/21
SPA	02/28/21

DATE: _____
DRAWN: ACA
CHECKED: _____
SCALE: 1"=40'
JOB NO: BD-14-322

SHEET LAYOUT AND PAVING PLAN

SHEET
C3.0

PLANNED PROJECT MODIFICATIONS**
1) FRONT SETBACK TO 0.6 FEET IN ORDER TO BRING RETAIL BUILDING CLOSER TO STATE STREET. INCREASED RIGHT-OF-WAY ALONG STATE STREET AT RESEARCH PARK DRIVE PROVIDES FOR NATURAL SETBACK FROM THE ROADWAY.




Appendix 1
Stormceptor Design Summary
STORMTECH VOLUME CALCULATIONS
Project Information Rainfall

Project: **STAYBRIDGE SUITES**

Chamber Model -
Units -

SC-740
Imperial
367
373
30
829.14
12
6
14361

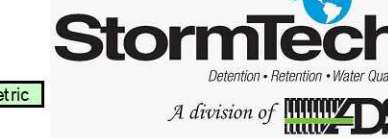

Number of chambers -
Voids in the stone (porosity) -
Base of Stone Elevation -
Amount of Stone Above Chambers -
Amount of Stone Below Chambers -
Area of system -

Include Perimeter Stone in Calculations
sf Min. Area - 12609 sf min. area

StormTech SC-740 Cumulative Storage Volumes

Height of System (inches)	Incremental Single Chamber (cubic feet)	Incremental Total Chamber (cubic feet)	Incremental Stone (cubic feet)	Incremental Ch & St (cubic feet)	Cumulative Chamber (cubic feet)	Elevation (feet)
48	0.00	0.00	359.03	359.03	29230.97	833.14
47	0.00	0.00	359.03	359.03	28871.94	833.06
46	0.00	0.00	359.03	359.03	28512.92	832.97
45	0.00	0.00	359.03	359.03	28153.89	832.89
44	0.00	0.00	359.03	359.03	27794.87	832.81
43	0.00	0.00	359.03	359.03	27435.84	832.72
42	0.00	0.00	359.03	359.03	27076.82	832.64
41	0.00	0.00	359.03	359.03	26717.79	832.56
40	0.00	0.00	359.03	359.03	26358.77	832.47
39	0.00	0.00	359.03	359.03	25999.74	832.39
38	0.00	0.00	359.03	359.03	25640.72	832.31
37	0.00	0.00	359.03	359.03	25281.69	832.22
36	0.05	20.51	352.87	373.38	24922.67	832.14
35	0.16	60.77	340.79	401.56	24563.64	832.06
34	0.28	105.16	327.48	432.64	24204.62	831.97
33	0.60	225.28	291.44	516.72	23845.59	831.89
32	0.80	299.04	269.31	568.35	23486.57	831.81
31	0.95	354.60	252.64	607.25	23127.54	831.72
30	1.07	400.79	238.79	639.58	22768.52	831.64
29	1.18	440.32	226.93	667.25	22409.49	831.56
28	1.27	472.09	217.40	689.49	22050.47	831.47
27	1.36	505.42	207.40	712.82	21691.44	831.39
26	1.45	542.38	196.31	738.69	21332.42	831.31
25	1.52	588.72	188.41	757.13	20973.40	831.22
24	1.58	640.21	181.96	772.17	20614.37	831.14
23	1.64	692.57	175.25	787.82	20255.35	831.06
22	1.70	745.92	168.85	802.77	19896.32	830.97
21	1.75	800.38	162.87	816.71	19537.30	830.89
20	1.80	854.84	157.29	829.74	19178.27	830.81
19	1.85	909.30	151.45	843.37	18819.25	830.72
18	1.89	963.76	147.19	853.31	18460.22	830.64
17	1.93	1018.22	142.61	863.99	18101.20	830.56
16	1.97	1072.68	138.02	874.70	17742.17	830.47
15	2.01	1127.14	134.11	883.82	17383.15	830.39
14	2.04	1181.60	130.19	892.97	17024.12	830.31
13	2.07	1236.06	126.84	900.80	16665.10	830.22
12	2.10	1290.52	123.49	908.62	16306.07	830.14
11	2.13	1344.98	120.48	915.64	15947.05	830.06
10	2.15	1399.44	118.01	921.40	15588.02	829.97
9	2.18	1453.90	115.41	927.46	15229.00	829.89
8	2.20	1508.36	113.03	933.02	14870.00	829.81
7	2.21	1562.82	112.03	935.36	14511.00	829.72
6	0.00	0.00	359.03	359.03	14152.00	829.64
5	0.00	0.00	359.03	359.03	13793.00	829.56
4	0.00	0.00	359.03	359.03	13434.00	829.47
3	0.00	0.00	359.03	359.03	13075.00	829.39
2	0.00	0.00	359.03	359.03	12716.00	829.31
1	0.00	0.00	359.03	359.03	12357.00	829.22


AS-BUILT INFORMATION (03/23/2017)

Event	A.B. Elev	A.B. Vol (c.f.)
First Flush:	830.41	10583
Bankfull:	831.47	20716
100-Year:	832.90	28197

STORM SEWER CALCULATIONS

$Q_R = C \cdot I \cdot A$
 $Q_P = A \times 1.486 \cdot m \times R^{2.48} \times S^{0.58}$
 $I = 170 / (23 + L_e)$ for 10 year storm event

AREA NO.	FROM MH/CB	TO MH/CB	AREA A	COEFF. C*	A x C	AREA TOTAL AT	COEFF. Wt	A1 x Cw	TIME t _c	INT. I	n	FLOW Q _a	PIPE CAP. Q _p	PIPE DIA.	PIPE LENGTH	PIPE SLOPE	VEL. FULL	TIME FLOW	RIM ELEV HIGH	RIM ELEV LOW	H.G.L. 10-YEAR END HGL	INVERT ELEV. END INV	HIGH END HGL	LOW END HGL	HIGH END INV	LOW END INV
DA1	1	2	0.19	0.74	0.14	0.19	0.74	0.14	15.00	4.38	0.013	0.61	2.02	12	140	0.32%	2.57	0.91	834.60	834.60	834.25	833.67	832.43	831.98		
DA2	2	14	0.23	0.76	0.17	0.42	0.75	0.31	15.91	4.37	0.013	1.37	2.04	12	122	0.33%	2.60	0.78	834.60	834.80	833.57	833.06	831.88	831.48		
DA13	14	DET	0.20	0.78	0.15	0.61	0.76	0.47	16.69	4.28	0.013	2.00	6.32	12	55	3.15%	8.05	0.11	834.80	837.00	833.06	831.18	831.48	829.75		
DA3	3	4	0.19	0.88	0.17	0.19	0.88	0.17	15.00	4.38	0.013	0.74	2.02	12	112	0.32%	2.57	0.73	834.30	834.30	834.27	833.81	832.13	831.77		
DA4	4	5	0.15	0.88	0.14	0.34	0.88	0.30	15.73	4.39	0.013	1.33	2.02	12	84	0.32%	2.57	0.55	834.30	834.65	833.71	833.36	831.67	831.40		
DA5	5	6	0.05	0.87	0.05	0.40	0.88	0.35	16.27	4.33	0.013	1.51	2.02	12	80	0.32%	2.57	0.52	834.65	834.25	833.26	832.94	831.30	831.05		
DA6	6	10	0.52	0.93	0.49	0.92	0.91	0.84	16.79	4.27	0.013	3.58	3.80	15	114	0.31%	2.93	0.65	834.25	834.25	832.84	832.40	830.95	830.59		
DA7	7	8	0.05	0.95	0.05	0.05	0.95	0.05	15.00	4.38	0.013	0.23	2.02	12	70	0.32%	2.57	0.45	835.50	835.50	833.75	833.17	831.66	831.44		
DA8	8	9	0.04	0.95	0.04	0.10	0.95	0.09	15.45	4.42	0.013	0.41	2.02	12	55	0.32%	2.57	0.36	835.50	835.50	833.07	832.85	831.34	831.16		
DA9	9	10	0.03	0.95	0.03	0.13	0.95	0.12	15.81	4.38	0.013	0.52	2.02	12	83	0.32%	2.57	0.54	835.50	834.25	832.75	832.40	831.06	830.79		
DA10	10	11	0.45	0.92	0.41	1.49	0.92	1.37	17.44	4.20	0.013	5.75	5.75	18	121	0.30%	3.26	0.62	834.25	833.60	832.00	831.58	830.39	830.03		
DA11	11	13	0.51	0.91	0.46	2.00	0.91	1.83	18.06	4.14	0.013	7.57	8.76	24	75	0.15%	2.79	0.45	833.60	834.00	831.38	831.25	829.83	829.72		
DA13	13	17	0.23	0.91	0.21	2.23	0.91	2.03	18.51	4.10	0.013	8.33	8.76	24	27	0.15%	2.79	0.16	834.00	834.10	831.25	831.20	829.72	829.68		
DA12	12	17	0.23	0.91	0.21	0.23	0.91	0.21	15.00	4.38	0.013	0.91	2.02	12	35	0.32%	2.57	0.23	833.85	834.10	832.15	832.00	830.59	830.48		
---	17	18	0.00	0.00	0.00	2.45	0.91	2.24	18.67	4.08	0.013	9.14	11.54	24	9	0.26%	3.67	0.04	834.10	834.67	831.20	831.18	829.68	829.65		

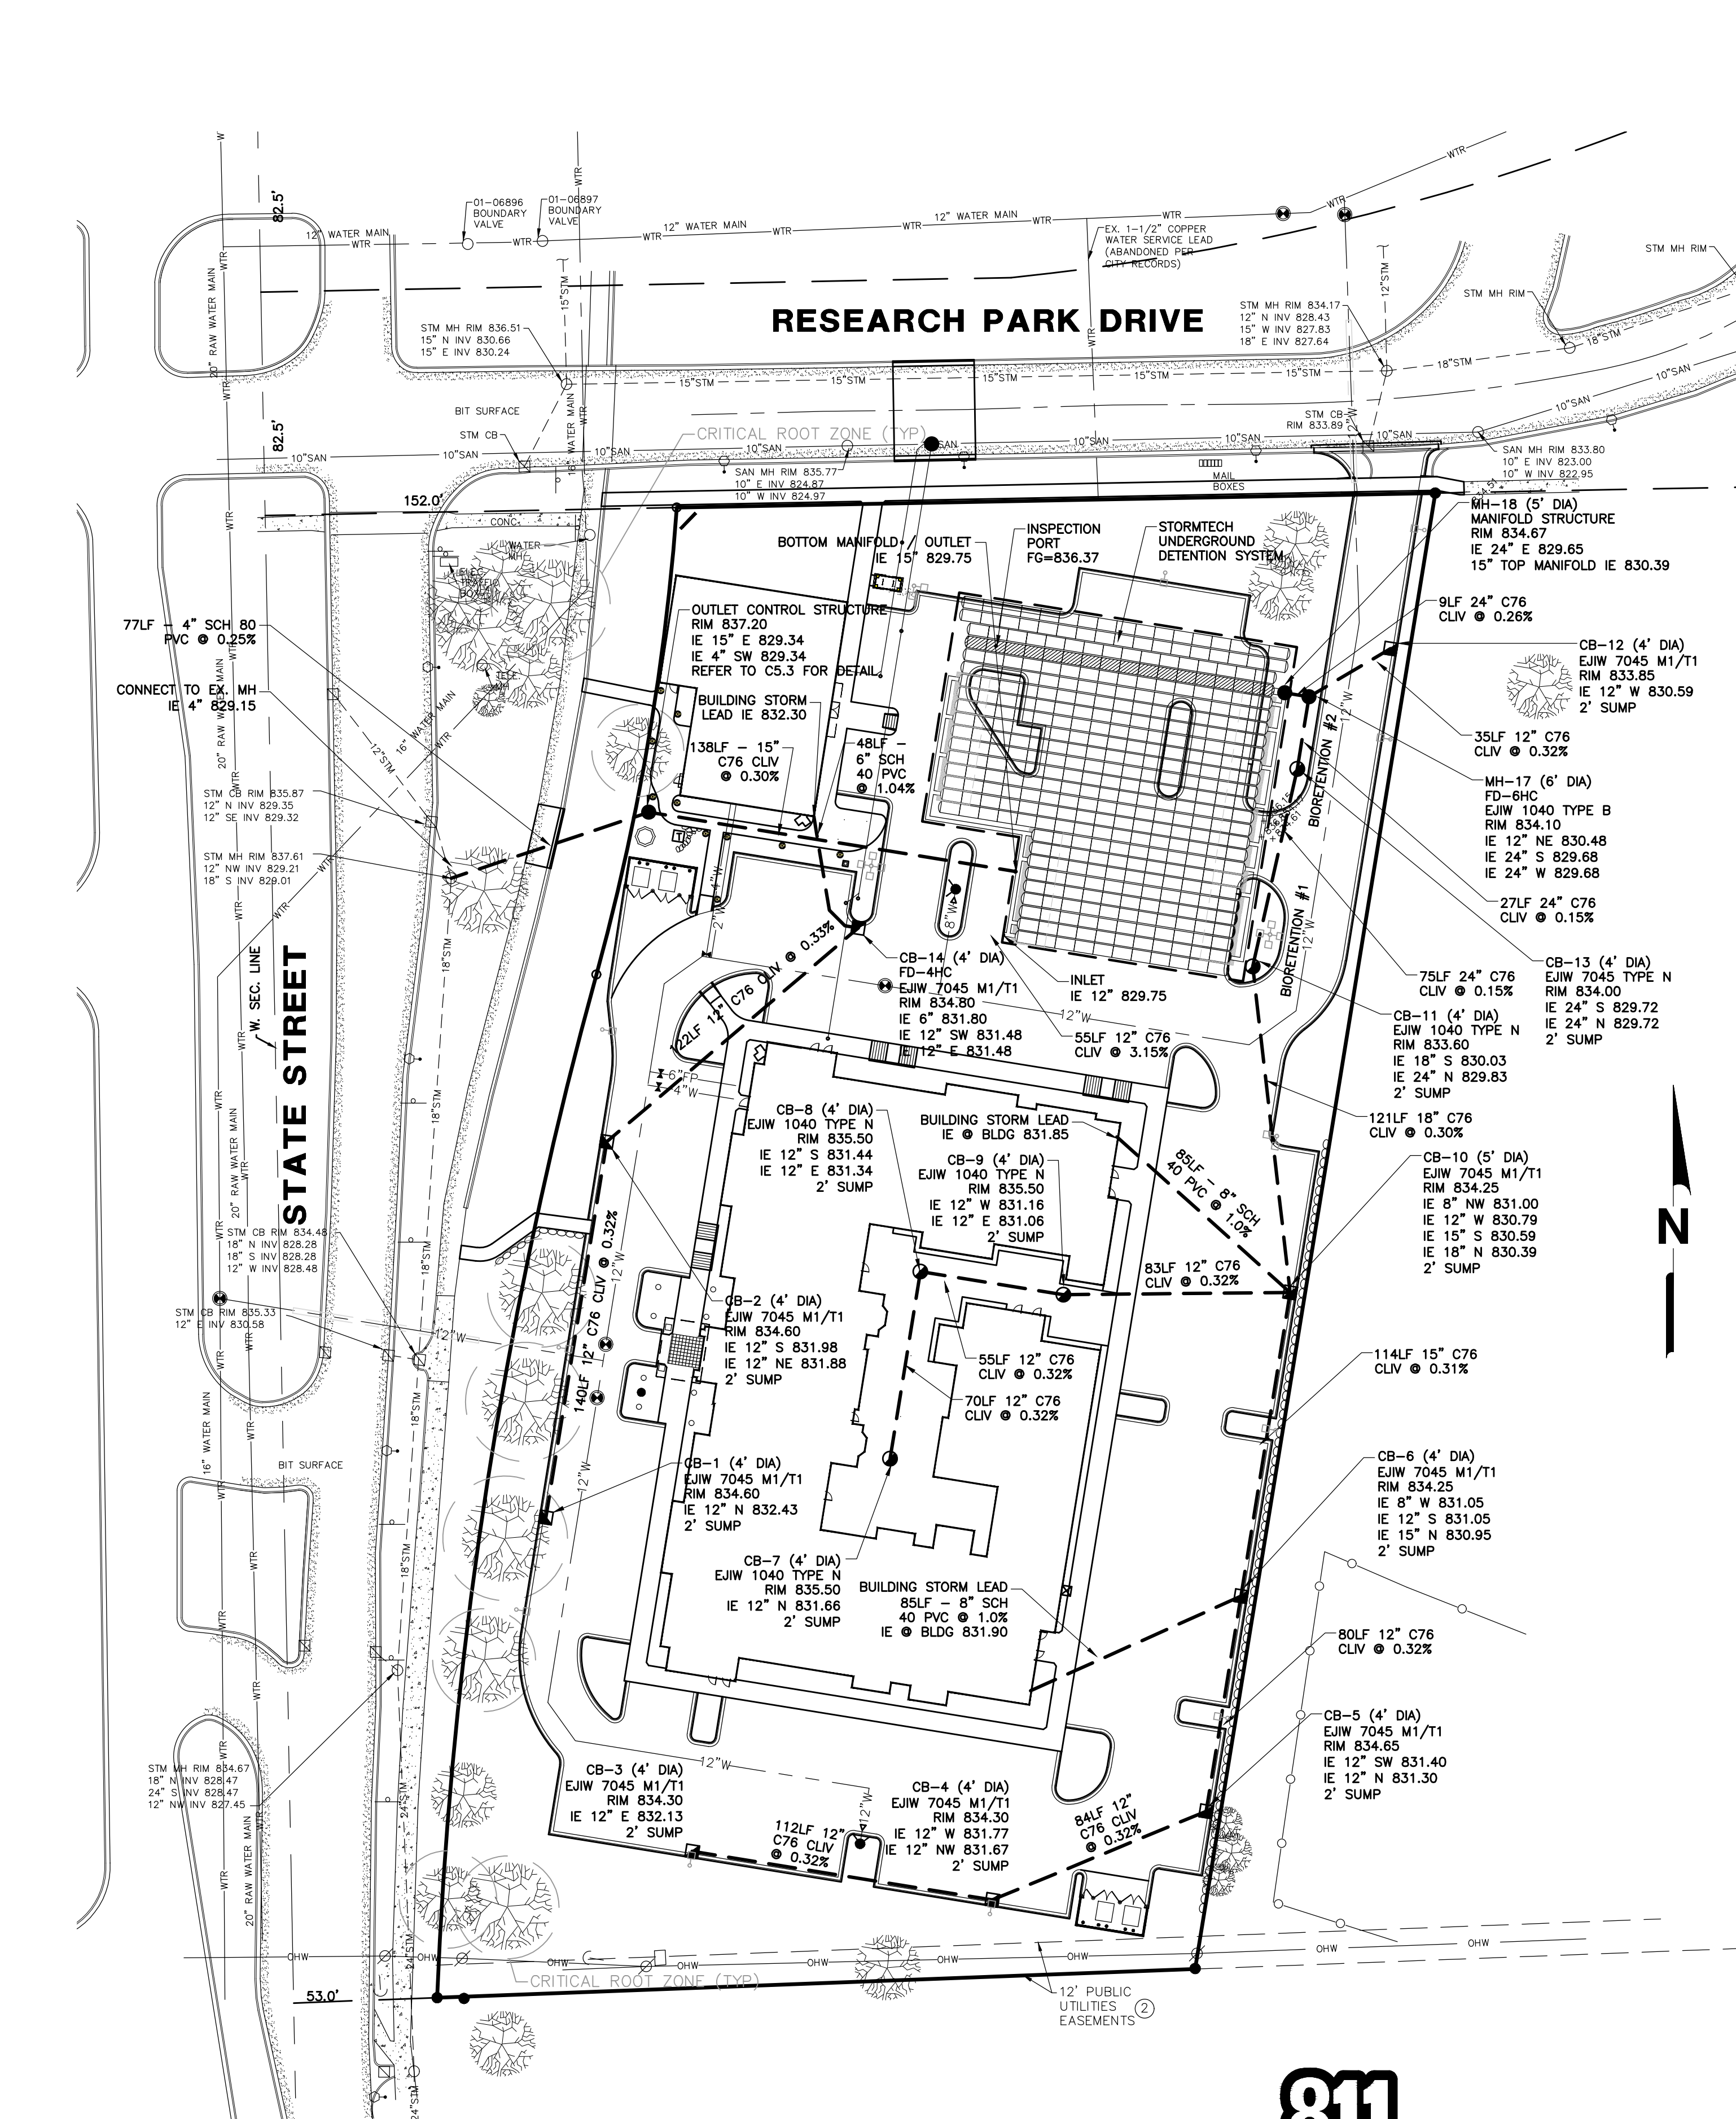

UTILITY CONTACTS

ELECTRIC DTE ONE ENERGY PLAZA ROOM 518 S.B. DETROIT, MI 48226 (313) 235-5632	GAS DTE ONE ENERGY PLAZA-WC81836 DETROIT, MI 48226 (313) 235-5111	WATER/SEWER CITY OF ANN ARBOR PLANNING & DEVELOPMENT 100 N FIFTH AVE. ANN ARBOR, MICHIGAN 48107 (734) 794-6265	WATER/SEWER CITY OF ANN ARBOR ENGINEERING DEPT. 301 E. HURON ANN ARBOR, MICHIGAN 48107 (734) 794-6410
--	--	--	---

811
Know what's below.
Call before you dig.

SCALE: 1" = 40'

THE LOCATION OF ALL UNDERGROUND UTILITIES AS SHOWN ON THESE DRAWINGS ARE BASED ON RECORDS PROVIDED BY THE UTILITY OWNERS AND VISIBLE EVIDENCE OBTAINED IN THE FIELD. NO GUARANTEE IS EITHER EXPRESSED OR IMPLIED TO THE COMPLETENESS OR ACCURACY THEREOF.

- UTILITY NOTES**
- ALL WORK MUST BE DONE IN ACCORDANCE WITH CURRENT STANDARDS, SPECIFICATIONS AND GENERAL CONDITIONS OF THE CITY OF ANN ARBOR.
 - SHOP DRAWINGS SHALL BE SUBMITTED BY THE UNDERGROUND CONTRACTOR FOR ALL WATER, SANITARY AND STORM INSTALLATION.
 - CONTRACTOR SHALL SUBMIT RECORD "AS-BUILT" PLANS AFTER CONSTRUCTION.
 - MAINTAIN A MINIMUM HORIZONTAL SEPARATION BETWEEN WATER SERVICE AND ANY OTHER UTILITY OF 10'-FEET. THE MINIMUM VERTICAL CLEARANCE BETWEEN A WATER MAIN AND A SEWER SHALL BE 18"-INCHES.
 - NO GROUNDWATER, STORM WATER, CONSTRUCTION WATER, DOWNSPOUT DRAINAGE OR WEEP TILE DRAINAGE SHALL BE ALLOWED TO ENTER ANY SANITARY SEWER INSTALLATION.
 - REFER TO PLUMBING PLANS TO VERIFY BUILDING UTILITY CONNECTION LOCATIONS. SITE UTILITY LOCATIONS TO TERMINATE 5' OUTSIDE OF BUILDING.
 - SANITARY CLEANOUT ASSEMBLIES TO BE ZURN 1402-HD, OR OTHERWISE APPROVED EQUAL.
 - THE LOCATION AND SIZE OF THE FRANCHISE UTILITY SERVICES SHALL BE DESIGNED AND INSTALLED BY THE UTILITY COMPANY.
 - MAINTAIN 5.5' MIN. DEPTH OF BURY TO FINISHED GRADE FOR WATER SERVICE.
 - ALL UTILITIES TO BE REMOVED SHALL BE DONE IN ACCORDANCE WITH THE APPLICABLE ENVIRONMENTAL AND/OR REGULATORY REQUIREMENTS.
 - CONTRACTOR SHALL FIELD VERIFY THE LOCATION AND ELEVATION OF EXISTING UTILITIES PRIOR TO CONNECTION AND REPORT ALL FINDINGS TO THE ENGINEER.

- PERMANENT POST-CONSTRUCTION BMPs**
- BIORETENTION AREAS WITHIN THE PROPOSED PARKING AREAS TO PROMOTE INFILTRATION AND REDUCE RUNOFF.
 - STORM WATER QUALITY DEVICE TO REMOVE POINT SOURCE POLLUTANTS FROM STORM SEWER SYSTEM.
 - UNDERGROUND DETENTION SYSTEM WITH OPEN BOTTOM THAT PROMOTES INFILTRATION, PROVIDE FLOOD CONTROL, AND IMPROVE WATER QUALITY OF SITE STORM DISCHARGE.


DRAINAGE AREAS

Drainage Area	Area Total (S.F.)	Pervious Area (S.F.)	Pavement Area (S.F.)	Roof Area (S.F.)	C Perv	C Pavement	C Roof	Area Total (acres)	Cw				
										DA1	DA2	DA3	DA4
DA1	8203.05	2687.07	5335.13	180.85	0.30	0.95	0.95	0.19	0.74				
DA2	9981.00	2908.53	6891.62	180.85	0.30	0.95	0.95	0.23	0.76				
DA3	8272.35	827.99	7444.36	0	0.30	0.95	0.95	0.19	0.88				
DA4	6708.56	744.4	5964.16	0	0.30	0.95	0.95	0.15	0.88				
DA5	2305.3	280.47	2024.83	0	0.30	0.95	0.95	0.05	0.87				
DA6	22789.93	634.38	7329.35	14826.2	0.30	0.95	0.95	0.52	0.93				
DA7	2376.74	0.00	2376.74	0	0.30	0.95	0.95	0.05	0.95				
DA8	1877.87	0.00	1877.87	0	0.30	0.95	0.95	0.04	0.95				
DA9	1197.93	0.00	1197.93	0	0.30	0.95	0.95	0.03	0.95				
DA10	19507.14	845.62	7682.41	10979.11	0.30	0.95	0.95	0.45	0.92				
DA11	22071.56	1515.76	15995.80	4560.00	0.30	0.95	0.95	0.51	0.91				
DA12	6119.52	2424.64	3694.88	0.00	0.30	0.95	0.95	0.14	0.69				
DA13	9658.99	534.10	9324.89	0.00	0.30	0.95	0.95	0.23	0.91				
DA14	8544.72	2177.88	6366.84	0.00	0.30	0.95	0.95	0.20	0.78				
TOTAL SITE	155348.72	41114.9	83506.81	30727.01	0.30	0.95	0.95	3.57	0.78				

Drainage Area	Area Total (S.F.)	Pervious Area (S.F.)	Pavement Area (S.F.)	Roof Area (S.F.)	C Perv	C Pavement	C Roof	Area Total (acres)	Cw
TOTAL SITE	155348.72	41114.9	83506.81	30727.01	0.30	0.95	0.95	3.57	0.78

STELLAR DEVELOPMENT, LLC

2600 AUBURN ROAD, SUITE 140
AUBURN H

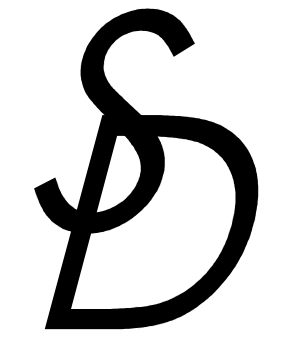

STELLAR DEVELOPMENT, LLC

2600 AUBURN ROAD, SUITE 140
AUBURN HILLS, MI 48326
PH 810-444-7815
FX 248-553-4218

PREPARED UNDER THE DIRECTION OF:
ANDREW ANDRE, P.E.
MI #47380

APPLICANT:
STELLAR HOSPITALITY ANN ARBOR, LLC
2600 AUBURN ROAD, SUITE 240
AUBURN HILLS, MI 48326
PH 248-419-5551

STAYBRIDGE SUITES & RETAIL CENTER
3850 RESEARCH PARK DRIVE
ANN ARBOR, MI 48108

THIS DRAWING IS THE PROPERTY OF STELLAR DEVELOPMENT, LLC. IT IS TO BE USED ONLY FOR THE PROJECT AND SITE SPECIFICALLY IDENTIFIED HEREIN. ANY REUSE OR MODIFICATION OF THIS DRAWING WITHOUT THE WRITTEN CONSENT OF STELLAR DEVELOPMENT, LLC IS STRICTLY PROHIBITED. THE USER ASSUMES ALL LIABILITY FOR ANY ERRORS OR OMISSIONS. THE USER SHALL BE RESPONSIBLE FOR OBTAINING ALL NECESSARY PERMITS AND APPROVALS FROM THE APPROPRIATE AGENCIES. THE USER SHALL BE RESPONSIBLE FOR OBTAINING ALL NECESSARY PERMITS AND APPROVALS FROM THE APPROPRIATE AGENCIES. THE USER SHALL BE RESPONSIBLE FOR OBTAINING ALL NECESSARY PERMITS AND APPROVALS FROM THE APPROPRIATE AGENCIES.

ISSUED FOR	DATE
SPA	12/20/14
SPA	02/20/15
SPA	03/23/15
SPA	04/23/15
PERMITS	06/12/15
SPA	08/17/15
CONST PLANS	09/05/15
CONST PLANS	10/02/15
CONST PLANS	11/05/15
CONST PLANS	12/09/15
STORM REVISION	01/15/16
UD DETENTION	03/08/16
STORM-COURTYARD	06/22/20
SPA	01/21/21
SPA	02/28/21

DATE: _____
 DRAWN: ACA
 CHECKED: _____
 SCALE: 1"=40'
 JOB NO: BD-14-322
 SHEET TITLE:
STORM MANAGEMENT PLAN
 SHEET
C5.2

BIORETENTION #1

Design Basis: Use the Washtenaw County Water Resource Commissioner Design Criteria for Infiltration Bed

- I. Total Volume of Detention Area: 100-Year Storm Event**
- Developed area contributing runoff (a) = 0.51 acres
 - Developed Runoff Coefficient (c) = 0.91
 - Maximum Allowable Runoff, Qa = (0.15 cfs / acre) * a = 0.08 cfs
 - Calculate Qo = Qa / (a * c) = 0.17 cfs/acre imperv.
 - Maximum outflow per acre impervious = 0.17 cfs/acre imperv.
 - Maximum storage time T = -25*(10312.5/Qo)^.5 = 224.5 minutes
 - Maximum storage required Vs = ((16500 * T) / (T + 25)) - 40QoT = 13,359 cf / acre imperv.
 - Total storage required Vt = Vs * a * c = 6,128 cf

- II. Required Sediment Volume**
 Store 5% of the 100-year storm = 306 cf

- III. Bioretention Storage Volume**
 Bioretention Volume = Surface Storage Volume + Soil Storage Volume + Infiltration Volume
 Bioretention Volume = 550 cf

ELEV	AREA (ft ²)	AVG.	VOLUME (ft ³)
833.0	0.00	15.81	0.00
833.1	31.61	34.04	7.90
833.2	36.46	46.15	24.92
833.3	55.84	63.12	48.00
833.4	70.39	79.39	79.55
833.5	88.39	99.38	119.25
833.6	110.37	168.94	

Soil Storage Volume

Area: = 82.8 sf
 Depth: = 4 ft
 Void Ratio of Storage Material: = 30%
 Soil Storage Volume: = 99.3 cf

Infiltration Volume
 Bed Area Bottom: = 182 s.f.
 Infiltration Design Rate: = 3.1 in/hour
 Infiltration Period: = 6 hours
 Infiltration Volume: = 282 cf

BIORETENTION #2

Design Basis: Use the Washtenaw County Water Resource Commissioner Design Criteria for Infiltration Bed

- I. Total Volume of Detention Area: 100-Year Storm Event**
- Developed area contributing runoff (a) = 0.23 acres
 - Developed Runoff Coefficient (c) = 0.91
 - Maximum Allowable Runoff, Qa = (0.15 cfs / acre) * a = 0.03 cfs
 - Calculate Qo = Qa / (a * c) = 0.16 cfs/acre imperv.
 - Maximum outflow per acre impervious = 0.16 cfs/acre imperv.
 - Maximum storage time T = -25*(10312.5/Qo)^.5 = 225.8 minutes
 - Maximum storage required Vs = ((16500 * T) / (T + 25)) - 40QoT = 13,374 cf / acre imperv.
 - Total storage required Vt = Vs * a * c = 2,769 cf

- II. Required Sediment Volume**
 Store 5% of the 100-year storm = 138 cf

- III. Bioretention Storage Volume**
 Bioretention Volume = Surface Storage Volume + Soil Storage Volume + Infiltration Volume
 Bioretention Volume = 209 cf

ELEV	AREA (ft ²)	AVG.	VOLUME (ft ³)
833.4	0.00	21.54	0.00
833.5	43.07	110.30	10.77
833.6	177.52	217.96	65.92
833.7	258.40	290.59	174.90
833.8	322.78	349.05	320.19
833.9	375.32	404.24	494.72
834.0	427.15	695.33	

Soil Storage Volume

Area: = 320.4 sf
 Depth: = 4 ft
 Void Ratio of Storage Material: = 30%
 Soil Storage Volume: = 384.4 cf

Infiltration Volume
 Bed Area Bottom: = 135 s.f.
 Infiltration Design Rate: = 3.1 in/hour
 Infiltration Period: = 6 hours
 Infiltration Volume: = 209 cf

DETENTION CALCULATIONS

Infiltration Bed

Surface Area Factor (SAF) = 15
 Minimum Surface Area (Contributing Imp Area / SAF) = 7,616 s.f.
 Bed Bottom Area: = 14,361 s.f.
 Infiltration Design Rate: = 3.1 in/hour
 Storage Volume (0.5-inch over the entire drainage area): = 6,473 cf
 Calculated depth of storage: = 0.45 ft
 Infiltration Period: = 6 hours
 Infiltration Volume: = 22,224 cf

Underground Detention System

StormTech SC-740 Chambers
 (373) StormTech SC-740 Chambers
 (52) StormTech SC-740 End Caps
 Installed with 12" Cover Stone, 6" Base Stone, 30% Stone Void

StormTech Volume = 29,230 cf

	RECORD	DESIGN	AS-BUILT
Bottom of StormTech (Xo) =	829.14	830.34	830.34
Elevation First Flush (Xff) =	830.34	831.46	831.46
Elevation Bankfull Flood (Xbf) =	831.46	832.58	832.58
Elevation 100-Year (X100) =	832.58	833.70	833.70
Top of StormTech Chamber =	832.14	833.26	833.26

Outlet Control Structure

- Flow restrictor wall
- Flow restrictor wall outlet sizing for "First Flush" runoff
 $Qff = Vff / 24 \text{ hours} / 3600 \text{ sec} = 0.117 \text{ cfs}$
 $h = 2/3 (Xff - Xo) = 0.80 \text{ ft}$
 $A = Qff / 0.62 * (2 * 32.2 * h)^.5 = 0.026 \text{ sf}$
 Diameter of first flush orifice = 1.5 inches
 Area of first flush orifice = 0.012 sf
 Number of orifice holes = 2 @ Elev = 829.14
 RECORD = 2 @ Elev = 829.16

- Flow restrictor wall outlet sizing for "Bankfull Flood" runoff
 Bankfull flood should be discharged within 36 to 48 hours
 Release from first flush holes only
 $Q = A * 0.62 * (2 * 32.2 * 2/3 h)^.5 = 0.16 \text{ cfs}$
 $Tff \text{ new} = 17 \text{ hours}$
 The volume between Bankfill and First Flush elevation
 $V \text{ bf} - V \text{ ff} = 10,552 \text{ cf}$
 Target Detention Time = 36 hours
 Detention Time Differential = 19 hours
 $Q \text{ bf} = V \text{ difference} / T \text{ difference} = 0.16 \text{ cfs}$
 $h = 2/3 (Xbf - Xff) = 0.75 \text{ ft}$
 $A = Q \text{ bf} / 0.62 * (2 * 32.2 * h)^.5 = 0.036 \text{ sf}$
 Diameter of bankfull orifice = 1.5 inches
 Area of bankfull orifice = 0.012 sf
 Number of orifice holes = 3 @ Elev = 830.34
 RECORD = 3 @ Elev = 830.41

- Flow restrictor wall outlet sizing for "100-Year Storm" runoff
 $Qa = (0.15 \text{ cfs} / \text{acre}) * a = 0.53 \text{ cfs}$
 $h \text{ 100} = (X \text{ 100} - Xo) = 3.74 \text{ ft}$
 $h \text{ bf} = (X \text{ 100} - X \text{ ff}) = 2.54 \text{ ft}$
 Release from holes above
 $Q = A * 0.62 * (2 * 32.2 * h \text{ bf})^.5 + A * 0.62 * (2 * 32.2 * h \text{ 100})^.5 = 0.41 \text{ cfs}$
 $Q \text{ 100} = Qa - Q = 0.13 \text{ cfs}$
 $A \text{ 100} = Q \text{ ff} / 0.62 * (2 * 32.2 * h \text{ 100})^.5 = 0.0134999$
 Diameter of 100 orifice = 1.5 inches
 Area of 100-year orifice = 0.012 sf
 Number of orifice holes = 1 @ Elev = 831.46
 RECORD = 1 @ Elev = 831.47

UTILITY NOTES

- ALL WORK MUST BE DONE IN ACCORDANCE WITH CURRENT STANDARDS, SPECIFICATIONS AND GENERAL CONDITIONS OF THE CITY OF ANN ARBOR.
- SHOP DRAWINGS SHALL BE SUBMITTED BY THE UNDERGROUND CONTRACTOR FOR ALL WATER, SANITARY AND STORM INSTALLATION.
- CONTRACTOR SHALL SUBMIT RECORD "AS-BUILT" PLANS AFTER CONSTRUCTION.
- MAINTAIN A MINIMUM HORIZONTAL SEPARATION BETWEEN WATER SERVICE AND ANY OTHER UTILITY OF 10-FEET. THE MINIMUM VERTICAL CLEARANCE BETWEEN A WATER MAIN AND A SEWER SHALL BE 18-INCHES.
- NO GROUNDWATER, STORM WATER, CONSTRUCTION WATER, DOWNSPOUT DRAINAGE OR WEEP TILE DRAINAGE SHALL BE ALLOWED TO ENTER ANY SANITARY SEWER INSTALLATION.
- REFER TO PLUMBING PLANS TO VERIFY BUILDING UTILITY CONNECTION LOCATIONS. SITE UTILITY LOCATIONS TO TERMINATE 5' OUTSIDE OF BUILDING.
- SANITARY CLEANOUT ASSEMBLIES TO BE ZURN 1402-HD, OR OTHERWISE APPROVED EQUAL.
- THE LOCATION AND SIZE OF THE FRANCHISE UTILITY SERVICES SHALL BE DESIGNED AND INSTALLED BY THE UTILITY COMPANY.
- MAINTAIN 6.5' MIN. DEPTH OF BURY TO FINISHED GRADE FOR WATER SERVICE.
- ALL UTILITIES TO BE REMOVED SHALL BE DONE IN ACCORDANCE WITH THE APPLICABLE ENVIRONMENTAL AND/OR REGULATORY REQUIREMENTS.
- CONTRACTOR SHALL FIELD VERIFY THE LOCATION AND ELEVATION OF EXISTING UTILITIES PRIOR TO CONNECTION AND REPORT ALL FINDINGS TO THE ENGINEER.

INFILTRATION TESTING RESULTS

STAYBRIDGE SUITES & RETAIL CENTER
 Conducted on 12/06/2014
 Temperature 35 degrees +/-
 Overcast
 No Precipitation
 ** Test conducted approximately 40-feet north of soil boring B-4**

Test Number	Time from Start	Time from Start (hour)	Infiltration (ft)	Infiltration (inches)	Infiltration Rate (inches / hour)
Start	min sec	(hour)			
1	0 25	2:09:00 PM	0.0	0	0.0
2	1 30	2:09:25	0.1	1.2	172.8
3	4 30	2:10:30	0.2	2.4	96.0
4	8 36	2:13:30	0.3	3.6	48.0
5	11 23	2:17:36	0.4	4.8	33.5
6	20 14	2:20:23	0.5	6	31.6
7	34 53	2:29:14	0.6	7.2	21.4
8	62 2	2:43:53	0.7	8.4	14.4
		3:11:02	0.8	9.6	9.3

MEASURED INFILTRATION RATE: 9.3
 FACTOR OF SAFETY: 3
 DESIGN INFILTRATION RATE: 3.1

DETENTION CALCULATIONS

Design Basis: Use the Washtenaw County Water Resource Commissioner Design Criteria

W1 Determining Cover Types, Areas, Curve Numbers and Runoff Coefficients

Proposed Site Conditions

Surface Area (s.f.)	Impervious	Pervious
109,551.1	45,697.6	155,348.7
Impervious Runoff Coefficient	0.95	0.30
Weighted Runoff Coefficient	0.78	
Pervious Curve Number	68	
Impervious Curve Number	98	
Weighted Runoff Curve Number	89.18	

W2 First Flush Runoff Calculation
 Volume = (1)/(1/12)(43560 s/acre) x A x C = 10071 cf

W3 Pre-Development Bankfull Runoff Calculations

- 2 year / 24 hour storm event (P) = 2.35 in
- Pre-Development Curve Number (CN) = 81
- S = (1000 / CN) - 10 = 2.35 in
- Q = (P - (0.2 x S))^2 / (P + 0.8S) = 0.84 in
- Total Site Area excluding Self-Crediting BMPs = 155,348.7 sf
- Vbf pre = Q x (1/12) x Area = 10,836 cf

W4 Pervious Cover Post-Development Bankfull Runoff Calculations

- 2 year / 24 hour storm event (P) = 2.35 in
- Pervious Cover CN from W1 = 68
- S = (1000 / CN) - 10 = 4.71 in
- Q = (P - (0.2 x S))^2 / (P + 0.8S) = 0.32 in
- Total Site Area excluding Self-Crediting BMPs = 45,697.6 sf
- Vbf per post = Q x (1/12) x Area = 1,236 cf

W5 Impervious Cover Post-Development Bankfull Runoff Calculations

- 2 year / 24 hour storm event (P) = 2.35 in
- Impervious Cover CN from W1 = 98
- S = (1000 / CN) - 10 = 0.20 in
- Q = (P - (0.2 x S))^2 / (P + 0.8S) = 2.12 in
- Total Site Area excluding Self-Crediting BMPs = 109,651.1 sf
- Vbf imp post = Q x (1/12) x Area = 19,387 cf

W6 Pervious Cover Post-Development 100-year Storm Runoff Calculations

- 100 year Storm Event (P) = 5.11 in
- Pervious Cover CN from W1 = 68
- S = (1000 / CN) - 10 = 4.71 in
- Q = (P - (0.2 x S))^2 / (P + 0.8S) = 1.96 in
- Total Site Area excluding Self-Crediting BMPs = 45,697.6 sf
- V100 per post = Q x (1/12) x Area = 7,457 cf

W7 Impervious Cover Post-Development 100-year Storm Runoff Calculations

- 100 year Storm Event (P) = 5.11 in
- Impervious Cover CN from W1 = 98
- S = (1000 / CN) - 10 = 0.20 in
- Q = (P - (0.2 x S))^2 / (P + 0.8S) = 4.87 in
- Total Site Area excluding Self-Crediting BMPs = 109,651.1 sf
- V100 per post = Q x (1/12) x Area = 44,527 cf

W8 Determine Time of Concentration for Applicable Flow Types
 Time of Concentration (Tc) = 0.31 hr

W9 Runoff Summary & Onsite Infiltration Requirement

- Runoff Summary from Previous Worksheets
 First Flush Volume (Vff) = 10,071 cf
 Pre-Development Bankfull Runoff Volume (Vbf pre) = 10,836 cf
 Pervious Cover Post-Development Bankfull Volume (Vbf per post) = 1,236 cf
 Impervious Cover Post-Development Bankfull Volume (Vbf imp post) = 19,387 cf
 Total BF Volume (Vbf post) = 20,623 cf
 Pervious Cover Post-Development 100-Year Volume (V100 per post) = 7,457 cf
 Impervious Cover Post-Development Bankfull Volume (Vbf imp post) = 44,527 cf
 Total 100-Year Volume (V100) = 51,985 cf
- Determine Onsite Infiltration Requirement
 Total Post-Development Bankfull Volume (Vbf post) = 20,623 cf
 Pre-Development Bankfull Runoff Volume (Vbf pre) = 10,836 cf
 Bankfull Volume Difference = 9,787 cf
 Greater of First Flush Volume & Bankfull Volume Difference (Vinf) = 10,071 cf

W10 Detention/Retention Requirements

- Qp = 238.6 x Tc^-0.82 = 621 cfs/in-mi²
- Total Site Area excluding Self-Crediting BMPs = 3.57 acres
- Q100 = Q100 per + Q100 imp = 6.83 in
- Peak Flow (PF) = (Qp x Q100 x A) / 640 = 23.66 cfs
- Delta = PF - (0.15 x A) = 23.12 cfs
- Vdet = ((Delta / PF) x V100) - Vinf = 40,738 cf

W11 Standard Method Runoff Volume Calculations

Infiltration Bed = 22,224 cf
 Bioretention #1 = 282 cf
 Bioretention #2 = 209 cf
 Total Reduction Credit by Proposed Structural BMPs = 22,715 cf
 Runoff Volume Infiltration Requirement (Vinf) (Worksheet 9) = 10,071 cf
 Runoff Volume Credit = 12,644 cf


REQUIRED DETENTION VOLUME = 28,094 cf

EXISTING CONDITIONS


Drainage Area	Weighted Cw	High Point	Low Point	Length	Slope (%)	Tc (min)
EXISTING	0.70	839.2	831.8	548	1.3	16.00

Q = C * I * A
 C = 0.70
 I = 6.71 in/hour
 A = 3.57 acres
 Q = 16.7 cfs


THE EXISTING PROPERTY DOES NOT CONTAIN STORM DETENTION AND THE SURFACE WATER FLOWS OFF-SITE UNRESTRICTED.
 EXISTING = 16.7 CFS
 PROPOSED = 0.53 CFS

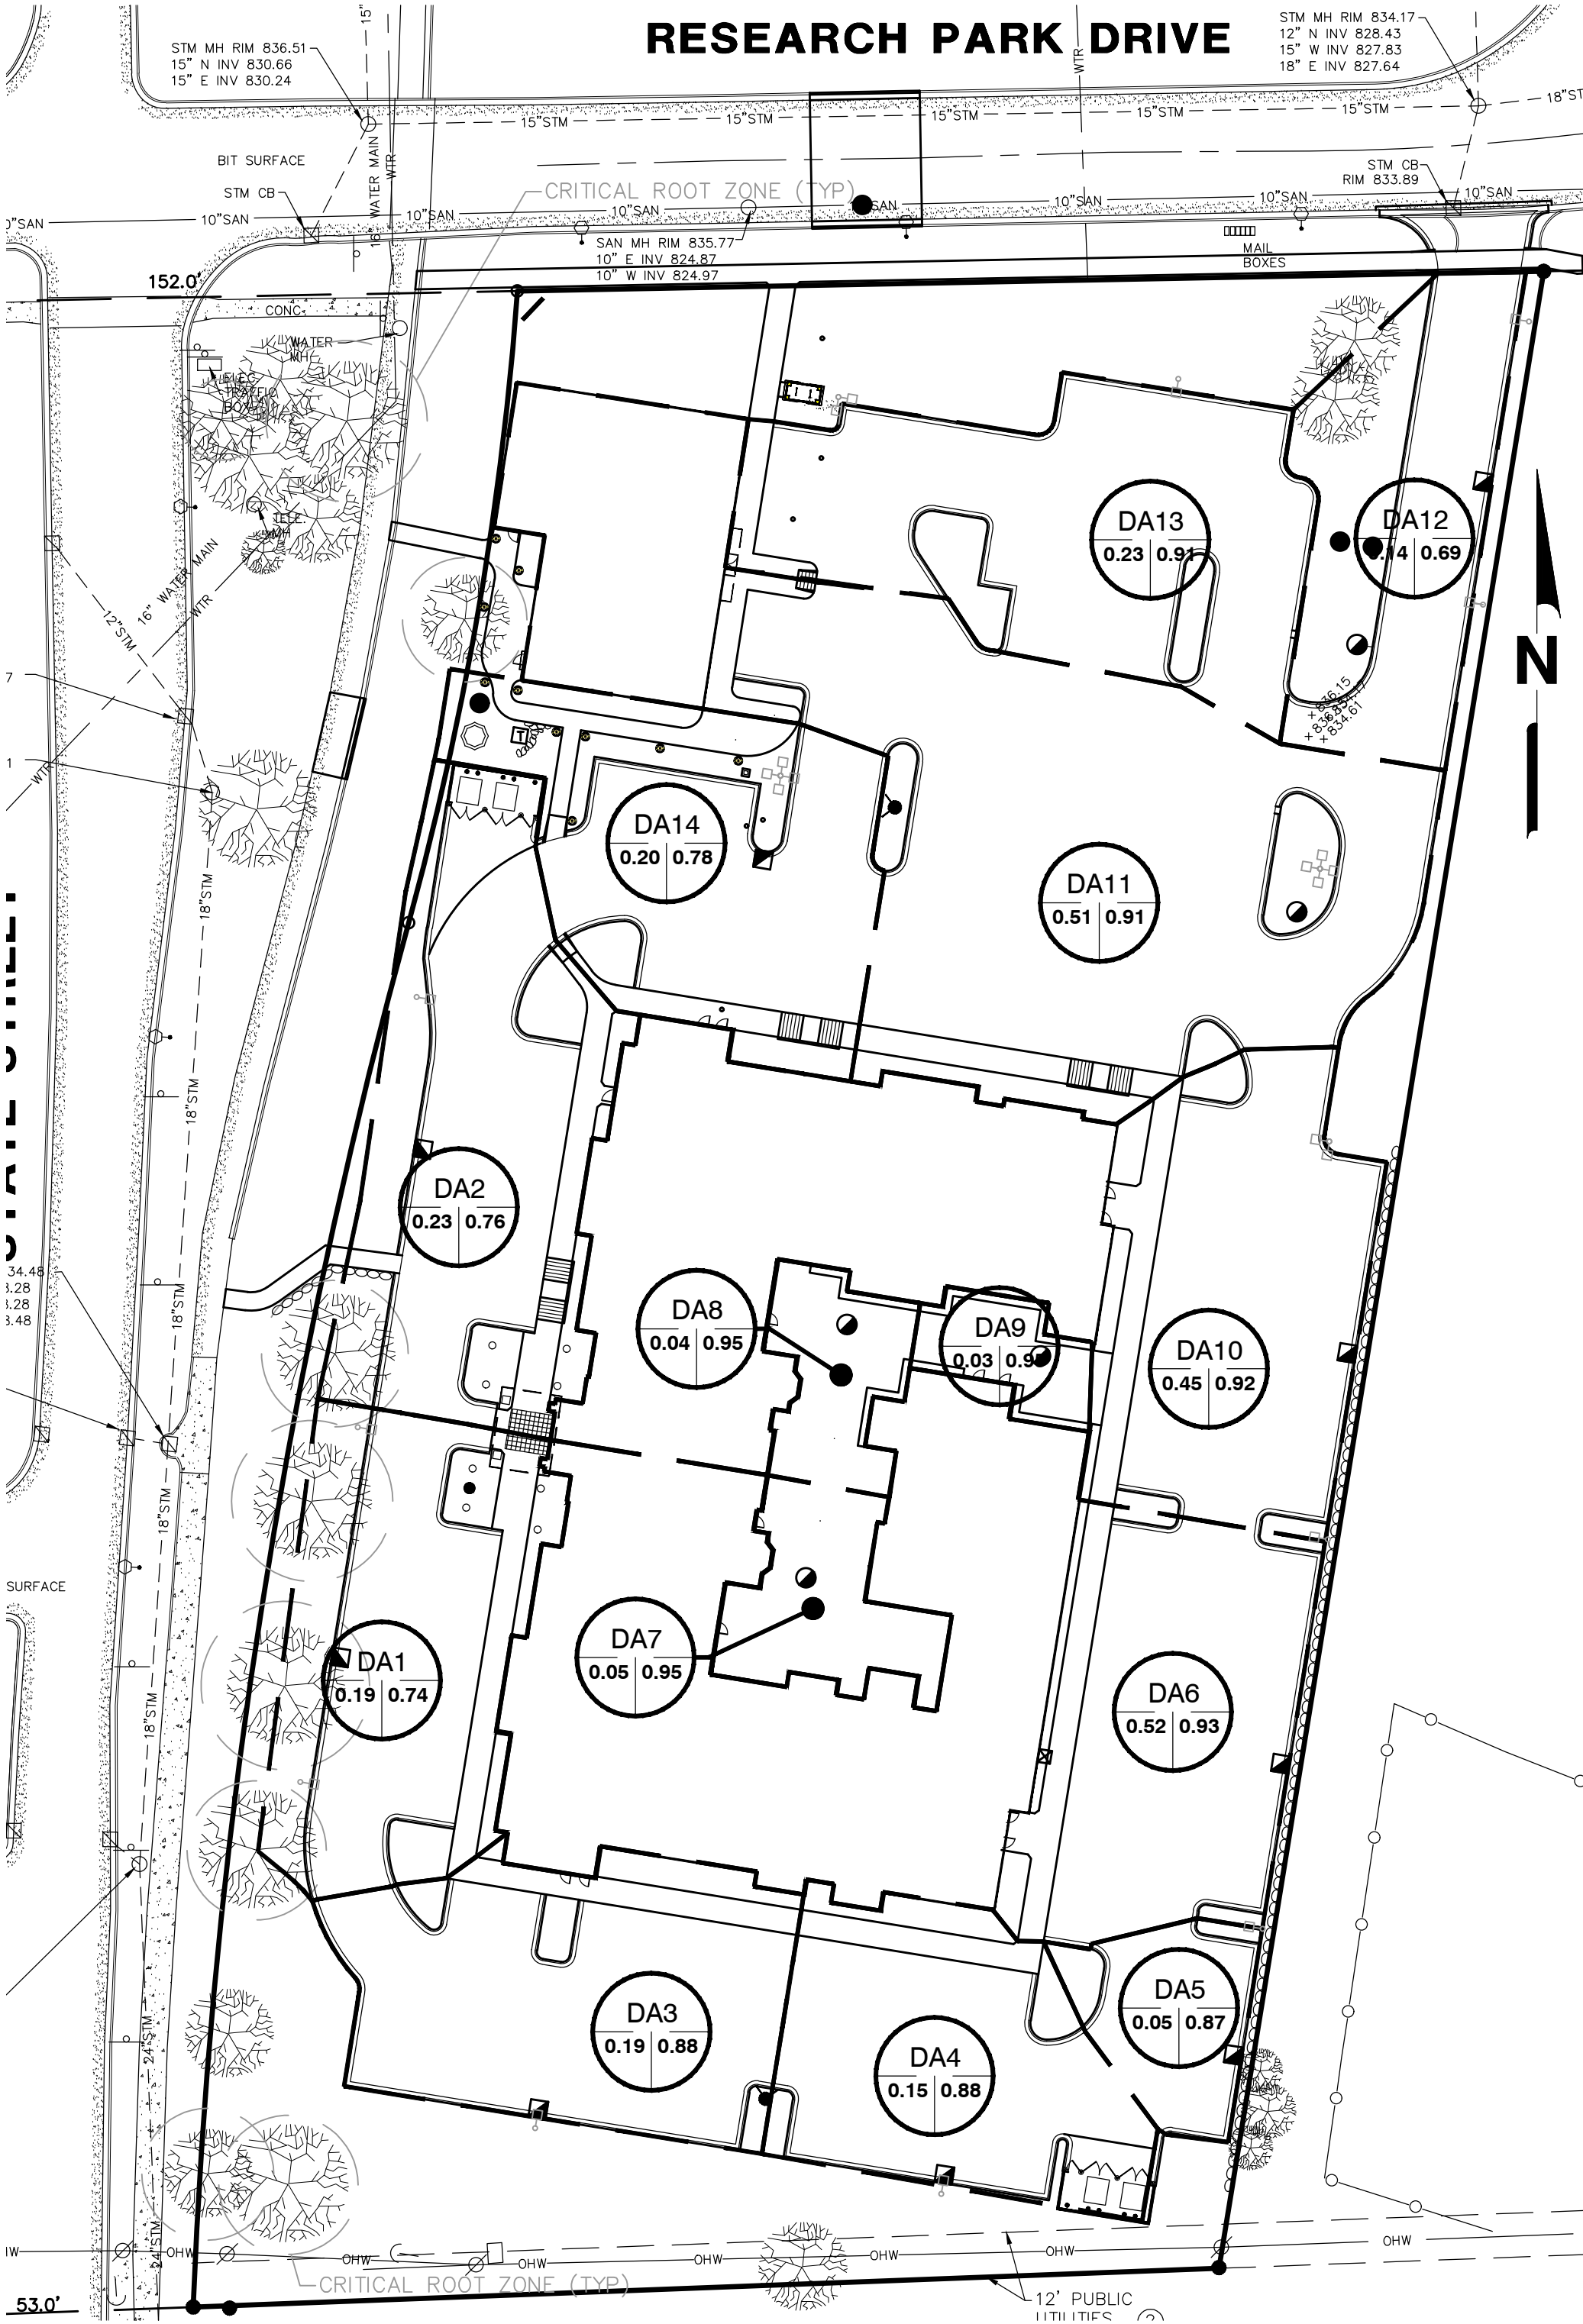

DRAINAGE AREA PLAN

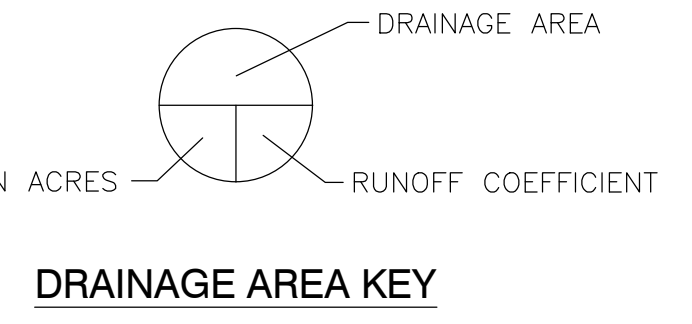

DRAINAGE AREA KEY

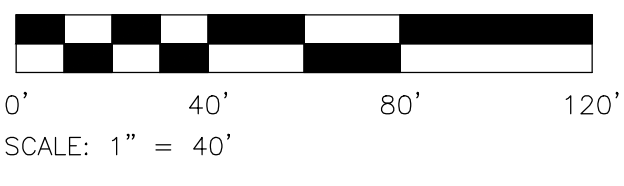

EXISTING CONDITIONS

TASK:	STREETS	CATCH BASIN INLET CASINGS	STORM SEWER SYSTEM	OUTFLOW CONTROL STRUCTURES	UNDERGROUND DETENTION	COMPONENTS:	SCHEDULE:
INSPECT FOR SEDIMENT ACCUMULATION	X	X	X	X	X	UNDERGROUND DETENTION	WEEKLY
REMOVAL OF SEDIMENT ACCUMULATION	X	X	X	X	X	UNDERGROUND DETENTION	AS NEEDED & PRIOR TO TURNOVER
INSPECT FOR FLOATABLES AND DEBRIS	X	X	X	X	X	UNDERGROUND DETENTION	QUARTERLY
CLEANING OF FLOATABLES AND DEBRIS	X	X	X	X	X	UNDERGROUND DETENTION	QUARTERLY AND AT TURNOVER
INSPECTION FOR EROSION				X	X	UNDERGROUND DETENTION	WEEKLY
REESTABLISH PERMANENT VEGETATION ON ERODED SLOPES				X	X	UNDERGROUND DETENTION	AS NEEDED & PRIOR TO TURNOVER
REPLACEMENT OF GRAVEL JACKETS				X	X	UNDERGROUND DETENTION	AS NEEDED
MOWING	X			X	X	UNDERGROUND DETENTION	0-2 TIMES PER YEAR
INSPECT STRUCTURAL ELEMENTS DURING WET WEATHER AND COMPARE TO AS-BUILT PLANS (BY PROFESSIONAL ENGINEER REPORTING TO THE CITY)		X	X	X	X	UNDERGROUND DETENTION	ANNUALLY AND AT TURNOVER
MAKE ADJUSTMENTS OR REPLACEMENTS AS DETERMINED BY ANNUAL WET WEATHER INSPECTION		X	X	X	X	UNDERGROUND DETENTION	AS NEEDED


AS NEEDED = WHEN SEDIMENT HAS ACCUMULATED TO A MAXIMUM OF ONE (1) FOOT DEPTH.

CONSTRUCTION MAINTENANCE SCHEDULE

TASK:	STREETS	CATCH BASIN INLET CASINGS	STORM SEWER SYSTEM	OUTFLOW CONTROL STRUCTURES	UNDERGROUND DETENTION	COMPONENTS:	SCHEDULE:
INSPECT FOR SEDIMENT ACCUMULATION	X	X	X	X	X	UNDERGROUND DETENTION	ANNUALLY
REMOVAL OF SEDIMENT ACCUMULATION	X	X	X	X	X	UNDERGROUND DETENTION	EVERY 5-10 YEARS AS NEEDED
INSPECT FOR FLOATABLES AND DEBRIS	X	X	X	X	X	UNDERGROUND DETENTION	ANNUALLY
CLEANING OF FLOATABLES AND DEBRIS	X	X	X	X	X	UNDERGROUND DETENTION	ANNUALLY
INSPECTION FOR EROSION				X	X	UNDERGROUND DETENTION	ANNUALLY
REESTABLISH PERMANENT VEGETATION ON ERODED SLOPES				X	X	UNDERGROUND DETENTION	AS NEEDED
REPLACEMENT OF GRAVEL JACKETS				X	X	UNDERGROUND DETENTION	EVERY 3-5 YEARS AS NEEDED
CLEAN STREETS	X			X	X	UNDERGROUND DETENTION	SEMI-ANNUALLY
MOWING	X			X	X	UNDERGROUND DETENTION	0-2 TIMES PER YEAR
INSPECT STRUCTURAL ELEMENTS DURING WET WEATHER AND COMPARE TO AS-BUILT PLANS (BY PROFESSIONAL ENGINEER REPORTING TO THE CITY)		X	X	X	X	UNDERGROUND DETENTION	ANNUALLY
MAKE ADJUSTMENTS OR REPLACEMENTS AS DETERMINED BY ANNUAL WET WEATHER INSPECTION		X	X	X	X	UNDERGROUND DETENTION	AS NEEDED
KEEP RECORDS OF ALL INSPECTIONS AND MAINTENANCE ACTIVITIES ARE REPORT TO CITY		X	X	X	X	UNDERGROUND DETENTION	ANNUALLY
KEEP RECORDS OF ALL COSTS FOR INSPECTIONS, MAINTENANCE AND REPAIRS, REPORT TO CITY		X	X	X	X	UNDERGROUND DETENTION	ANNUALLY
CITY REVIEWS COST EFFECTIVENESS OF THE PREVENTATIVE MAINTENANCE PROGRAM AND MAKES ADJUSTMENTS AS NEEDED		X	X	X	X	UNDERGROUND DETENTION	ANNUALLY
CITY TO HAVE A PROFESSIONAL ENGINEER CARRY OUT EMERGENCY INSPECTIONS UPON IDENTIFICATION OF SEVERE PROBLEMS		X	X	X	X	UNDERGROUND DETENTION	AS NEEDED

MAINTENANCE SCHEDULE

NOTE: REFER TO "UNDERGROUND STORMWATER MANAGEMENT SYSTEM CERTIFICATION" FORM FOR AS-BUILT INFORMATION

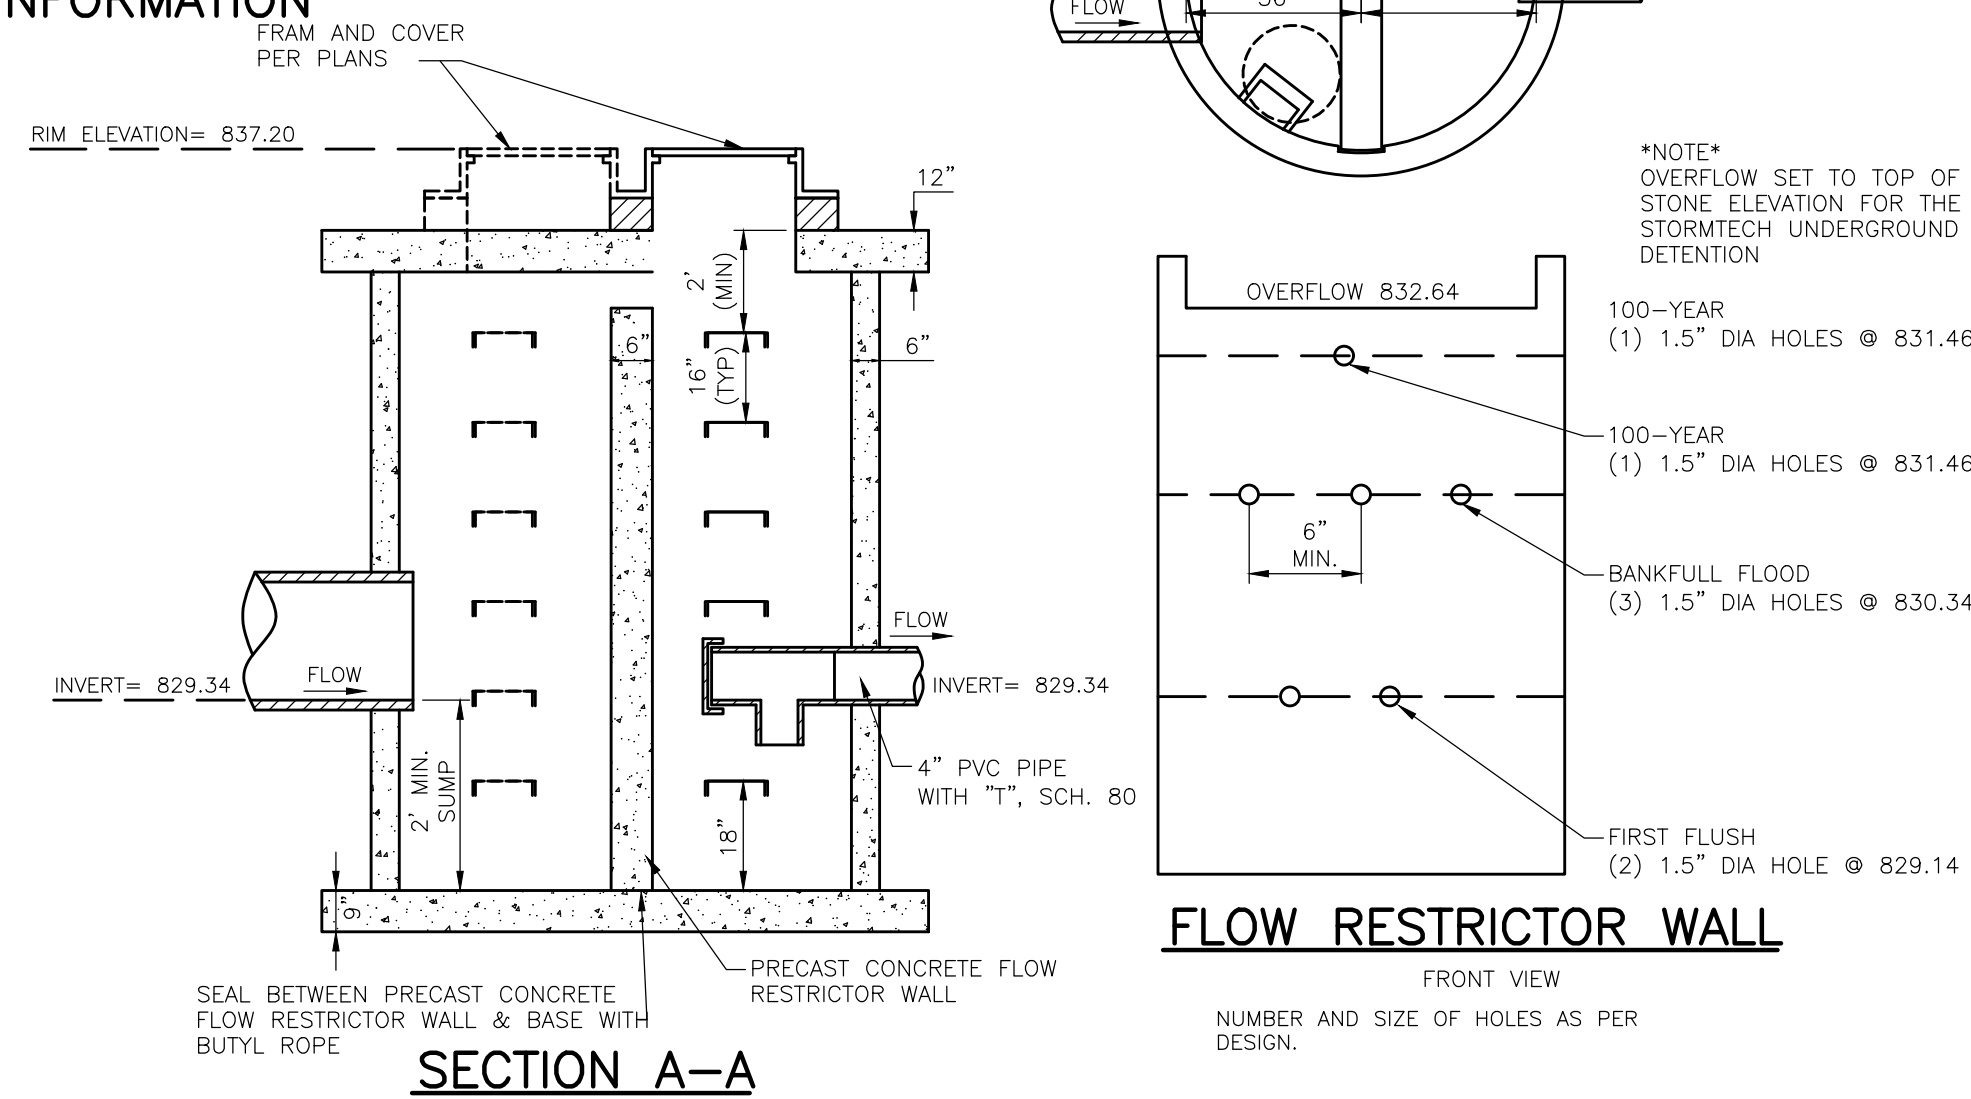

OUTLET CONTROL STRUCTURE



CITY OF ANN ARBOR, MICHIGAN
301 E. Huron Street, 1st Floor, Larcom City Hall
P.O. Box 8647, Ann Arbor, MI 48107
Phone (734) 794-6267 Fax (734) 994-8460 www.a2gov.org

UNDERGROUND STORMWATER MANAGEMENT SYSTEM CERTIFICATION

Project Name Staybridge Suites & Retail Center
Project Address 3850 Research Park Drive
Permit Number SOIL

OUTLET STRUCTURE
First Flush: Design 2 # of holes 1.5 inches in diameter area at elevation 829.14.
As Built 2 # of holes 1.5 inches in diameter area at elevation 829.16.
Bankfull: Design 3 # of holes 1.5 inches in diameter area at elevation 830.34.
As Built 3 # of holes 1.5 inches in diameter area at elevation 830.41.
100-Year: Design 1 # of holes 1.5 inches in diameter area at elevation 831.46.
As Built 1 # of holes 1.5 inches in diameter area at elevation 831.47.

STORAGE VOLUME
Infiltration: No Yes (If yes, include stone pores in the volume calculations) - 30% Stone Void
First Flush: Design Volume is 9823 c.f. As-built Volume is 10,583 c.f. *Refer to attached
Bankfull: Design Volume is 20,623 c.f. As-built Volume is 20,716 c.f. documentation and
100-Year: Design Volume is 28,094 c.f. As-built Volume is 28,197 c.f. calculations

STORAGE ELEVATION
First Flush: Design Elevation is 830.34 As-built Elevation is 830.41
Bankfull: Design Elevation is 831.46 As-built Elevation is 831.47
100-Year: Design Elevation is 832.64 As-built Elevation is 832.90

STORM WATER MANAGEMENT SYSTEM INFORMATION - UNDERGROUND DETENTION
Water Quality Structure: Design Model FD-4HC & FD-6HC As-built Model FD-4HC & FD-6HC
Pipe Length: -- in diameter: Design --- L.F. As-built --- L.F. AS-BUILT INFORMATION
Pipe Length: -- in diameter: Design --- L.F. As-built --- L.F. ADS StormTech System
Pipe Length: -- in diameter: Design --- L.F. As-built --- L.F. SC-740 Chambers = 373 A.B.
SC-740 End Caps = 52 A.B.


COMMENTS (Please describe any deviations from the approved site plan):
Certification pertains to documentation of conditions as of 03/13/2017. BDE was not responsible for neither construction management nor construction quality. Landwise Inc. performed the field verification surveys on 03/02/17 and 03/23/17.

I hereby certify that the storm water detention facilities of the aforementioned Site is complete, and that I have inspected and verified that the structures have been installed in accordance with the approved construction plans and the City of Ann Arbor's Standards and Specifications.

Date: March 23, 2017
Signed: Architect or Professional Engineer

Doc. Ver. Nov 2012

Affix Architect or Engineer's Seal

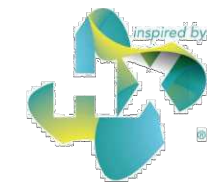

First Defense®

Cost-effective stormwater treatment with adaptability to meet demanding site requirements

Product Profile

The First Defense® is an enhanced vortex separator that combines an effective and economical stormwater treatment chamber with an integral peak flow bypass. It efficiently removes sediment, total suspended solids (TSS), trash and hydrocarbons from stormwater runoff without washing out previously captured pollutants. The First Defense® is available in several model configurations to accommodate a wide range of pipe sizes, peak flows and depth constraints (Table 1, next page).

Components

- Inlet Grate (optional)
- Inlet Chute
- Inlet Pipe (optional)
- Floatables Draw Off Slot (not pictured)
- Precast Vortex Chamber
- Internal Bypass
- Outlet Chute
- Outlet Pipe
- Oil and Floatables Storage
- Sediment Storage Sump

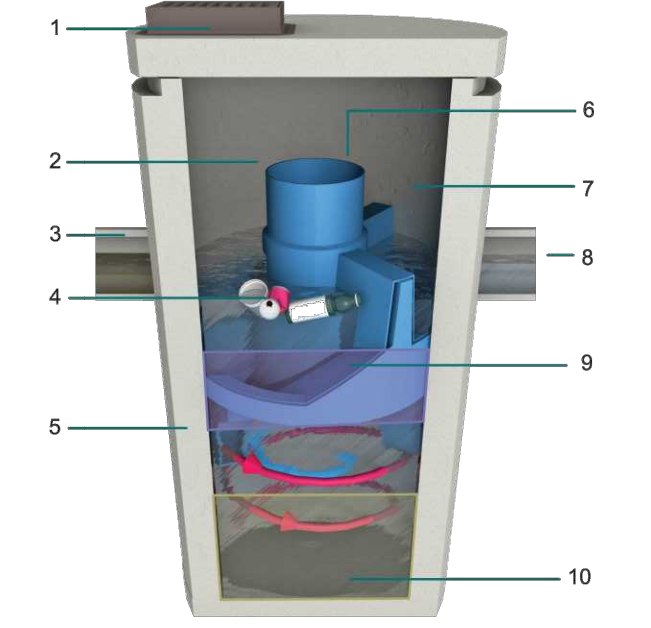


Fig. 1 The First Defense® has internal components designed to efficiently capture pollutants and prevent washout at peak flows.

Applications

- Stormwater treatment at the point of entry into the drainage line
- Sites constrained by space, topography or drainage profiles with limited slope and depth of cover
- Retrofit installations where stormwater treatment is placed on or tied into an existing storm drain line
- Pretreatment for filters, infiltration and storage

How it Works

The First Defense® has internal components designed to remove and retain gross debris, total suspended solids (TSS) and hydrocarbons (Fig. 1). Contaminated stormwater runoff enters the inlet chute from a surface grate and/or inlet pipe. The inlet chute introduces flow into the chamber tangentially to create a low energy vortex flow regime (magnets arrow) that directs sediment into the sump while oils, floating trash and debris rise to the surface.

Treated stormwater exits through a submerged outlet chute located opposite to the direction of the rotating flow (blue arrow). Enhanced vortex separation is provided by forcing the rotating flow within the vessel to follow the longest path possible rather than directly from inlet to outlet.

Higher flows bypass the treatment chamber to prevent turbulence and washout of captured pollutants. An integral bypass conveys infrequent peak flows directly to the outlet chute, eliminating the need for, and expense of, external bypass control structures. A floatables draw off slot functions to convey floatables into the treatment chamber prior to bypass.

Stormwater Solutions
Turning Water Around...®

FIRST DEFENSE PRE-TREATMENT UNITS

NO SCALE

First Defense®

Maintenance

The First Defense® needs minimal maintenance, but like all structural best management practices maintenance is necessary for the long-term protection of the environment.

Sediments captured by the First Defense® are stored in the sump; floatable trash and hydrocarbons are stored on the surface of the standing water. A commercially or municipally owned sump-vac is used to remove captured sediment and floatables (Fig. 2).

More information can be found in the First Defense® Operation and Maintenance Manual, available at <http://www.hydro-int.com/us/products/first-defense>.



Fig. 2 Maintenance is performed with a vacuum truck.

First Defense® Sizing & Design

Design Options for Inlet and Internal Bypass Arrangements

For maximum flexibility the First Defense® inlet and internal bypass arrangements are available in two configurations (Fig. 3a & 3b). Model parameters and design criteria are shown in Table 1.

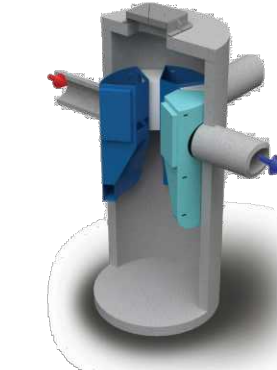


Fig. 3a Inlet configurations for all models include options for inlet grates and multiple inlet pipes.

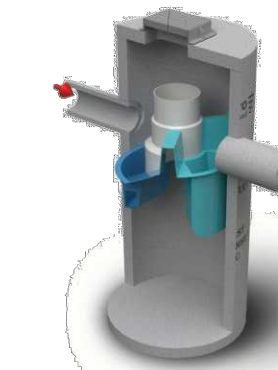


Fig. 3b First Defense®-HC with higher capacity internal bypass and larger maximum pipe diameter.

Table 1. First Defense® Models and Design Criteria.

First Defense® Model Number	Diameter	Typical Flow Rates for TSS Treatment		Peak Flow Rate	Maximum Pipe Diameter ¹	Storage Capacity	Typical Sediment Storage Capacity ²	Minimum Distance from Outlet Invert to Top of Rim ³	Standard Distance from Outlet to Sump Floor
		100µm	200µm						
FD-4	4 / 1.2	0.7 / 20	1.2 / 34	6 / 170	18 / 450	180 / 681	1.3 / 1.0	3.1 / 1.1	5.47 / 1.7
FD-4HC	4 / 1.2	0.7 / 20	1.2 / 34	18 / 510	24 / 600	191 / 723	1.3 / 1.0	2.3 - 3.9 / 0.7 - 1.2	5.47 / 1.7
FD-6	6 / 1.8	2.2 / 63	3.8 / 108	18 / 510	24 / 600	420 / 1,590	3.3 / 2.5	4.0 / 1.2	6.52 / 2.0
FD-6HC	6 / 1.8	2.2 / 63	3.8 / 108	32 / 906	30 / 750	496 / 1,878	3.3 / 2.5	3.0 - 5.1 / 0.9 - 1.6	6.52 / 2.0


¹Contact Hydro International when larger pipe sizes are required.

²Contact Hydro International when custom sediment storage capacity is required.

³The minimum distance for the 4HC and 6HC models depends on pipe diameter.

Hydro International, 94 Hutchins Drive, Portland, ME 04102
Tel: (207) 756-6200 Fax: (207) 756-6212
Email: stormwaterinquiry@hydro-int.com Web: www.hydro-int.com

Stormwater Solutions
Turning Water Around...®
FDS1502F

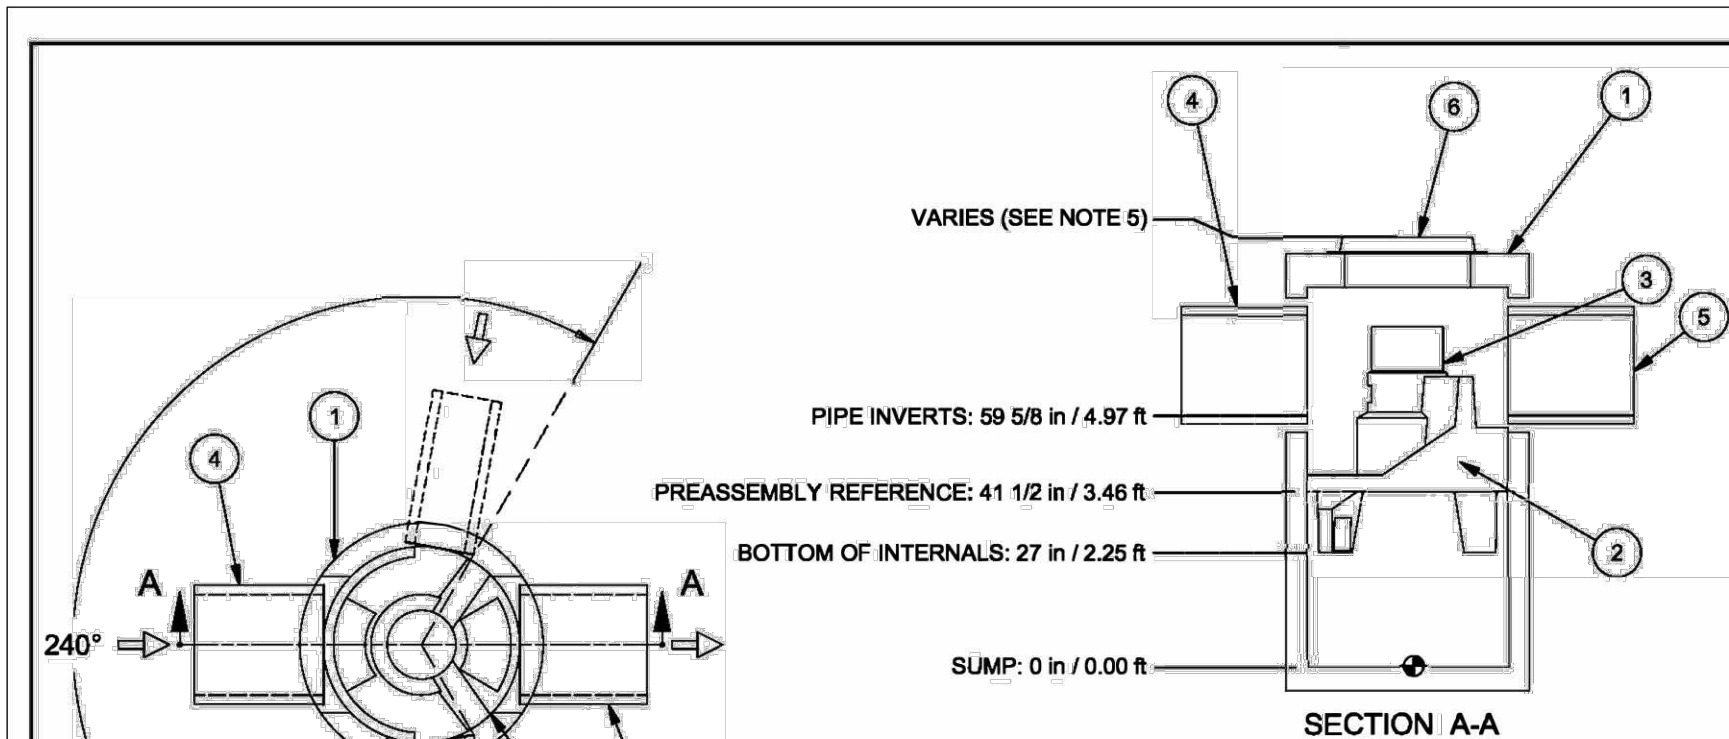


ITEM	SIZE (in)	DESCRIPTION
1	48	I.D. PRECAST MANHOLE
2		LEDGER SUPPORT
3		SEPARATION MODULE
4	24	INLET PIPE (BY OTHERS)
5	24	OUTLET PIPE (BY OTHERS)
6	30	FRAME AND COVER (OR GRATE) (ROUND)

© 2014 Hydro International

FIRST DEFENSE FD-4HC

NO SCALE

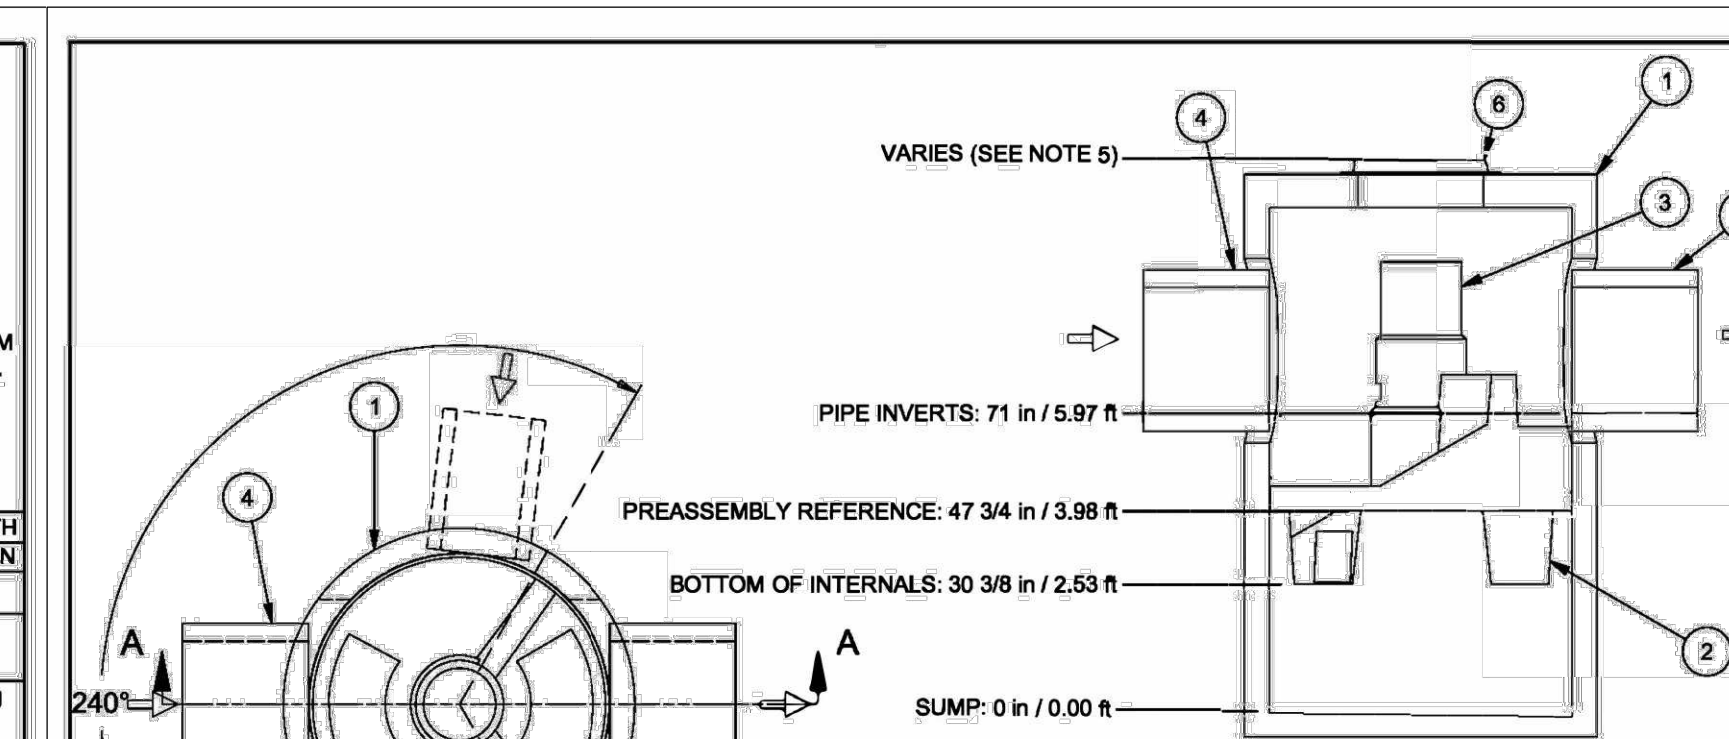

ITEM	SIZE (in)	DESCRIPTION
1	72	I.D. PRECAST MANHOLE
2		LEDGER SUPPORT
3		SEPARATION MODULE
4	30	INLET PIPE (BY OTHERS)
5	30	OUTLET PIPE (BY OTHERS)
6	30	FRAME AND COVER (OR GRATE) (ROUND)

© 2008 Hydro International

FIRST DEFENSE FD-6HC

NO SCALE

2600 AUBURN ROAD, SUITE 160
AUBURN HILLS, MI 48326
PH 810-444-7815
FX 248-553-4218

PREPARED UNDER THE DIRECTION OF:
ANDREW ANDRE, P.E.
MI #47380

APPLICANT:
STELLAR HOSPITALITY ANN ARBOR, LLC
2600 AUBURN ROAD, SUITE 240
AUBURN HILLS, MI 48326
PH 248-419-5551

STAYBRIDGE SUITES & RETAIL CENTER

3850 RESEARCH PARK DRIVE
ANN ARBOR, MI 48108

THIS DRAWING IS THE PROPERTY OF STELLAR DEVELOPMENT, LLC. IT IS TO BE USED ONLY FOR THE PROJECT AND SITE SPECIFICALLY IDENTIFIED HEREIN. NO PARTS OF THIS DRAWING ARE TO BE REPRODUCED, COPIED, OR TRANSMITTED IN ANY FORM OR BY ANY MEANS, WITHOUT THE WRITTEN PERMISSION OF STELLAR DEVELOPMENT, LLC. THE USER SHALL BE RESPONSIBLE FOR OBTAINING ALL NECESSARY PERMITS AND APPROVALS FROM ALL APPLICABLE AGENCIES. STELLAR DEVELOPMENT, LLC IS NOT RESPONSIBLE FOR ANY DAMAGE TO PERSONS OR PROPERTY ARISING FROM THE USE OF THIS DRAWING. THE USER SHALL BE RESPONSIBLE FOR OBTAINING ALL NECESSARY PERMITS AND APPROVALS FROM ALL APPLICABLE AGENCIES. STELLAR DEVELOPMENT, LLC IS NOT RESPONSIBLE FOR ANY DAMAGE TO PERSONS OR PROPERTY ARISING FROM THE USE OF THIS DRAWING.

© 2012 STELLAR DEVELOPMENT, LLC

ISSUED FOR	DATE
SPA	12/29/14
SPA	02/20/15
SPA	03/23/15
SPA	04/23/15
PERMITS	06/12/15
SPA	08/17/15
CONST PLANS	09/05/15
CONST PLANS	10/02/15
CONST PLANS	11/05/15
CONST PLANS	12/09/15
STORM REVISION	01/15/16
UD DETENTION	03/06/16
SPA	01/21/21
SPA	02/28/21

DATE: _____
DRAWN: ACA
CHECKED: _____
SCALE: NTS
JOB NO: BD-14-322

STREET TITLE:
STORM MANAGEMENT DETAILS
SHEET
C5.3

PROJECT INFORMATION	
ENGINEERED BY:	CHRIS OWEN 248-431-1361 CHRIS.OWEN@ADS-PIPE.COM
PRODUCT MANAGER:	ANDY KELLER 248-417-4093 ANDY.KELLER@ADS-PIPE.COM
ADS SALES REP:	ANDY KELLER 248-417-4093 ANDY.KELLER@ADS-PIPE.COM
PROJECT NO.:	93256



STAYBRIDGE SUITES & RETAIL CENTER

ANN ARBOR, MICHIGAN

STORMWATER CHAMBER SPECIFICATIONS

- CHAMBERS SHALL BE STORMTECH SC-740, SC-310, OR APPROVED EQUAL.
- CHAMBERS SHALL BE MANUFACTURED FROM VIRGIN POLYPROPYLENE OR POLYETHYLENE RESINS.
- CHAMBER ROWS SHALL PROVIDE CONTINUOUS, UNOBSTRUCTED INTERNAL SPACE WITH NO INTERNAL SUPPORT PANELS THAT WOULD IMPEDE FLOW OR LIMIT ACCESS FOR INSPECTION.
- THE STRUCTURAL DESIGN OF THE CHAMBERS, THE STRUCTURAL BACKFILL, AND THE INSTALLATION REQUIREMENTS SHALL ENSURE THAT THE LOAD FACTORS SPECIFIED IN THE AASHTO LRFD BRIDGE DESIGN SPECIFICATIONS, SECTION 12.12, ARE MET FOR: 1) LONG-DURATION DEAD LOADS AND 2) SHORT-DURATION LIVE LOADS, BASED ON THE AASHTO DESIGN TRUCK WITH CONSIDERATION FOR IMPACT AND MULTIPLE VEHICLE PRESENCES.
- CHAMBERS SHALL MEET ASTM F2922 (POLYETHYLENE) OR ASTM F2418 (POLYPROPYLENE), "STANDARD SPECIFICATION FOR THERMOPLASTIC CORRUGATED WALL STORMWATER COLLECTION CHAMBERS".
- CHAMBERS SHALL BE DESIGNED AND ALLOWABLE LOADS DETERMINED IN ACCORDANCE WITH ASTM F2787, "STANDARD PRACTICE FOR STRUCTURAL DESIGN OF THERMOPLASTIC CORRUGATED WALL STORMWATER COLLECTION CHAMBERS".
- ONLY CHAMBERS THAT ARE APPROVED BY THE SITE DESIGN ENGINEER WILL BE ALLOWED. THE CHAMBER MANUFACTURER SHALL SUBMIT THE FOLLOWING UPON REQUEST TO THE SITE DESIGN ENGINEER FOR APPROVAL BEFORE DELIVERING CHAMBERS TO THE PROJECT SITE:
 - A STRUCTURAL EVALUATION SEALED BY A REGISTERED PROFESSIONAL ENGINEER THAT DEMONSTRATES THAT THE SAFETY FACTORS ARE GREATER THAN OR EQUAL TO 1.35 FOR DEAD LOAD AND 1.75 FOR LIVE LOAD, THE MINIMUM REQUIRED BY ASTM F2787 AND BY AASHTO FOR THERMOPLASTIC PIPE.
 - A STRUCTURAL EVALUATION SEALED BY A REGISTERED PROFESSIONAL ENGINEER THAT DEMONSTRATES THAT THE LOAD FACTORS SPECIFIED IN THE AASHTO LRFD BRIDGE DESIGN SPECIFICATIONS, SECTION 12.12, ARE MET, THE 50 YEAR CREEP MODULUS DATA SPECIFIED IN ASTM F2418 OR ASTM F2922 MUST BE USED AS PART OF THE AASHTO STRUCTURAL EVALUATION TO VERIFY LONG-TERM PERFORMANCE.
 - STRUCTURAL CROSS SECTION DETAIL ON WHICH THE STRUCTURAL EVALUATION IS BASED.
- CHAMBERS AND END CAPS SHALL BE PRODUCED AT AN ISO 9001 CERTIFIED MANUFACTURING FACILITY.

IMPORTANT - NOTES FOR THE BIDDING AND INSTALLATION OF THE SC-310/SC-740 SYSTEM


- STORMTECH SC-310 & SC-740 CHAMBERS SHALL NOT BE INSTALLED UNTIL THE MANUFACTURER'S REPRESENTATIVE HAS COMPLETED A PRE-CONSTRUCTION MEETING WITH THE INSTALLERS.
- STORMTECH SC-310 & SC-740 CHAMBERS SHALL BE INSTALLED IN ACCORDANCE WITH THE "STORMTECH SC-310/SC-740/DC-780 CONSTRUCTION GUIDE".
- CHAMBERS ARE NOT TO BE BACKFILLED WITH A DOZER OR AN EXCAVATOR SITUATED OVER THE CHAMBERS.
STORMTECH RECOMMENDS 3 BACKFILL METHODS:
• STONESHOOTER LOCATED OFF THE CHAMBER BED.
• BACKFILL AS ROWS ARE BUILT USING AN EXCAVATOR ON THE FOUNDATION STONE OR SUBGRADE.
• BACKFILL FROM OUTSIDE THE EXCAVATION USING A LONG BOOM HOE OR EXCAVATOR.
- THE FOUNDATION STONE SHALL BE LEVELED AND COMPACTED PRIOR TO PLACING CHAMBERS.
- JOINTS BETWEEN CHAMBERS SHALL BE PROPERLY SEATED PRIOR TO PLACING STONE.
- MAINTAIN MINIMUM - 6" (150 mm) SPACING BETWEEN THE CHAMBER ROWS.
- EMBEDMENT STONE SURROUNDING CHAMBERS MUST BE A CLEAN, CRUSHED, ANGULAR STONE 3/4" - 2" (20-50 mm).
- THE CONTRACTOR MUST REPORT ANY DISCREPANCIES WITH CHAMBER FOUNDATION MATERIALS BEARING CAPACITIES TO THE SITE DESIGN ENGINEER.
- ADS RECOMMENDS THE USE OF "FLEXSTORM CATCH IT" INSERTS DURING CONSTRUCTION FOR ALL INLETS TO PROTECT THE SUBSURFACE STORMWATER MANAGEMENT SYSTEM FROM CONSTRUCTION SITE RUNOFF.

NOTES FOR CONSTRUCTION EQUIPMENT

- STORMTECH SC-310 & SC-740 CHAMBERS SHALL BE INSTALLED IN ACCORDANCE WITH THE "STORMTECH SC-310/SC-740/DC-780 CONSTRUCTION GUIDE".
- THE USE OF CONSTRUCTION EQUIPMENT OVER SC-310 & SC-740 CHAMBERS IS LIMITED:
• NO EQUIPMENT IS ALLOWED ON BARE CHAMBERS.
• NO RUBBER Tired LOADERS, DUMP TRUCKS, OR EXCAVATORS ARE ALLOWED UNTIL PROPER FILL DEPTHS ARE REACHED IN ACCORDANCE WITH THE "STORMTECH SC-310/SC-740/DC-780 CONSTRUCTION GUIDE".
• WEIGHT LIMITS FOR CONSTRUCTION EQUIPMENT CAN BE FOUND IN THE "STORMTECH SC-310/SC-740/DC-780 CONSTRUCTION GUIDE".
- FULL 36" (900 mm) OF STABILIZED COVER MATERIALS OVER THE CHAMBERS IS REQUIRED FOR DUMP TRUCK TRAVEL OR DUMPING.

USE OF A DOZER TO PUSH EMBEDMENT STONE BETWEEN THE ROWS OF CHAMBERS MAY CAUSE DAMAGE TO THE CHAMBERS AND IS NOT AN ACCEPTABLE BACKFILL METHOD. ANY CHAMBERS DAMAGED BY THE "DUMP AND PUSH" METHOD ARE NOT COVERED UNDER THE STORMTECH STANDARD WARRANTY.

CONTACT STORMTECH AT 1-888-892-2694 WITH ANY QUESTIONS ON INSTALLATION REQUIREMENTS OR WEIGHT LIMITS FOR CONSTRUCTION EQUIPMENT.

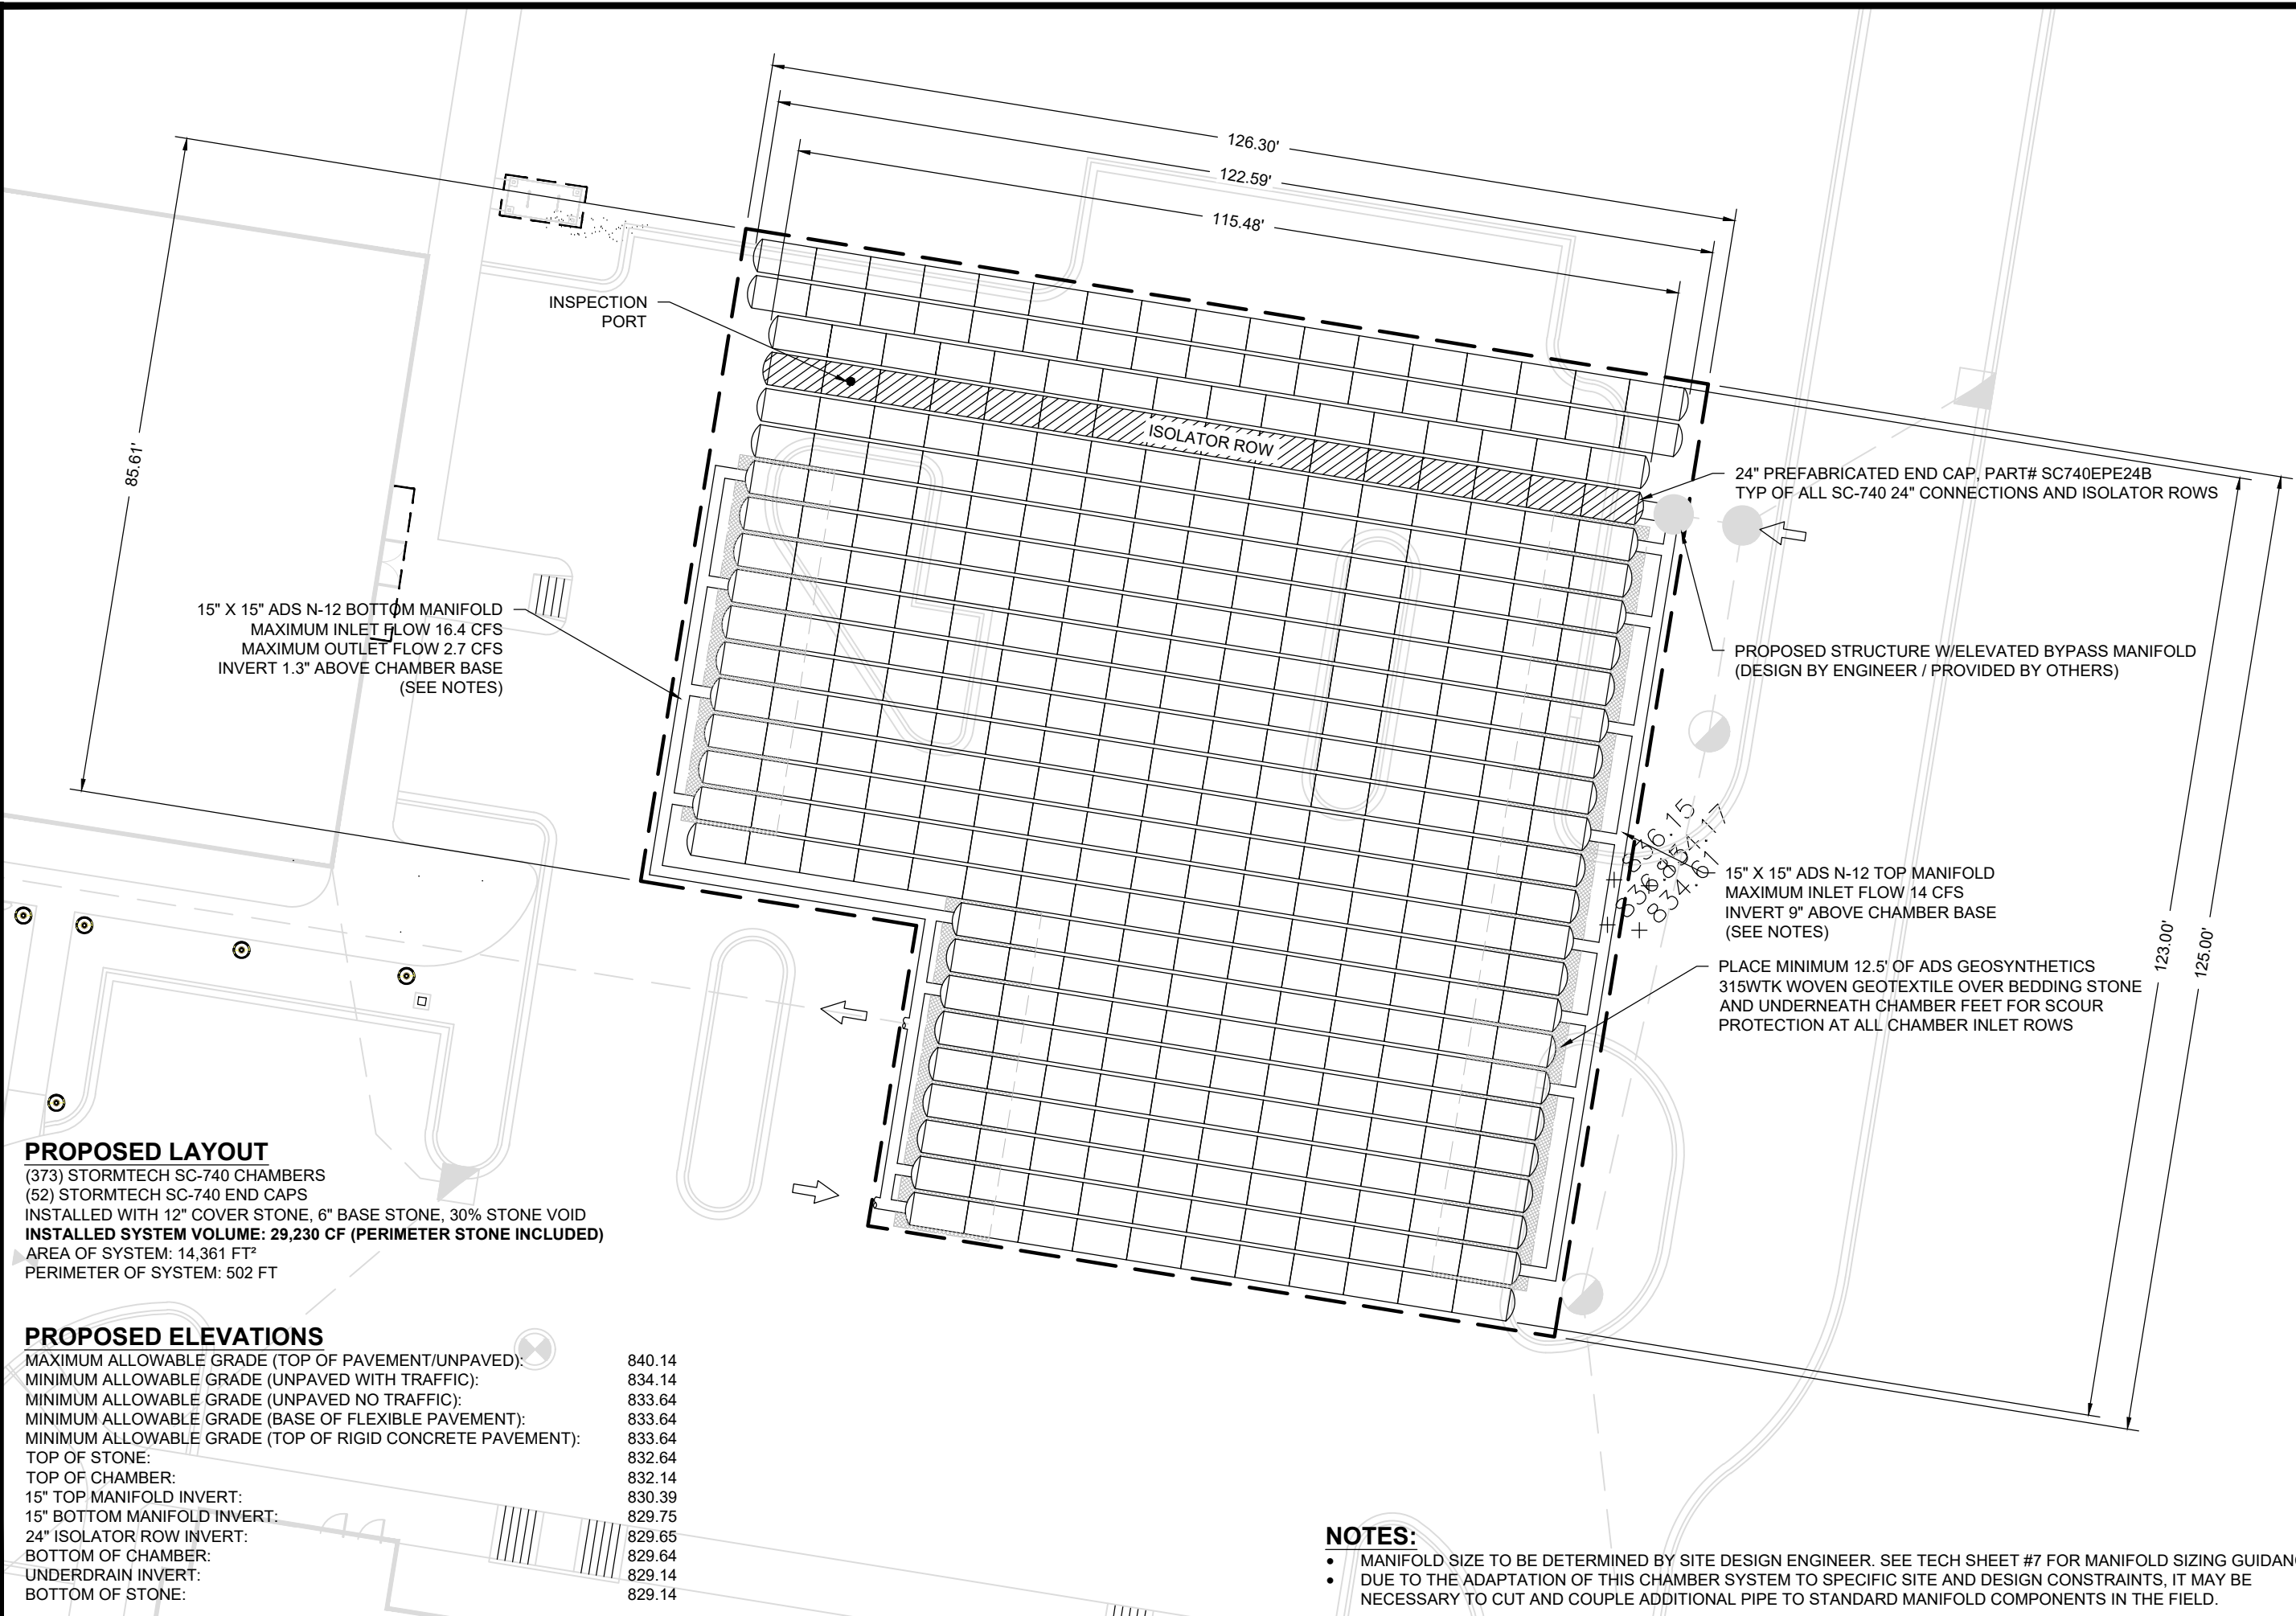

PROPOSED LAYOUT
 (373) STORMTECH SC-740 CHAMBERS
 (52) STORMTECH SC-740 END CAPS
 INSTALLED WITH 12\"/>

PROPOSED ELEVATIONS


MAXIMUM ALLOWABLE GRADE (TOP OF PAVEMENT/UNPAVED):	840.14
MINIMUM ALLOWABLE GRADE (UNPAVED WITH TRAFFIC):	834.14
MINIMUM ALLOWABLE GRADE (BASE OF FLEXIBLE PAVEMENT):	833.64
MINIMUM ALLOWABLE GRADE (TOP OF RIGID CONCRETE PAVEMENT):	833.64
TOP OF CHAMBER:	832.64
15\"/>	
24\"/>	
UNDERDRAIN INVERT:	829.64
BOTTOM OF STONE:	829.14

- NOTES:**
- MANIFOLD SIZE TO BE DETERMINED BY SITE DESIGN ENGINEER. SEE TECH SHEET #7 FOR MANIFOLD SIZING GUIDANCE.
 - DUE TO THE ADAPTATION OF THIS CHAMBER SYSTEM TO SPECIFIC SITE AND DESIGN CONSTRAINTS, IT MAY BE NECESSARY TO CUT AND COUPLE ADDITIONAL PIPE TO STANDARD MANIFOLD COMPONENTS IN THE FIELD.

ACCEPTABLE FILL MATERIALS: STORMTECH SC-740 CHAMBER SYSTEMS

MATERIAL LOCATION	DESCRIPTION	AASHTO MATERIAL CLASSIFICATIONS	COMPACTION / DENSITY REQUIREMENT
D FINAL FILL: FILL MATERIAL FOR LAYER 'D' STARTS FROM THE TOP OF THE 'C' LAYER TO THE BOTTOM OF FLEXIBLE PAVEMENT OR UNPAVED FINISHED GRADE ABOVE. NOTE THAT PAVEMENT SUBBASE MAY BE PART OF THE 'D' LAYER.	ANY SOIL/ROCK MATERIALS, NATIVE SOILS, OR PER ENGINEER'S PLANS. CHECK PLANS FOR PAVEMENT SUBGRADE REQUIREMENTS.	N/A	PREPARE PER SITE DESIGN ENGINEER'S PLANS. PAVED INSTALLATIONS MAY HAVE STRINGENT MATERIAL AND PREPARATION REQUIREMENTS.
C INITIAL FILL: FILL MATERIAL FOR LAYER 'C' STARTS FROM THE TOP OF THE EMBEDMENT STONE ('B' LAYER) TO 18\"/>			
B EMBEDMENT STONE: FILL SURROUNDING THE CHAMBERS FROM THE FOUNDATION STONE ('A' LAYER) TO THE 'C' LAYER ABOVE.	CLEAN, CRUSHED, ANGULAR STONE, NOMINAL SIZE DISTRIBUTION BETWEEN 3/4-2 INCH (20-50 mm)	AASHTO M43 3, 357, 4, 467, 5, 56, 57, 6, 67, 68, 7, 78, 8, 89, 9, 10	NO COMPACTION REQUIRED.
A FOUNDATION STONE: FILL BELOW CHAMBERS FROM THE SUBGRADE UP TO THE FOOT (BOTTOM) OF THE CHAMBER.	CLEAN, CRUSHED, ANGULAR STONE, NOMINAL SIZE DISTRIBUTION BETWEEN 3/4-2 INCH (20-50 mm)	AASHTO M43 3, 357, 4, 467, 5, 56, 57, 6, 67, 68, 7, 78, 8, 89, 9, 10	PLATE COMPACT OR ROLL TO ACHIEVE A FLAT SURFACE. **

- PLEASE NOTE:
- THE LISTED AASHTO DESIGNATIONS ARE FOR GRADATIONS ONLY. THE STONE MUST ALSO BE CLEAN, CRUSHED, ANGULAR. FOR EXAMPLE, A SPECIFICATION FOR #4 STONE WOULD STATE: "CLEAN, CRUSHED, ANGULAR NO. 4 (AASHTO M43) STONE".
 - STORMTECH COMPACTION REQUIREMENTS ARE MET FOR 'A' LOCATION MATERIALS WHEN PLACED AND COMPACTED IN 6" (150 mm) (MAX) LIFTS USING TWO FULL COVERAGES WITH A VIBRATORY COMPACTOR.
 - WHERE INFILTRATION SURFACE MAY BE COMPROMISED BY COMPACTION, FOR STANDARD DESIGN LOAD CONDITIONS, A FLAT SURFACE MAY BE ACHIEVED BY RAKING OR DRAGGING WITHOUT COMPACTION EQUIPMENT. FOR SPECIAL LOAD DESIGNS, CONTACT STORMTECH FOR COMPACTION REQUIREMENTS.

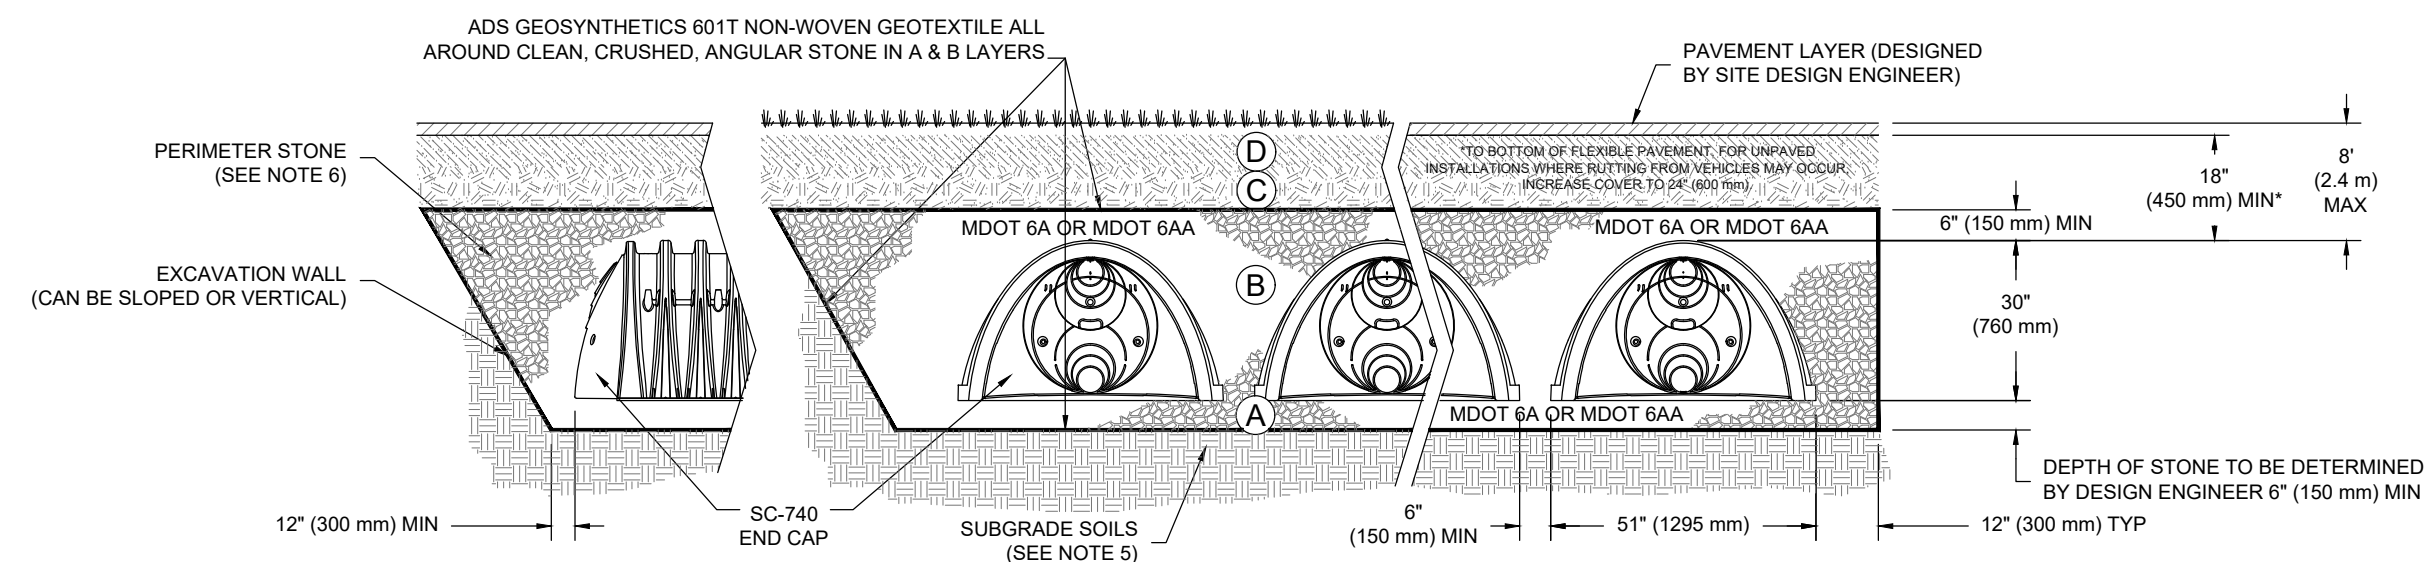

NOTES:

- SC-740 CHAMBERS SHALL CONFORM TO THE REQUIREMENTS OF ASTM F2418 "STANDARD SPECIFICATION FOR POLYPROPYLENE (PP) CORRUGATED WALL STORMWATER COLLECTION CHAMBERS" OR ASTM F2922 "STANDARD SPECIFICATION FOR POLYETHYLENE (PE) CORRUGATED WALL STORMWATER COLLECTION CHAMBERS".
- SC-740 CHAMBERS SHALL BE DESIGNED IN ACCORDANCE WITH ASTM F2787 "STANDARD PRACTICE FOR STRUCTURAL DESIGN OF THERMOPLASTIC CORRUGATED WALL STORMWATER COLLECTION CHAMBERS".
- "ACCEPTABLE FILL MATERIALS" TABLE ABOVE PROVIDES MATERIAL LOCATIONS, DESCRIPTIONS, GRADATIONS, AND COMPACTION REQUIREMENTS FOR FOUNDATION, EMBEDMENT, AND FILL MATERIALS.
- THE "SITE DESIGN ENGINEER" REFERS TO THE ENGINEER RESPONSIBLE FOR THE DESIGN AND LAYOUT OF THE STORMTECH CHAMBERS FOR THIS PROJECT.
- THE SITE DESIGN ENGINEER IS RESPONSIBLE FOR ASSESSING THE BEARING RESISTANCE (ALLOWABLE BEARING CAPACITY) OF THE SUBGRADE SOILS AND THE DEPTH OF FOUNDATION STONE WITH CONSIDERATION FOR THE RANGE OF EXPECTED SOIL MOISTURE CONDITIONS.
- PERIMETER STONE MUST BE EXTENDED HORIZONTALLY TO THE EXCAVATION WALL FOR BOTH VERTICAL AND SLOPED EXCAVATION WALLS.
- ONCE LAYER 'C' IS PLACED, ANY SOIL/MATERIAL CAN BE PLACED IN LAYER 'D' UP TO THE FINISHED GRADE. MOST PAVEMENT SUBBASE SOILS CAN BE USED TO REPLACE THE MATERIAL REQUIREMENTS OF LAYER 'C' OR 'D' AT THE SITE DESIGN ENGINEER'S DISCRETION.

STAYBRIDGE SUITES & RETAIL
ANN ARBOR, MICHIGAN
DATE: 3-24-15
DRAWN: SKR
PROJECT #: 93256
CHECKED: GFI

4640 TOLLEMAN BLVD
HILLIARD, OH 43026
1-800-733-7473

ADS
ADVANCED DRAINAGE SYSTEMS, INC.
11500 STATE ROUTE 163
MARIETTA, OH 45750

SHEET 3 OF 5

STAYBRIDGE SUITES & RETAIL
ANN ARBOR, MICHIGAN
DATE: 3-24-15
DRAWN: SKR
PROJECT #: 93256
CHECKED: GFI

4640 TOLLEMAN BLVD
HILLIARD, OH 43026
1-800-733-7473

ADS
ADVANCED DRAINAGE SYSTEMS, INC.
11500 STATE ROUTE 163
MARIETTA, OH 45750

SHEET 4 OF 5

SC-740 ISOLATOR ROW DETAIL
NTS

SC-740 INSPECTION PORT DETAIL
NTS

INSPECTION & MAINTENANCE

STEP 1) INSPECT ISOLATOR ROW FOR SEDIMENT
 A. INSPECTION PORTS (IF PRESENT)
 A.1. REMOVE/OPEN LID ON NYLOPLAST INLINE DRAIN
 A.2. REMOVE AND CLEAN FLEXSTORM FILTER IF INSTALLED
 A.3. USING A FLASHLIGHT AND STADA ROD, MEASURE DEPTH OF SEDIMENT AND RECORD ON MAINTENANCE LOG
 A.4. LOWER A CAMERA INTO ISOLATOR ROW FOR VISUAL INSPECTION OF SEDIMENT LEVELS (OPTIONAL)
 A.5. IF SEDIMENT IS AT, OR ABOVE, 3" (80 mm) PROCEED TO STEP 2; IF NOT, PROCEED TO STEP 3.
 B. ALL ISOLATOR ROWS
 B.1. REMOVE COVER FROM STRUCTURE AT UPSTREAM END OF ISOLATOR ROW
 B.2. USING A FLASHLIGHT, INSPECT DOWN THE ISOLATOR ROW THROUGH OUTLET PIPE
 B.3. MIRRORS ON POLES OR CAMERAS MAY BE USED TO AVOID A CONFINED SPACE ENTRY
 i) FOLLOW OSHA REGULATIONS FOR CONFINED SPACE ENTRY IF ENTERING MANHOLE
 ii) IF SEDIMENT IS AT, OR ABOVE, 3" (80 mm) PROCEED TO STEP 2; IF NOT, PROCEED TO STEP 3.

STEP 2) CLEAN OUT ISOLATOR ROW USING THE JET/VAC PROCESS
 A. A FIXED CULVERT CLEANING NOZZLE WITH REAR FACING SPREAD OF 45" (1.1 m) OR MORE IS PREFERRED
 B. APPLY MULTIPLE PASSES OF JET/VAC UNTIL BACKFLUSH WATER IS CLEAN
 C. VACUUM STRUCTURE SUMP AS REQUIRED

STEP 3) REPLACE ALL COVERS, GRATES, FILTERS, AND LIDS, RECORD OBSERVATIONS AND ACTIONS.

STEP 4) INSPECT AND CLEAN BASINS AND MANHOLES UPSTREAM OF THE STORMTECH SYSTEM.


NOTES

- INSPECT EVERY 6 MONTHS DURING THE FIRST YEAR OF OPERATION. ADJUST THE INSPECTION INTERVAL BASED ON PREVIOUS OBSERVATIONS OF SEDIMENT ACCUMULATION AND HIGH WATER ELEVATIONS.
- CONDUCT JETTING AND VACTORING ANNUALLY OR WHEN INSPECTION SHOWS THAT MAINTENANCE IS NECESSARY.

THE LOCATION OF ALL UNDERGROUND UTILITIES AS SHOWN ON THESE DRAWINGS ARE BASED ON RECORDS PROVIDED BY THE UTILITY OWNERS AND VISIBLE EVIDENCE OBTAINED IN THE FIELD. NO GUARANTEE IS EITHER EXPRESSED OR IMPLIED TO THE COMPLETENESS OR ACCURACY THEREOF.



Know what's below.
Call before you dig.

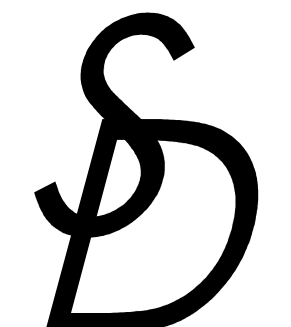

2600 AUBURN ROAD, SUITE 160
AUBURN HILLS, MI 48326
PH 810-444-7815
FX 248-553-4218

PREPARED UNDER THE DIRECTION OF:
ANDREW ANDRE, P.E.
MI #47380

APPLICANT:
LLAR HOSPITALITY ANN ARBOR, LLC
2600 AUBURN ROAD, SUITE 240
AUBURN HILLS, MI 48326
PH 248-419-5551

STAYBRIDGE SUITES & RETAIL CENTER



3860 RESEARCH PARK DRIVE ANN ARBOR, MI 48108

ISSUED FOR: 03/05/16
 UO DETENTION: 01/21/21
 SPA: 02/28/21

DATE: 03/05/16
 DRAWN: ACA
 CHECKED: GFI


SHEET 4 OF 5
 SCALE: AS NOTED
 DB NO: BD-14-322

SHEET TITLE:
UNDERGROUND DETENTION PLANS
 SHEET
C5.8

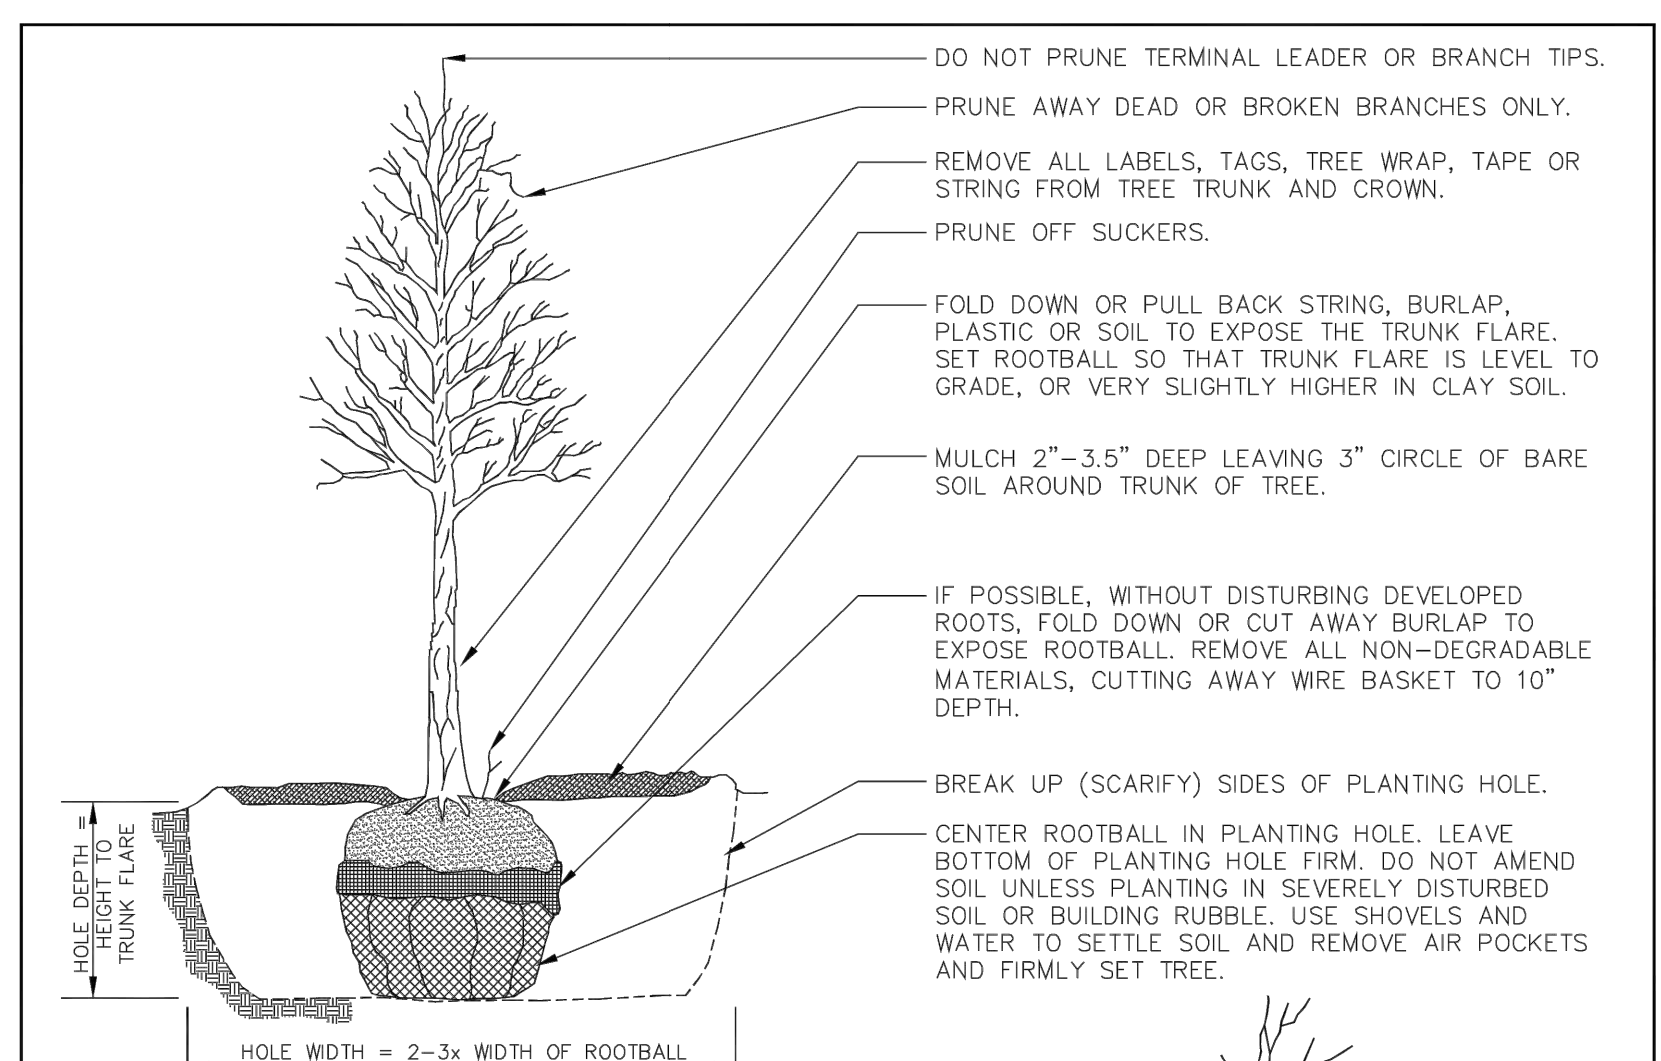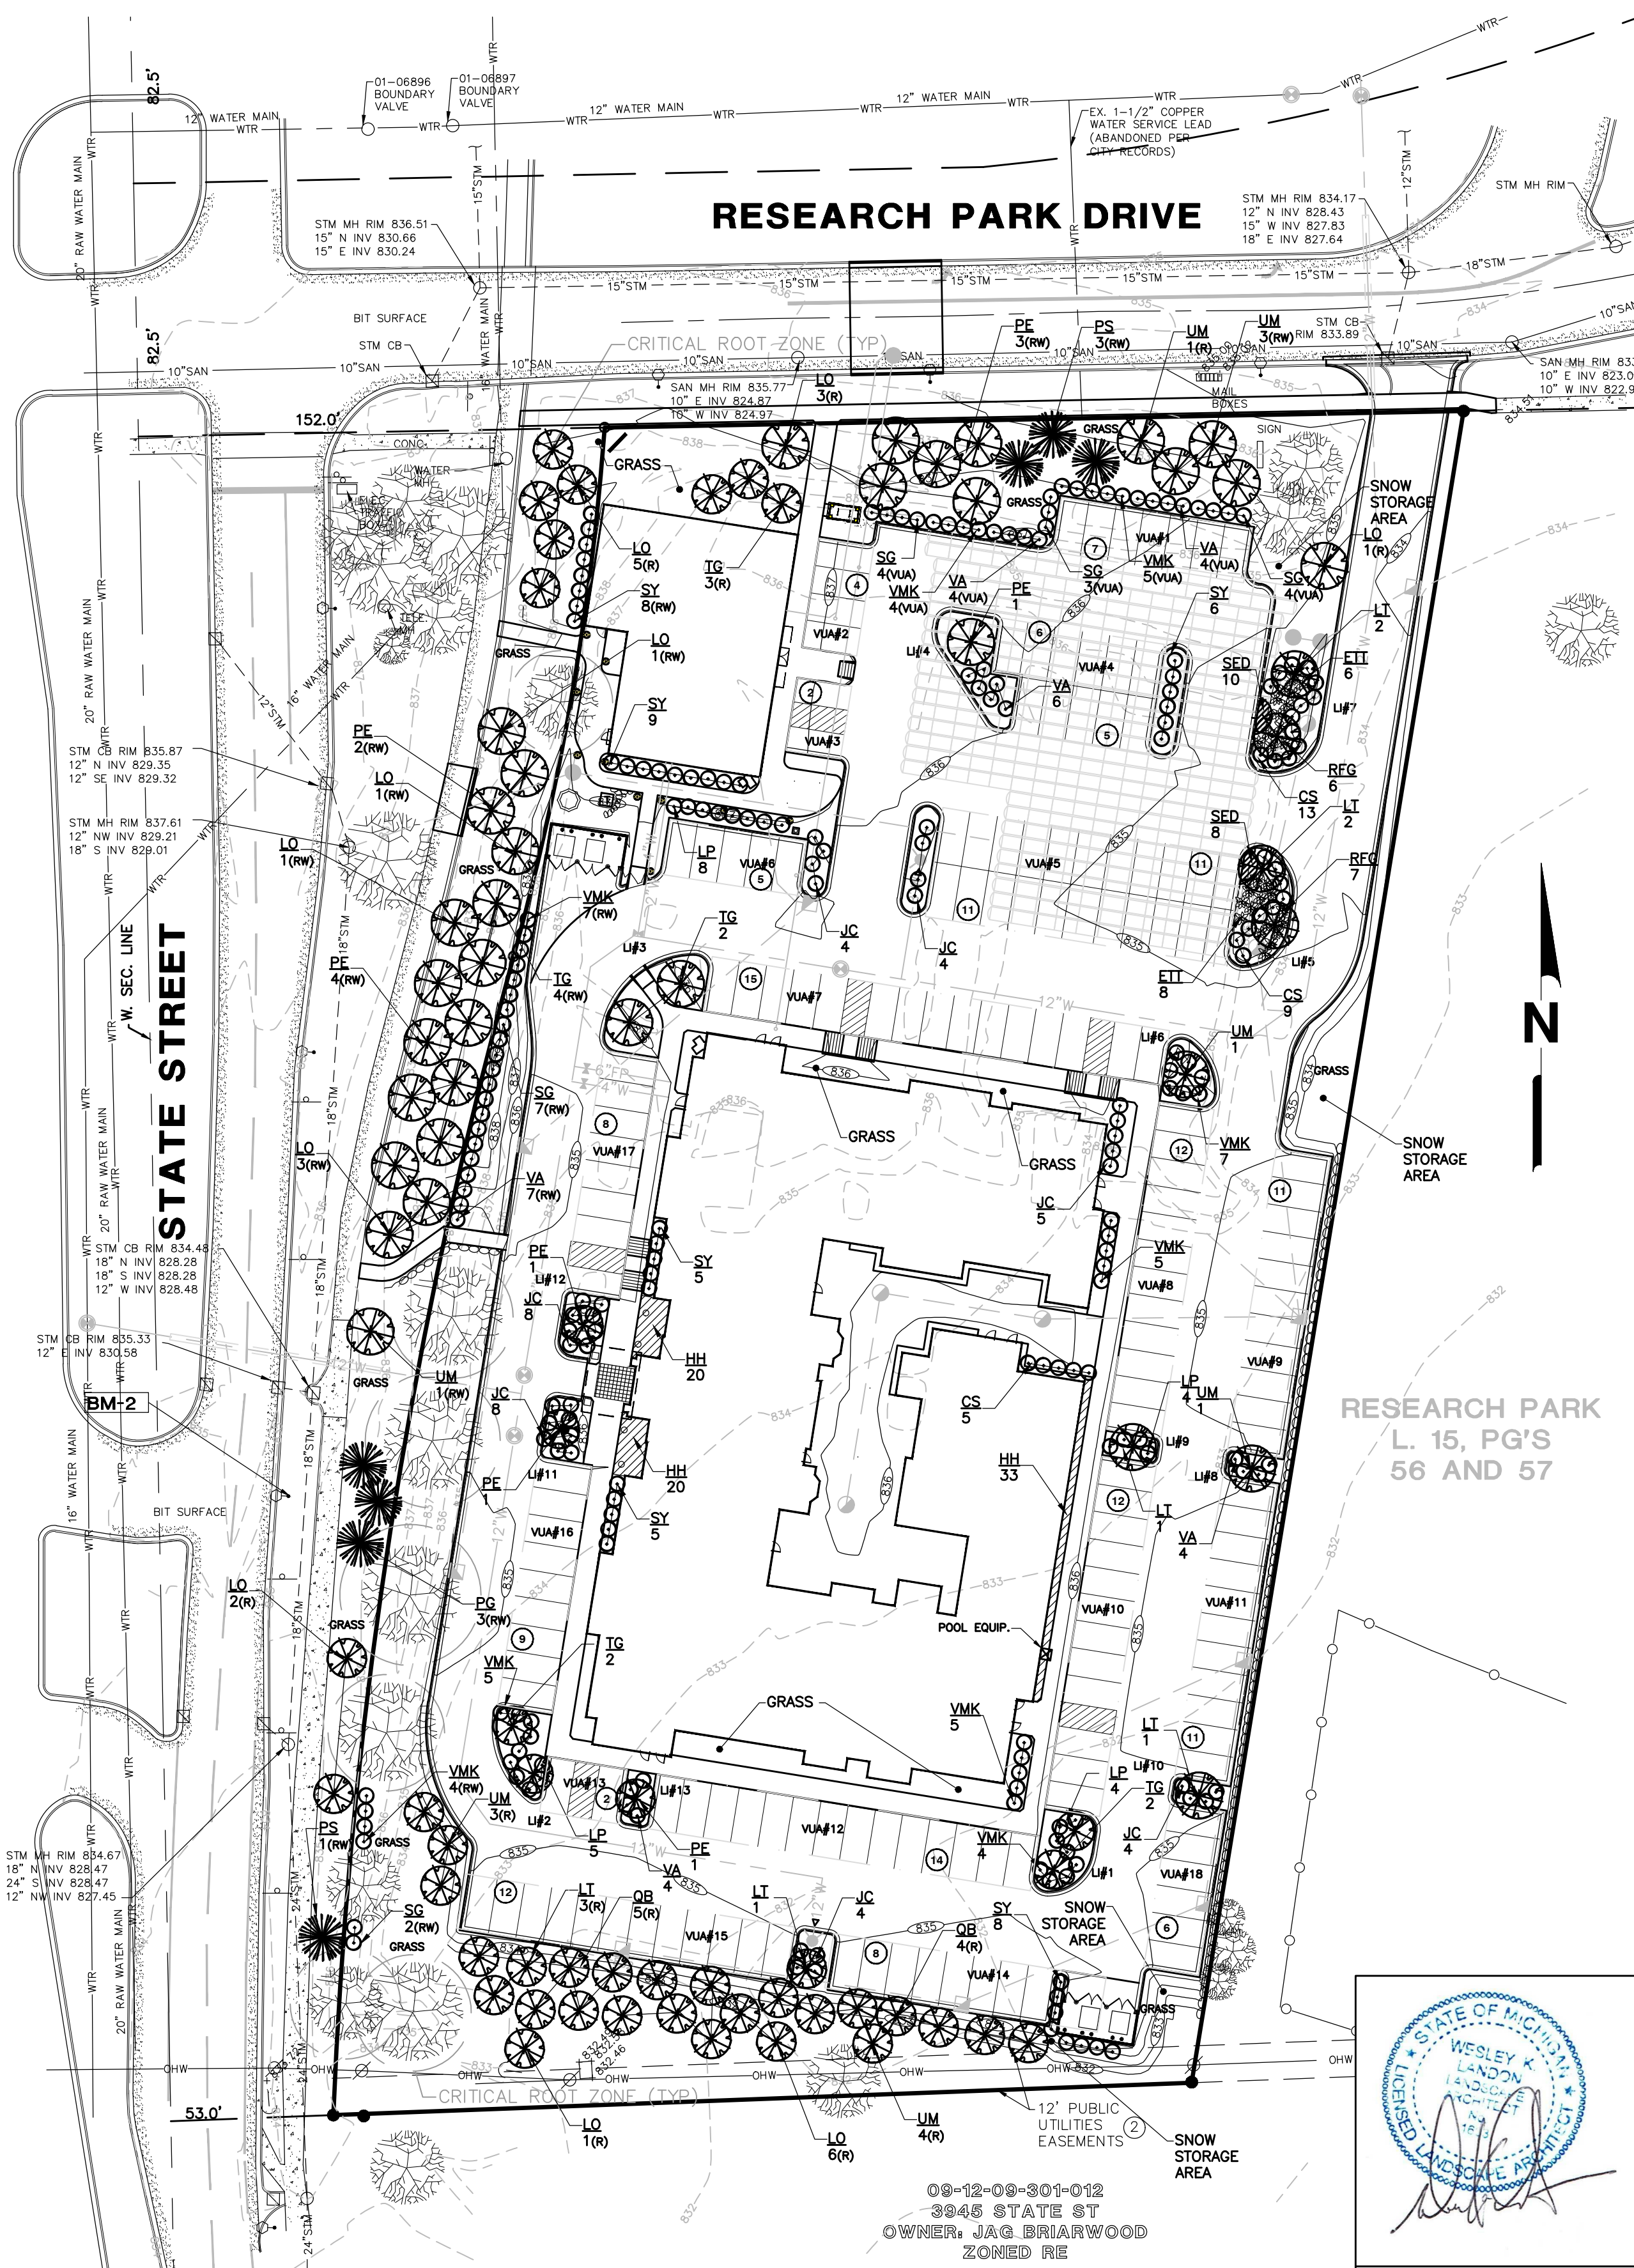

- DO NOT STAKE UNLESS IN HEAVY CLAY SOIL, WINDY CONDITIONS, 3" OR GREATER DIAMETER TREE TRUNK OR LARGE CROWN. IF STAKING IS NEEDED DUE TO THESE CONDITIONS:
- STAKE WITH 2 x 2 HARDWOOD STAKES, OR APPROVED EQUAL, DRIVEN 6"-8" OUTSIDE OF ROOTBALL.
 - LOOSELY STAKE TREE TRUNK TO ALLOW FOR TRUNK FLEXING.
 - STAKE TREES JUST BELOW FIRST BRANCH WITH 2"-3" WIDE BELT-LIKE, NYLON OR PLASTIC STRAPS (2 PER TREE ON OPPOSITE SIDES OF TREE, CONNECT FROM TREE TO STAKE HORIZONTALLY. DO NOT USE ROPE OR WIRE THROUGH A HOSE.)
 - REMOVE ALL STAKING MATERIALS AFTER 1 YEAR.

REV. NO.	DR. BY	CH. BY	DATE
REVISIONS			
PUBLIC SERVICES DEPARTMENT CITY OF ANN ARBOR			
TREE PLANTING DETAIL			
DR. BY	ARG	CH. BY	DATE
SCALE	NONE	DATE	7-23-10
INCH	1" = 10'		SHEET NO. _____ OF _____

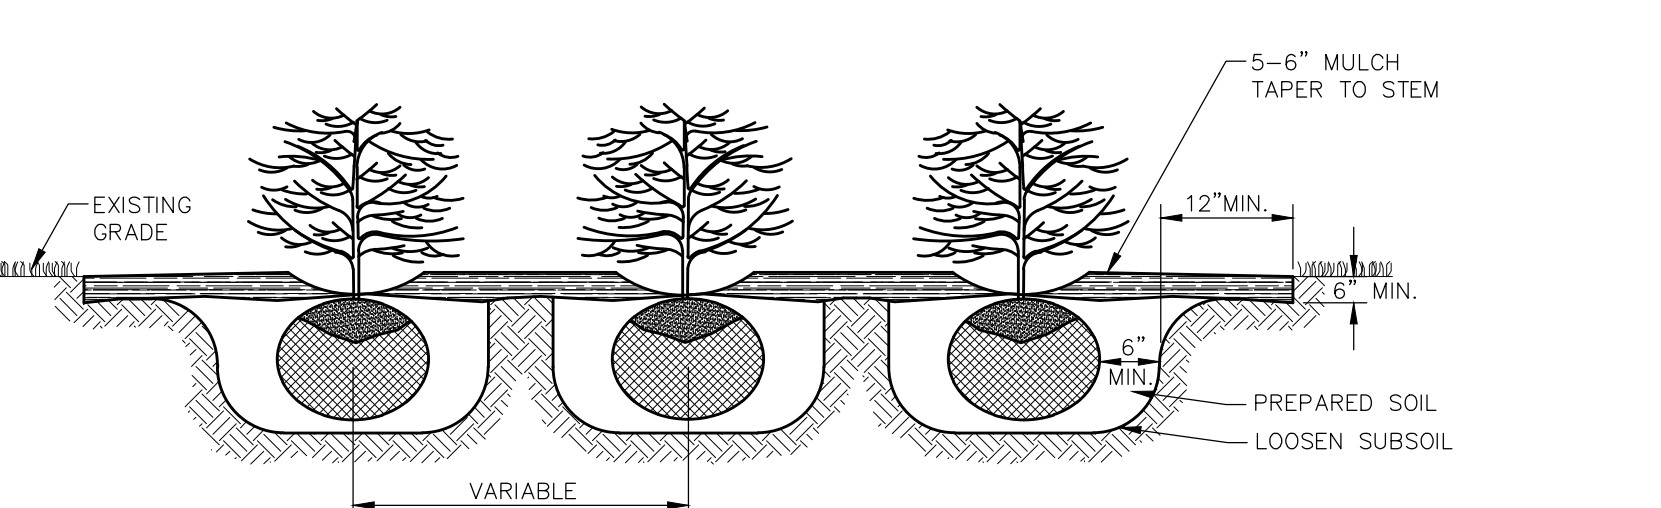

- FIRST AND SECOND WATERING AND CULTIVATION SHALL INCLUDE SHRUB BEDS.
-CUT 6" X 12" (MIN.) EDGING AROUND THE PERIMETER OF ALL SHRUB BEDS SHOWN ON THE PLANS. SPRAY A NON-PERSISTENT GLYPHOSATE HERBICIDE TO ENTIRE SHRUB BEDS PRIOR TO PLANTING AND BARK PLACEMENT.
-SHRUB BEDS ARE TO BE PAID FOR BY THE PAY ITEM "SITE PREPARATION".
-ALL PLANTS SHALL BE SET PLUMB AND HAVE THE BEST SIDE OF PLANT FACING THE MAIN VIEWING DIRECTION.

SHRUB BED DETAIL
SCALE: NONE

QUANTITY	KEY	BOTANICAL NAME	COMMON NAME	SIZE
73	HH	HEMEROCALLIS 'HAPPY RETURNS'	HAPPY RETURNS DAYLILLY	#1 POT
18	SED	SEDUM X. 'NEON'	NEON SEDUM	#1 POT
14	EIT	ECHINACEA 'TIKI TORCH'	TIKI TORCH ORANGE CONEFLOWER	#1 POT
13	RFG	RUBRIBECKIA FULGIDA S. 'GOLDSTRUM'	GOLDSTRUM ORANGE CONEFLOWER	#1 POT
27	CS	CORNUS SERICEA	RED TWIG DOGWOOD	24" HT B&B
41	SY	TAXUS S.M. 'SEBIAN'	SEBIAN YEW	24" HT B&B
21	LP	SPIRAEA JAPONICA 'LITTLE PRINCESS'	LITTLE PRINCESS SPIRAEA	24" HT B&B
20	SG	SPIRAEA JAPONICA 'GOLDFLAME'	GOLDFLAME SPIRAEA	24" HT B&B
46	VNK	VIBURNUM X.B. 'MOHAWK'	MOHAWK VIBURNUM	24" HT B&B
29	VA	VIBURNUM DENTATUM	ARROWWOOD VIBURNUM	24" HT B&B
37	JC	JUNIPERUS C. 'SEAGREEN'	SEA GREEN JUNIPER	24" HT B&B
4	PS	PINUS STROBUS	EASTERN WHITE PINE	8' HT.
3	PG	PICEA GLAUCA	WHITE SPRUCE	8' HT.
14	UM	ULMUS AMERICANA 'VALLEY FORGE'	VALLEY FORGE AMERICAN ELM	2" CAL B&B
24	LO	GLEDITSIA T. INERMIS 'SKYCOLE'	SKYLINE LOCUST	2-1/2" CAL B&B
13	TG	TILIA CORDATA 'GREENSPIRE'	GREENSPIRE LINDEN	2" CAL B&B
10	LT	LIRIODENDRON TULIPIFERA	TULIPTREE	2" CAL B&B
9	QB	QUERCUS BICOLOR	SWAMP WHITE OAK	2" CAL B&B
13	PE	PLATANUS X EXCLAMATION	LONDON PLANETREE	2" CAL B&B

LI#	S.F.
1	409
2	444
3	604
4	534
5	586
6	300
7	567
8	165
9	165
10	165
11	275
12	275
13	165
14	214
	4868

VUA#	S.F.
1	1134
2	648
3	432
4	1782
5	3563.41
6	816.1
7	2717.70
8	1948.09
9	1781.8
10	2087.54
11	1943.78
12	2267.53
13	467.95
14	1619.64
15	1952.57
16	1466.67
17	1421.68
18	971.91
	29022.37

Total =	29,022.37
Use Ratio =	20
Req. S.F. =	1452
DEPRESSED BIORETENTION	
Req. % =	50%
Area =	1452
Req Area =	726
UTILIZE ISLANDS	
5	586
7	567
Total Prov. =	1153

STREET TREE ESCROW CALCULATION	
SOUTH STATE STREET	
558 LF ROADWAY	
12 # EX. TREES	
45 LF DEDUCT / TREE	
540 DEDUCT	
18 LF	
\$ 1.30 RATE	
\$ 23.40 ESCROW	
RESEARCH PARK DRIVE	
280 LF ROADWAY	
2 # EX. TREES	
45 LF DEDUCT / TREE	
90 DEDUCT	
190 LF	
\$ 1.30 RATE	
\$ 247.00 ESCROW	

SOUTH STATE STREET RIGHT-OF-WAY LANDSCAPING
1 TREE / 30 L.F. OF FRONTAGE
558 L.F. / 30 = 18.6 = 19 TREES
R.O.W. LANDSCAPING REQUIRED = 19 TREES
R.O.W. LANDSCAPING PROVIDED = 21 TREES

(RW) = RIGHT-OF-WAY TREES
RESEARCH PARK DRIVE RIGHT-OF-WAY LANDSCAPING
1 TREE / 30 L.F. OF FRONTAGE
280 L.F. / 30 = 9.3 = 9 TREES
R.O.W. LANDSCAPING REQUIRED = 9 TREES
R.O.W. LANDSCAPING PROVIDED = 9 TREES

(RW) = RIGHT-OF-WAY TREES
VEHICULAR USE AREA LANDSCAPING
1 SHRUB / 4 L.F. OF V.U.A. FRONTAGE
64 L.F. / 4 = 16 SHRUBS
V.U.A. LANDSCAPING REQUIRED = 16 SHRUBS
V.U.A. LANDSCAPING PROVIDED = 16 SHRUBS

(VUA) = VEHICULAR USE AREA RIGHT-OF-WAY PLANTINGS
GENERAL NOTES

- CONTRACTOR TO PROVIDE DESIGN AND INSTALLATION OF UNDERGROUND IRRIGATION SYSTEM IN ACCORDANCE WITH PROJECT SPECIFICATIONS AND REGULATORY AGENCY REQUIREMENTS. ALL LANDSCAPING AND GRASS AREAS TO BE IRRIGATED. IRRIGATION CONTROL PANEL SHALL BE LOCATED WITHIN THE HVAC ENCLOSURE.
- ALL GREEN SPACES AND PLANTING AREAS SHALL BE IRRIGATED.
- IT IS THE CONTRACTOR'S RESPONSIBILITY TO SECURE ALL PERMITS AND POST ALL BONDS PRIOR TO CONSTRUCTION.
- REFER TO PLUMBING PLANS FOR LOCATION OF IRRIGATION METER.
- ALL GRASS AREAS TO BE SOODED.
- SPACE ALL SHRUBS AT 5- FEET ON CENTER UNLESS OTHERWISE INDICATED ON THE PLANS
- ALL DISTURBED LAWN AREAS SHALL BE RESTORED TO AT LEAST PREVIOUS CONDITION IN ACCORDANCE WITH PROJECT SPECIFICATIONS.
- THE GENERAL CONTRACTOR SHALL INCLUDE TOPSOIL IN BASE BID. NO GUARANTEE IS EITHER EXPRESSED OR IMPLIED AS TO THE AMOUNT OF TOPSOIL AVAILABLE ON-SITE.

DESCRIPTION
THIS WORK SHALL CONSIST OF PROVIDING ALL NECESSARY MATERIALS, LABOR, EQUIPMENT, TOOLS AND SUPERVISION REQUIRED FOR THE EXECUTION AND GUARANTEE OF ALL PLANTINGS AND RELATED WORK AS SHOWN ON THE DRAWINGS.
PLANT MATERIALS SHALL CONFORM TO THE SIZES STATED ON THE PLANT LIST AND SHALL BE OF A MINIMUM SIZE OR LARGER. ALL MEASUREMENTS OF SPREAD, CALIPER, BALL SIZE, TRUNK CROWN RATIO, QUALITY DESIGNATIONS, ETC., SHALL BE IN ACCORDANCE WITH THE LATEST EDITION OF THE "ANSI STANDARDS FOR NURSERY STOCK". PLANT MATERIAL SHALL BE NURSERY GROWN AND INSPECTED BY THE OWNER'S REPRESENTATIVE AT THE SITE PRIOR TO PLANTING. THE OWNER'S REPRESENTATIVE RESERVES THE RIGHT TO REJECT ANY PLANT MATERIAL AT ANY TIME.

NURSERY STOCK SHALL BE PREPARED FOR SHIPMENT IN ACCORDANCE WITH THE REQUIREMENTS OF THE CURRENT ANSI SPECIFICATION 260.1 AND SHALL BE ENCLOSED OR COVERED DURING TRANSPORTATION TO PREVENT DRYING.

SITE PREPARATION
THE CONTRACTOR SHALL VERIFY ALL EXISTING AND PROPOSED UTILITY LOCATIONS PRIOR TO CONSTRUCTION AND PROTECT AND REPAIR UTILITIES ENCOUNTERED DURING CONSTRUCTION WHETHER SHOWN ON THE PLANS OR NOT.

INDIVIDUAL HOLES SHALL BE CENTERED AT STAKED PLANT LOCATIONS. CONTRACTOR IS TO STAKE PRIOR TO PLACEMENT OF PLANT MATERIAL AND OBTAIN APPROVAL FROM THE OWNER'S REPRESENTATIVE. PLANTING HOLES SHALL BE DUG LARGE ENOUGH TO PERMIT PLACING PREPARED TOPSOIL 18" LATERALLY BEYOND THE ENDS OF THE ROOT BALLS FOR SHADE AND EVERGREEN TREES AND 6" LATERALLY FOR SHRUBS UNLESS OTHERWISE SPECIFIED.

EXCAVATED MATERIAL SHALL BE REMOVED FROM THE SITE AT THE TIME THE HOLE IS DUG. THE PLANTING HOLE SHALL BE BACKFILLED WITH PREPARED TOPSOIL THE SAME DAY THEY ARE DUG.

TOPSOIL SHALL AT FERTILE, FRIABLE, NATURAL TOPSOIL OF CLAY LOAM CHARACTER CONTAINING AT LEAST 5% BUT NOT MORE THAN 20% BY WEIGHT OF ORGANIC MATTER WITH A PH RANGE FROM 6.0 TO 7.0. TOPSOIL SHALL BE FREE OF CLAY LUMPS, COARSE SAND, STONES, PLANT ROOTS, STICKS OR OTHER FOREIGN MATTER.

CARE FOR PLANTS BEFORE PLANTING
PLANTS DESIGNATED "BB" SHALL BE BALLED AND BURLAPPED WITH FIRM NATURAL BALLS OF EARTH. CRACKED, LOOSENEED OR BROKEN BALLS SHALL NOT BE PLANTED. THEY SHALL BE MARKED WITH SPRAY PAINT AND IMMEDIATELY REMOVED FROM THE JOB SITE. IMMEDIATELY FOLLOWING DELIVERY AT THE JOB SITE, ALL PLANTS THAT WILL NOT BE PLANTED THAT SAME DAY SHALL BE "HEELED IN" WITH SHREDDED BARK OR MOIST SOIL AND KEPT MOIST UNTIL PLANTED.

THE TRUNKS AND BRANCHES OF ALL TREES SHALL BE PROTECTED FROM INJURY OF ANY KIND DURING ALL OPERATIONS. THE OWNER'S REPRESENTATIVE SHALL REJECT ANY TREES THAT ARE INJURED.

PLANTING
THE CONTRACTOR IS RESPONSIBLE FOR PLANTING MATERIALS PLUMB. SET THE TOP OF THE ROOT BALL AT OR SLIGHTLY HIGHER THAN THE SURROUNDING GRADE. PLANTS SHALL BE FACED TO GIVE THE BEST APPEARANCE OR RELATIONSHIP TO ADJACENT STRUCTURES. NO FILLING WILL BE PERMITTED AROUND TRUNK OR STEMS. WHEN THE PLANT HAS BEEN PROPERLY SET, THE HOLE SHALL BE BACKFILLED TO 1/2 THE DEPTH OF THE BALL WITH PREPARED TOPSOIL MIXTURE, FIRMLY PACKED AND WATERED-IN AT TIME OF PLANTING. LOOSED AND REMOVE BURLAP AND LACING FROM UPPER 1/3 OF THE ROOT BALL. BACKFILL WITH PREPARED TOPSOIL, WHICH AFTER COMPACTION IS FLUSH WITH THE SURROUNDING GROUND.


MULCHING
ALL PLANT MATERIAL SHALL BE ENCLOSED WITH A COVERING OF NON-DYED SHREDDED BARK MULCH TO 6" OUTSIDE THE PLANTING HOLE. MULCH SHALL NOT BE TOUCHING THE TRUNK OF ANY TREE. SUBMIT SAMPLE TO THE OWNER'S REPRESENTATIVE FOR APPROVAL BEFORE PLACEMENT. WOOD CHIPS SHALL NOT BE ALLOWED ON THIS JOB. MULCHING SHALL FOLLOW THE CITY OF ANN ARBOR PLANTING DETAILS.

STEEL LANDSCAPE EDGING
4" STEEL LANDSCAPE EDGING SHALL BE USED ON THIS PROJECT. ALUMINUM OR PLASTIC EDGING WILL NOT BE ALLOWED.

PRUNING
UPON COMPLETION, ONLY PRUNE DEAD OR BROKEN BRANCHES FROM TREES. THE AMOUNT OF PRUNING SHALL BE LIMITED TO THE MINIMUM NECESSARY TO REMOVE DEAD OR INJURED BRANCHES. PRUNING PAINT SHALL NOT BE USED.

FINISHING AND CLEANING UP
IMMEDIATELY UPON COMPLETION OF THE WORK, THE CONTRACTOR SHALL CLEAN UP THE AREA OF SURPLUS MATERIALS. THE CONTRACTOR SHALL REPAIR AND RE-ESTABLISH TURF IN RUTTED AREAS.

WARRANTY
THE LANDSCAPE INSTALLATION CONTRACTOR SHALL REPLACE ALL UNHEALTHY VEGETATION AND PLANTINGS WITHIN ONE (1) YEAR OF INITIAL PLANTING OR SUBSEQUENT PLANTING PERIOD.

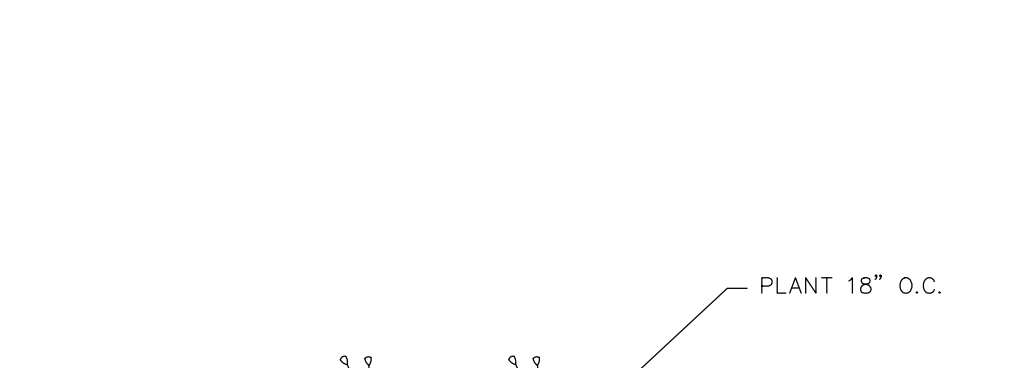

SCALE: NONE

CITY OF ANN ARBOR LANDSCAPE NOTES
LANDSCAPE CONTRACTOR SHALL REFER TO CITY OF ANN ARBOR LANDSCAPE AND SCREENING ORDINANCE (CHAPTER 62)

PERENNIAL PLANTING BED
SCALE: NONE

- COMPACTED SOILS SHALL BE SCARIFIED TO A DEPTH OF 6" TO ELIMINATE ANY SOIL COMPACTION CREATED DURING CONSTRUCTION.
- ALL DISEASED, DAMAGED, OR DEAD MATERIAL SHALL BE REPLACED IN ACCORDANCE WITH CHAPTER 62 BY THE END OF THE FOLLOWING PLANTING SEASON.
- SNOW STORAGE AREAS ARE INDICATED ON THE PLAN. SNOW SHALL NOT BE PUSHED ON TO THE INTERIOR LANDSCAPE ISLANDS.
- THE CITY OF ANN ARBOR HAS ADOPTED AN ORDINANCE LIMITING PHOSPHORUS IN FERTILIZER. TO ASSIST IN COMPLIANCE WITH THE STATE MANDATED TOL FOR PHOSPHORUS WITHIN THE MIDDLE HURON RIVER BASIN, APPLICATIONS OF FERTILIZER BEYOND THE INITIAL TOPSOIL AND SEEDING SHALL BE A FERTILIZER WITH NO PHOSPHORUS.

STELLAR DEVELOPMENT, LLC
2600 AUBURN ROAD, SUITE 140
AUBURN HILLS, MI 48326
PH 810-444-7815
FX 248-553-4218
PREPARED UNDER THE DIRECTION OF:
ANDREW ANDRE, P.E.
MI #47380

APPLICANT:
STELLAR HOSPITALITY ANN ARBOR, LLC
2600 AUBURN ROAD, SUITE 240
AUBURN HILLS, MI 48326
PH 248-419-5551

STAYBRIDGE SUITES & RETAIL CENTER
3860 RESEARCH PARK DRIVE
ANN ARBOR, MI 48108


THIS PLAN AND ALL INFORMATION CONTAINED HEREIN ARE THE PROPERTY OF STELLAR DEVELOPMENT, LLC. NO PART OF THIS PLAN OR INFORMATION SHALL BE REPRODUCED OR TRANSMITTED IN ANY FORM OR BY ANY MEANS, ELECTRONIC OR MECHANICAL, INCLUDING PHOTOCOPYING, RECORDING, OR BY ANY INFORMATION STORAGE AND RETRIEVAL SYSTEM, WITHOUT THE WRITTEN PERMISSION OF STELLAR DEVELOPMENT, LLC. THE INFORMATION CONTAINED HEREIN IS FOR THE EXCLUSIVE USE OF THE APPLICANT AND IS NOT TO BE USED FOR ANY OTHER PROJECT OR PURPOSE. THE INFORMATION CONTAINED HEREIN IS NOT TO BE USED FOR ANY OTHER PROJECT OR PURPOSE. THE INFORMATION CONTAINED HEREIN IS NOT TO BE USED FOR ANY OTHER PROJECT OR PURPOSE.

ISSUED FOR	DATE
SPA	12/29/14
SPA	02/20/15
SPA	03/23/15
SPA	04/23/15
PERMITS	06/12/15
SPA	08/17/15
CONST PLANS	09/05/15
CONST PLANS	10/02/15
CONST PLANS	11/05/15
CONST PLANS	12/09/15
UD DETENTION	03/06/16
LANDSCAPE REV.	04/04/17
LANDSCAPE REV.	04/07/17
SPA	01/21/21
SPA	02/28/21

DATE: _____
DRAWN: ACA
CHECKED: _____
SCALE: 1"=40'
JOB NO: BD-14-322
SHEET TITLE:
LANDSCAPE PLAN AND DETAILS
SHEET
L1.0

811
Know what's below.
Call before you dig.

THE LOCATION OF ALL UNDERGROUND UTILITIES AS SHOWN ON THESE DRAWINGS ARE BASED ON RECORDS PROVIDED BY THE UTILITY OWNERS AND VISIBLE EVIDENCE OBTAINED IN THE FIELD. NO GUARANTEE IS EITHER EXPRESSED OR IMPLIED TO THE COMPLETENESS OR ACCURACY THEREOF.

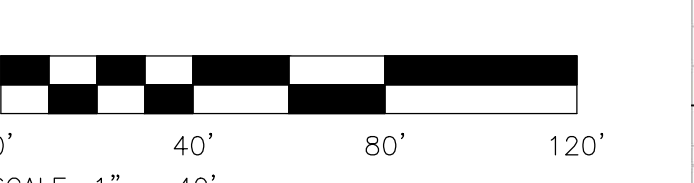

LANDMARK TREE REPLACEMENT CALCULATIONS

Tree	dbh
2421	21
2422	24
2423	19
2424	17
2426	23
2427	21
2440	18
2441	20
2444	19

182 INCHES Caliper replacement required
50% Replacement Ratio (50% DBH)
91 Required Caliper (inches) Replacement

WESLEY K. LANDON, ASLA
LANDSCAPE ARCHITECT
NATIVE EDGE, LLC
PO BOX 140021
GRAND RAPIDS, MI 49514