

B R (i)

Beckett&Raeder

Landscape Architecture Planning, Engineering and Environmental Services

Beckett & Raeder, Inc. 535 West William, Suite 101 Ann Arbor, MI 48103

734 **663.2622** ph 734 **663.6759** fx

University of MI Golf Course Richard L. Postma Family Clubhouse

500 Stadium Blvd Ann Arbor, MI 48104

U of MI Proj Number: P00008400 U of MI Bldg Number: 1005385

Terms & Conditions for Document Use

PROPERTY OF THE UNIVERSITY OF MICHIGAN – SUBJECT TO RESTRICTIONS.

These plans are the confidential property of the University of Michigan. These plans have been provided to you for the limited purpose of bidding and/or providing construction work at the University of Michigan. You acknowledge that these plans are the confidential property of the University of Michigan. You will keep the plans confidential and will not discuss with or provide these plans to any third party, other than those employees, subcontractors or consultants who are essential to the completing your bid and/or work. Unless your company is selected to perform a part the work, you will destroy all copies of the plans within 90 days of the bid due date.

Project Status

SEAL

DATE

08/19/21


1315.00


PROJ. NO.

AS-BUILT QUANTITIES


TITLE

SHEET NO.

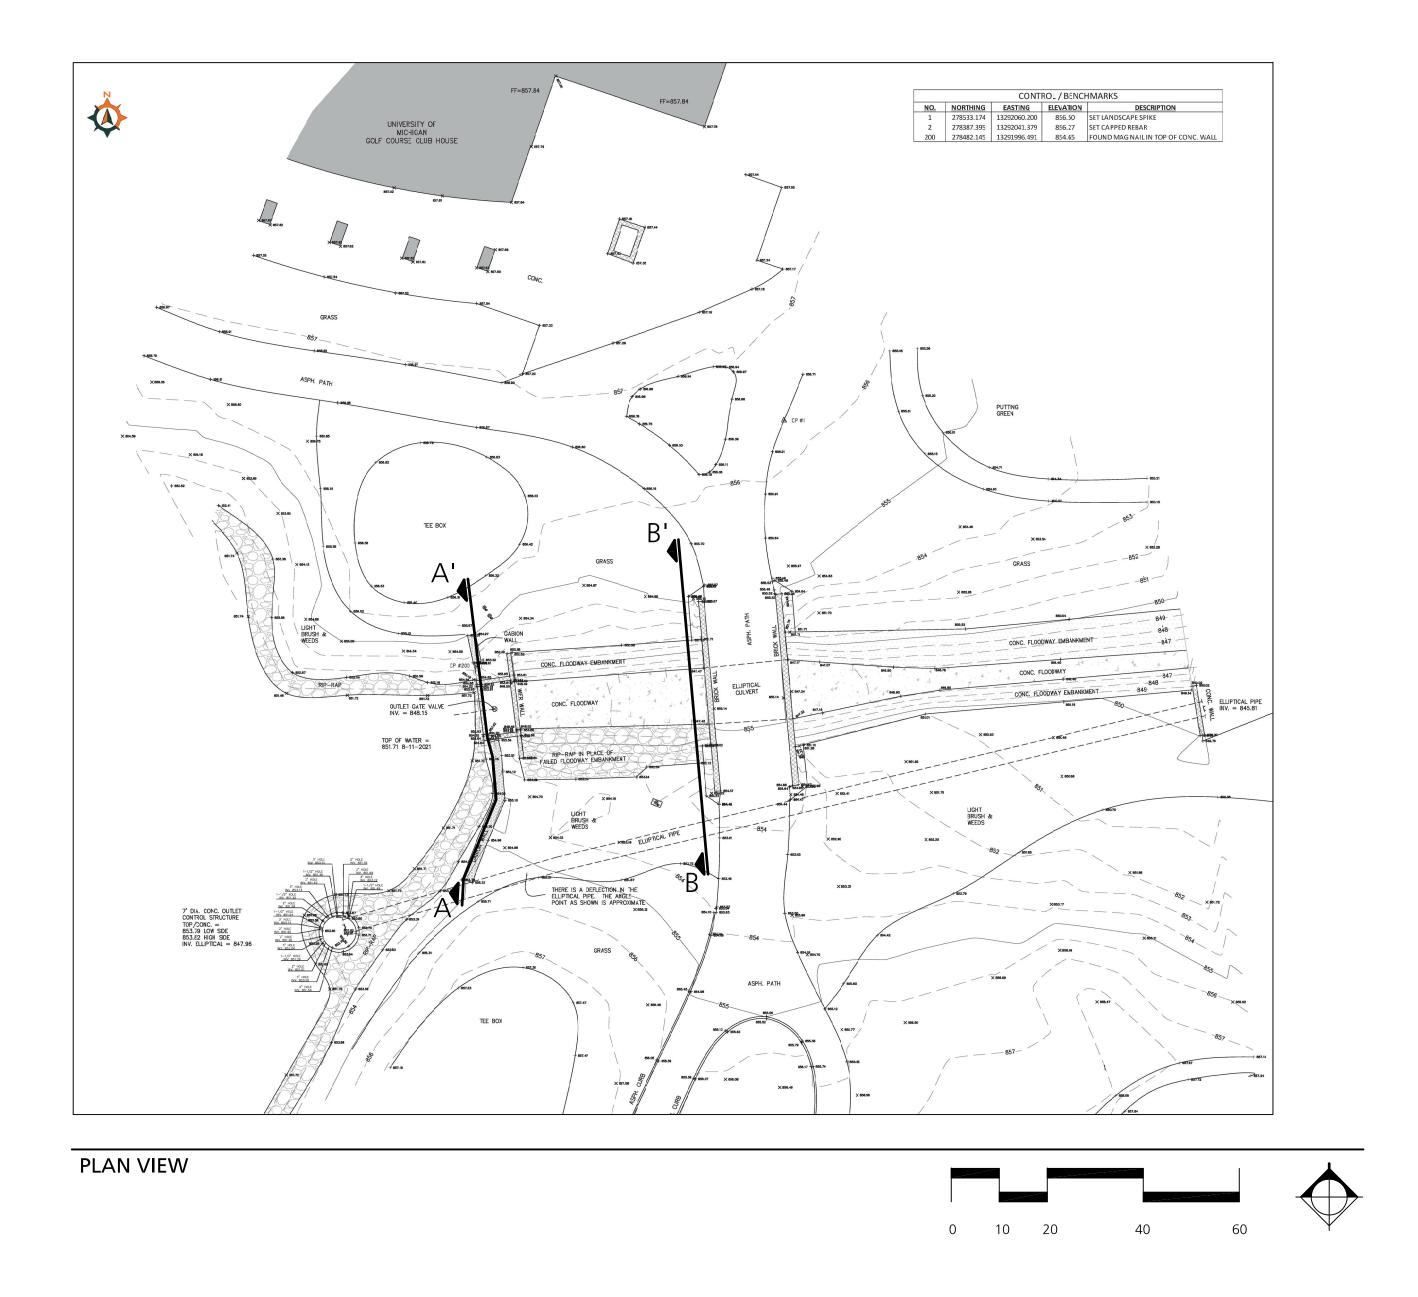

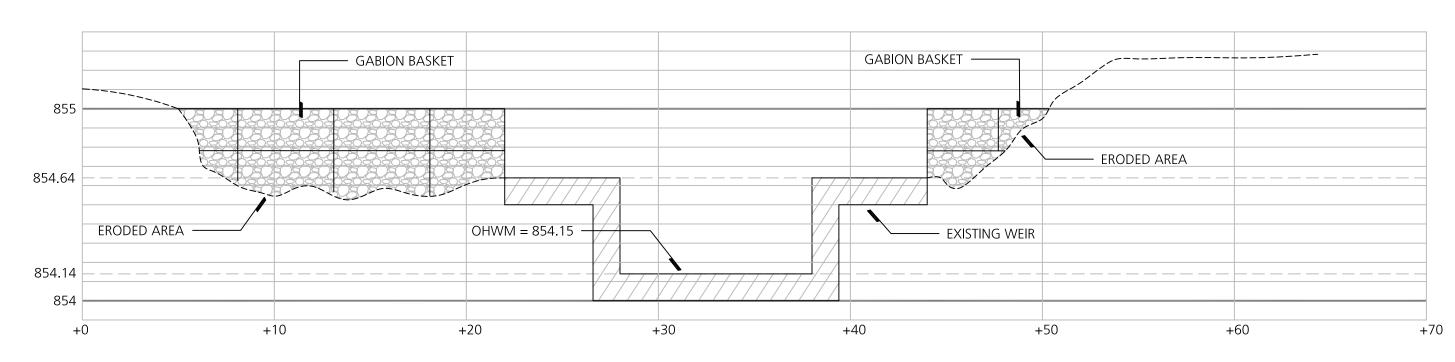



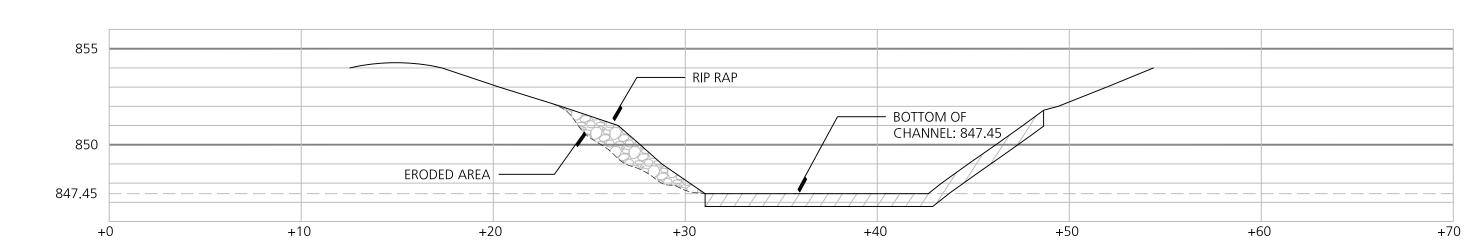

Concrete Channel Cross Section B-B' (Looking West)

SCALE: HORIZONTAL 1"=5'-0" VERTICAL 1"=5'-0"

B R i

Beckett&Raeder

Landscape Architecture
Planning, Engineering &
Environmental Services

Beckett & Raeder, Inc. 535 West William, Suite 101 Ann Arbor, MI 48103 734 663.2622 ph 734 663.6759 fx

Consultant

Seal

University of Michigan Golf Course Creek Channel

Ann Arbor, MI

Sheet Title

Cross Sections

Dates

Dates Issued for

00.00.00 Issued for

1" = 10'

Quality Control

Drawn: XX
Checked: XX
Approved: XX

Project Numb P0008400

Sheet Number

EGLE-WRD WRP031643 v1.0 Approved Issued On:11/22/2021 Expires On:11/22/2026