

# STAYBRIDGE SUITES & RETAIL CENTER

3850 RESEARCH PARK DRIVE

CITY OF ANN ARBOR, WASHTENAW COUNTY, MICHIGAN

SITE PLAN APPROVAL FOR PLANNING COMMISSION  
CONSTRUCTION PLANS

PROPERTY OWNER/  
PETITIONER / APPLICANT

STELLAR HOSPITALITY ANN ARBOR, LLC  
2600 AUBURN ROAD, SUITE 240  
AUBURN HILLS, MI 48326

CONTACT: JIMMY ASMAR  
PHONE: (248) 419-5555

CIVIL ENGINEER

STELLAR DEVELOPMENT, LLC  
2600 AUBURN ROAD, SUITE 160  
AUBURN HILLS, MI 48326

CONTACT: ANDREW ANDRE, P.E.  
PHONE: (810) 444-7815



STELLAR DEVELOPMENT, LLC

2600 AUBURN ROAD, SUITE 160  
AUBURN HILLS, MI 48326  
PH 810-444-7815  
FX 248-553-4218

PREPARED UNDER THE DIRECTION OF:  
ANDREW ANDRE, P.E.  
MI #47380

APPLICANT:  
STELLAR HOSPITALITY ANN ARBOR, LLC  
2600 AUBURN ROAD, SUITE 240  
AUBURN HILLS, MI 48326  
PH 248-419-5551

STAYBRIDGE SUITES & RETAIL CENTER  
3850 RESEARCH PARK DRIVE  
ANN ARBOR, MI 48108

## DEVELOPMENT PROGRAM

- A) THE PROPOSED LAND USE IS ZONED RE AND IS MASTERPLANNED FOR MIXED USE (COMMERCIAL/OFFICE/RESIDENTIAL) IN ACCORDANCE WITH THE "SOUTH STREET CORRIDOR PLAN" ADOPTED BY CITY PLANNING COMMISSION ON MAY 21, 2013 AND CITY COUNCIL ON JULY 15, 2013. THIS PROJECT CONSISTS OF THE DEMOLITION OF AN EXISTING BUILDING AND CONSTRUCTION OF AN EXTENDED STAY HOTEL AND RETAIL CENTER FOR A MIXED USE COMMERCIAL DEVELOPMENT. THIS PROJECT INCLUDES NEW LANDSCAPING AND STORM WATER IMPROVEMENTS. PARKING AND DENSITY CALCULATIONS ARE PROVIDED ON THE SITE LAYOUT AND PAVING PLAN INCLUDED WITHIN THIS SET.
- B) THERE IS NO PROPOSED PHASING. THE ESTIMATED CONSTRUCTION COST IS IN THE RANGE OF \$6,000,000.
- C) THE SUBMISSION IS FOR A PLANNED PROJECT.

## COMMUNITY ANALYSIS

- A) THIS PROJECT WILL NOT HAVE AN IMPACT ON THE PUBLIC SCHOOLS.
- B) THE RELATIONSHIP OF THIS PROJECT TO THE NEIGHBORING USE SHOULD NOT CHANGE.
- C) THERE SHOULD BE NO CHANGE TO ADJACENT USES.
- D) THIS PROJECT WILL NOT CHANGE THE AIR QUALITY, IT WILL IMPROVE STORMWATER MANAGEMENT BY PROVIDING DETENTION THAT IS NOT CURRENTLY PROVIDED FOR ON THE PROPERTY, IT WILL IMPROVE THE NATURAL FEATURES WITH NEW LANDSCAPING.
- E) THIS PROJECT IS NOT LOCATED WITHIN A HISTORIC DISTRICT AND WILL NOT IMPACT ANY KNOWN HISTORIC SITES OR STRUCTURES.

## NATURAL FEATURES STATEMENT OF IMPACT

THE IMPACT UPON THE NATURAL FEATURES WILL BE MINIMAL SINCE THE PROPERTY HAS PREVIOUSLY BEEN DEVELOPED. THERE ARE SOME ANTICIPATED REMOVAL OF TREES ON THE PROPERTY, HOWEVER REPLACEMENT TREES AND LANDSCAPE IMPROVEMENTS WILL BE PROVIDED FOR. THE EXISTING CONDITIONS ARE CONTINUING TO DETERIORATE, THEREFORE RE-DEVELOPMENT OF THE PROPERTY WILL IMPROVE THE CURRENT CONDITIONS. BASED ON THE TREE INVENTORY CONDUCTED BY ERIC OLSON, RLA, THERE ARE NOT WOODLANDS ON THE PROPERTY. THERE ARE A TOTAL OF 66 TREES IDENTIFIED ON THE PROPERTY, OF WHICH 17 ARE NOT REGULATED, 30 ARE REGULATED AS LANDMARK TREES. THERE IS AN ENCROACHMENT INTO THE CRITICAL ROOT ZONE OF THE PROTECTED LANDMARK TREES, HOWEVER THE EXISTING SITE HAS PAVEMENT WITHIN THE CRITICAL ROOT ZONE OF THE TREES. THE PROPOSED DEVELOPMENT ACTIVITIES WILL KEEP THE ENCROACHMENT AT THE SAME LOCATION. REMOVAL OF 9 LANDMARK TREES ARE PROPOSED AND THE REMAINING TREES WILL BE PROTECTED BY THE USE OF PERIMETER PLASTIC MESH FENCING PLACED AT THE DRIP LINE OF THE TREES.

## TRAFFIC STATEMENT


THE TRAFFIC IMPACT STUDY WILL BE SUBMITTED UNDER SEPARATE COVER.

## STATEMENT OF INTEREST

THE APPLICANT IS THE OWNER OF THE PROPERTY.

## SITE ANALYSIS

- A) THE EXISTING LAND USE IS MASTERPLANNED FOR MIXED USE. CURRENTLY, THERE IS AN EXISTING BUILDING AND THE PROPERTY IS IN A DETERIORATED STATE.
- B) A TREE INVENTORY HAS BEEN CONDUCTED FOR THE PROPERTY. THE SITE IS RELATIVELY FLAT WITH SOME RELIEF ACROSS THE PROPERTY. SOIL CONDITIONS WERE IDENTIFIED AS "FILL LAND" ACCORDING TO THE USDA-NRCS "WEB SOIL SURVEY"
- C) NATURAL FEATURES
- i) ENDANGERED SPECIES: THE U.S. FISH & WILDLIFE SERVICE ENDANGERED SPECIES LIST FOR WASHTENAW COUNTY WAS REVIEWED, AND THE HABITAT OF THE SUBJECT PROPERTY DOES NOT MATCH THE REQUIREMENTS FOR CORRESPONDING SPECIES
- ii) 100-YEAR FLOODPLAIN: ACCORDING TO FEMA COMMUNITY PANEL 26161C04P1E EFFECTIVE 04/03/2012, THE PROPERTY IS LOCATED IN ZONE "X", WHICH IS AREAS DETERMINED TO BE OUTSIDE 0.2% ANNUAL CHANCE FLOODPLAIN.
- iii) LANDMARK TREES: A TREE INVENTORY WAS CONDUCTED FOR THE PROPERTY AND IS INCLUDED WITHIN THE PLAN SET.
- iv) STEEP SLOPES: THERE ARE NO STEEP SLOPES ON THE PROPERTY.
- v) WATERCOURSES: THERE ARE NO WATERCOURSES ON THE PROPERTY.
- vi) WETLANDS: THERE ARE NO WETLANDS ON THE PROPERTY AS INDICATED ON THE NATIONAL WETLAND INVENTORY MAP.
- vii) WOODLANDS: ACCORDING TO THE TREE INVENTORY THAT WAS CONDUCTED, THERE ARE NO WOODLANDS ON THE PROPERTY.
- D) THERE IS AN EXISTING BUILDING ON THE PROPERTY THAT IS SITUATED ON THE NORTHERN PORTION OF THE SITE WITH A LARGER PARKING LOT IN THE REAR.
- E) EXISTING AND PROPOSED VEHICULAR, PEDESTRIAN AND BICYCLE WAYS AND ACCESS POINTS ARE INDICATED ON THE SITE LAYOUT AND PAVING PLAN.
- F) UTILITIES AND PROPOSED CONNECTIONS ARE SHOWN ON THE UTILITY PLAN INCLUDED IN THE PLAN SET.
- G) EXISTING AND PROPOSED GENERAL DRAINAGE PATTERN ON THE PROPERTY ARE INDICATED ON THE STORM MANAGEMENT PLANS IN THE PLAN SET.
- H) THE PROPOSED MIXED USE IS CONSISTENT WITH THE MASTER PLAN. THE PROJECT WILL ENHANCE THE RESEARCH PARK AREA BY PROVIDING FOR NON-EXISTENT USES OF A HOTEL AND RETAIL. THIS PROJECT WILL ENHANCE THE AREA WITH NEW LANDSCAPING IMPROVEMENTS.

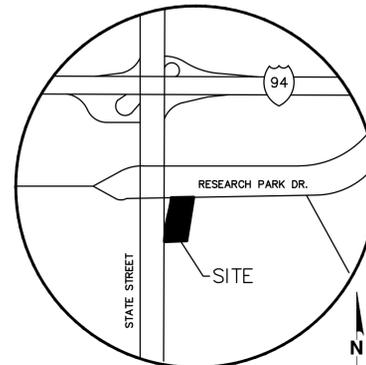

LOCATION MAP  
NOT TO SCALE



Know what's below.  
Call before you dig.

## DRAWING INDEX

- C1.0 COVER SHEET
- ~~C2.0 EXISTING CONDITIONS PLAN~~
- ~~C2.1 TREE INVENTORY PLAN~~
- ~~C2.2 SOIL BORING PLAN~~
- ~~C2.3 NATURAL FEATURES ALTERNATIVE ANALYSIS PLAN~~
- C3.0 SITE LAYOUT AND PAVING PLAN
- ~~C3.1 SITE PHOTOMETRIC PLAN~~
- ~~C4.0 OVERALL GRADING AND EROSION CONTROL PLAN~~
- ~~C4.1 ENLARGED GRADING PLAN~~
- ~~C4.2 ENLARGED GRADING PLAN~~
- C5.0 UTILITY PLAN
- C5.1 STORM LAYOUT PLAN
- C5.2 STORM MANAGEMENT PLAN
- C5.3 STORM MANAGEMENT DETAILS
- ~~C5.4 FIRE COVERAGE PLAN~~
- ~~C5.5 WATER MAIN PROFILES~~
- ~~C5.6 WATER MAIN PROFILES~~
- ~~C5.7 STORM SEWER PROFILES~~
- C5.8 UNDERGROUND DETENTION PLANS
- C5.9 UNDERGROUND DETENTION PLANS
- ~~C6.0 SITE DETAILS~~
- ~~C6.1 CITY OF ANN ARBOR STANDARD DETAILS~~
- ~~C6.2 CITY OF ANN ARBOR STANDARD DETAILS~~
- L1.0 LANDSCAPE PLAN AND DETAILS

STANDARD LEGEND		
DESCRIPTION	PROPOSED	EXISTING
BUILDING	—	—
STORM SEWER	— 12" —	— 12" —
SANITARY SEWER	— S —	— 12" —
WATER	— W —	— W —
GAS LINE	— G —	— G —
ELECTRIC LINE	— E —	— E —
TELEPHONE LINE	— T —	— T —
MANHOLE	●	⊙ ⊙
CATCH BASIN	⊙ ⊙	⊙ ⊙
ENDSECTION	⊙	⊙
FIRE HYDRANT	⊙	⊙
GATE VALVE & WELL	⊙	⊙ ⊙
UTILITY RISER	⊙	⊙
SIGN	—	— +
LIGHT POLE	⊙	⊙ ⊙
CURB & GUTTER	—	—
FENCE	—	—
SILT FENCE	—	—
TREE - DECIDUOUS	AS NOTED ON PLANS	
TREE LINE	—	—
SPOT ELEVATION	+ 100.00	+ 100.00
CONTOUR LINE	— 100 —	— 100 —
SECTION CORNER		⊙
FOUND PROPERTY IRON		⊙
SET PROPERTY IRON		⊙
GAS METER	⊙	⊙
ELECTRICAL METER	⊙	⊙
TELEPHONE RISER		⊙
MAILBOX	⊙	⊙
SOIL BORING LOCATION		⊙



ANDREW ANDRE, P.E.  
MICHIGAN PE 47380  
STELLAR DEVELOPMENT, LLC

LEGAL DESCRIPTION
FIRST AMERICAN TITLE INSURANCE COMPANY COMMERCIAL TITLE SERVICES COMMITMENT NO. 14-8523 COMMITMENT DATE: SEPTEMBER 9, 2014 @ 8:00 AM
LAND SITUATED IN THE CITY OF ANN ARBOR, COUNTY OF WASHTENAW, MICHIGAN, DESCRIBED AS: LOT 22, RESEARCH PARK, AS RECORDED IN LIBER 15 OF PLATS, PAGES 56 AND 57, WASHTENAW COUNTY RECORDS.

BENCHMARKS
B.M. #1 - SET BM ON LIGHT POLE NEAR THE NW COR OF PROPERTY ELEV. 834.30 NAVD 88
B.M. #2 - SET BM ON TOP OF NE BOLT ON LIGHT POLE BASE ON WEST SIDE OF PROPERTY ELEV. 835.78 NAVD 88

FLOODPLAIN INFORMATION
CITY OF ANN ARBOR WASHTENAW COUNTY, MICHIGAN MAP NUMBER: 26161C0401E EFFECTIVE DATE: APRIL 3, 2012 FLOOD ZONE: X AREA OUTSIDE OF THE 0.2% ANNUAL CHANCE FLOODPLAIN


UTILITY CONTACTS	
<b>ELECTRIC</b> DTE ONE ENERGY PLAZA ROOM 518 S.B. DETROIT, MI 48226 (313) 235-5632	<b>GAS</b> DTE ONE ENERGY PLAZA-WC81836 DETROIT, MI 48226 (313) 235-5111
<b>ZONING</b> CITY OF ANN ARBOR PLANNING & DEVELOPMENT 100 N FIFTH AVE. ANN ARBOR, MICHIGAN 48107 (734) 794-6265	<b>WATER/SEWER</b> CITY OF ANN ARBOR ENGINEERING DEPT. 301 E. HURON ANN ARBOR, MICHIGAN 48107 (734) 794-6410

UTILITY NOTE
THE UTILITY LOCATIONS AS HEREON SHOWN ARE BASED ON FIELD OBSERVATIONS AND A CAREFUL REVIEW OF MUNICIPAL AND UTILITY RECORDS. HOWEVER, IT IS NOT POSSIBLE TO DETERMINE THE PRECISE SIZE, LOCATION, DEPTH, PRESSURE, OR ANY OTHER CHARACTERISTICS OF UNDERGROUND UTILITIES, TANKS OR SEPTIC FIELDS WITHOUT EXCAVATION. THEREFORE, WE CANNOT GUARANTEE THE ACCURACY OF COMPLETENESS OF THE BURIED UTILITY INFORMATION HEREON SHOWN. THE CONTRACTOR SHALL CALL MISS DIG (1-800-482-7171) A MINIMUM OF THREE WORKING DAYS PRIOR TO ANY EXCAVATION. IT SHALL BE THE RESPONSIBILITY OF THE CONTRACTOR TO VERIFY THESE UTILITY LOCATIONS PRIOR TO CONSTRUCTION AND MAKE EVERY EFFORT TO PROTECT AND/OR RELOCATE THEM AS REQUIRED. THE CONTRACTOR SHALL NOTIFY THE ENGINEER/SURVEYOR AS SOON AS POSSIBLE IN THE EVENT A DISCREPANCY IS FOUND.

THIS DRAWING IS THE PROPERTY OF STELLAR DEVELOPMENT, LLC. IT IS TO BE USED ONLY FOR THE PROJECT AND SITE SPECIFICALLY IDENTIFIED HEREON. ANY REUSE, REPRODUCTION, OR MODIFICATION OF THIS DRAWING WITHOUT THE WRITTEN PERMISSION OF STELLAR DEVELOPMENT, LLC IS STRICTLY PROHIBITED. THE USER ASSUMES ALL LIABILITY FOR ANY ERRORS OR OMISSIONS. THE USER SHALL BE RESPONSIBLE FOR OBTAINING ALL NECESSARY PERMITS AND APPROVALS FROM THE APPROPRIATE AGENCIES. THE USER SHALL BE RESPONSIBLE FOR OBTAINING ALL NECESSARY INFORMATION FROM THE APPROPRIATE AGENCIES. THE USER SHALL BE RESPONSIBLE FOR OBTAINING ALL NECESSARY INFORMATION FROM THE APPROPRIATE AGENCIES. THE USER SHALL BE RESPONSIBLE FOR OBTAINING ALL NECESSARY INFORMATION FROM THE APPROPRIATE AGENCIES.

ISSUED FOR	DATE
SPA	12/29/14
SPA	02/20/15
SPA	03/23/15
SPA	04/23/15
PERMITS	06/12/15
SPA	07/28/15
SPA	08/17/15
CONST PLANS	09/05/15
CONST PLANS	10/02/15
CONST PLANS	11/05/15
CONST PLANS	12/09/15
USE DETENTION	03/06/16
SPA	01/21/21

DATE:	
DRAWN:	ACA
CHECKED:	
SCALE:	NTS
JOB NO:	BD-14-322
SHEET TITLE:	COVER SHEET
SHEET	
C1.0	

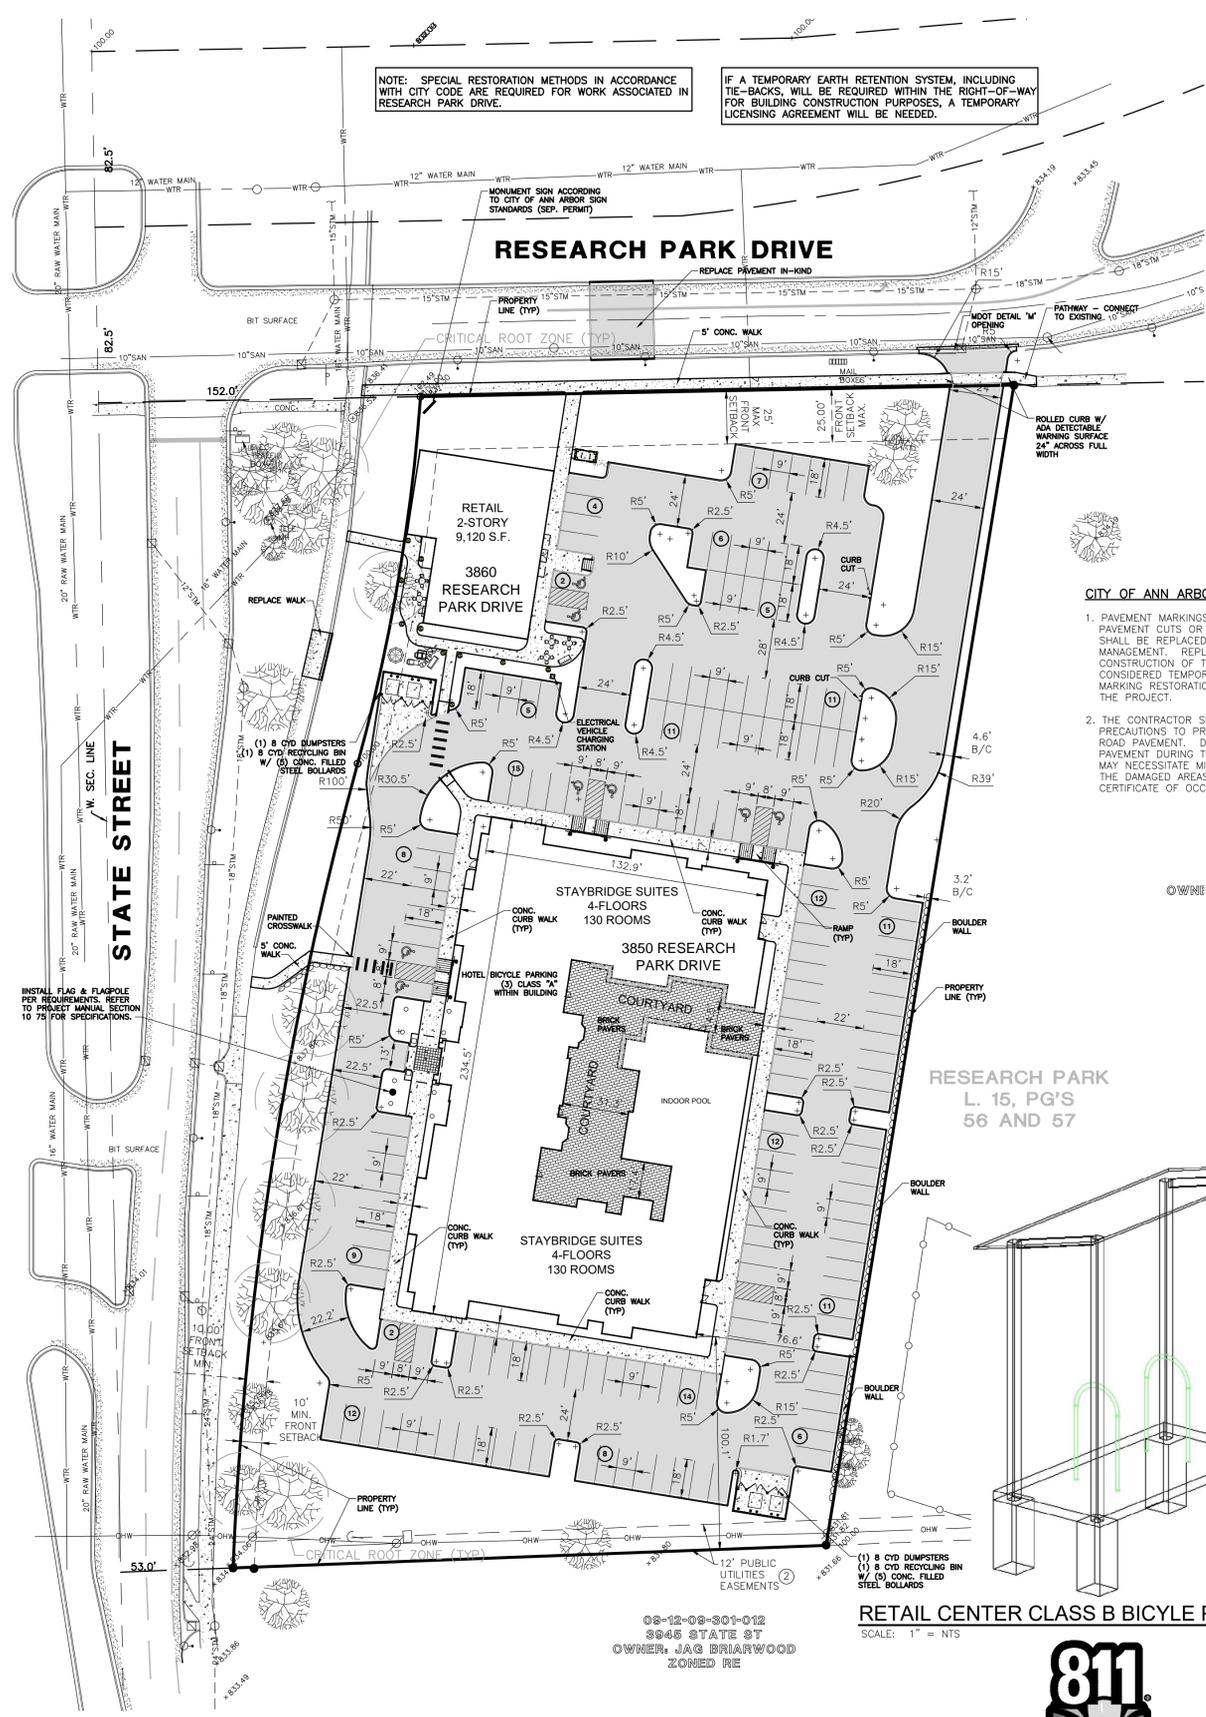

NOTE: SPECIAL RESTORATION METHODS IN ACCORDANCE WITH CITY CODE ARE REQUIRED FOR WORK ASSOCIATED IN RESEARCH PARK DRIVE.

IF A TEMPORARY EARTH RETENTION SYSTEM, INCLUDING TIE-BACKS, WILL BE REQUIRED WITHIN THE RIGHT-OF-WAY FOR BUILDING CONSTRUCTION PURPOSES, A TEMPORARY LICENSING AGREEMENT WILL BE NEEDED.

**RESEARCH PARK DRIVE**

**STATE STREET**

INSTALL FLAG & FLAGPOLE PER REQUIREMENTS. REFER TO PROJECT MANUAL SECTION 10 75 FOR SPECIFICATIONS.

THE LOCATION OF ALL UNDERGROUND UTILITIES AS SHOWN ON THESE DRAWINGS ARE BASED ON RECORDS PROVIDED BY THE UTILITY OWNERS AND VISIBLE EVIDENCE OBTAINED IN THE FIELD. NO GUARANTEE IS EITHER EXPRESSED OR IMPLIED TO THE COMPLETENESS OR ACCURACY THEREOF.

**CITY OF ANN ARBOR SIDEWALK REPAIR AND MAINTENANCE NOTE**

SIDEWALK REPAIR AND MAINTENANCE NOTE: ALL SIDEWALKS ARE TO BE KEPT AND MAINTAINED IN GOOD REPAIR BY THE OWNER OF THE LAND ADJACENT TO AND ABUTTING THE SAME. PRIOR TO THE ISSUANCE OF THE FINAL CERTIFICATE OF OCCUPANCY FOR THIS SITE, ALL EXISTING SIDEWALKS IN NEED OF REPAIR MUST BE REPAIRED IN ACCORDANCE WITH CITY STANDARDS.

**PAVEMENT INFORMATION**



Know what's below. Call before you dig.



Know what's below. Call before you dig.




Know what's below. Call before you dig.



Know what's below. Call before you dig.
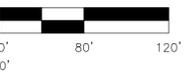


Know what's below. Call before you dig.

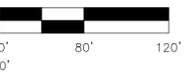

Know what's below. Call before you dig.




Know what's below. Call before you dig.



Know what's below. Call before you dig.




Know what's below. Call before you dig.

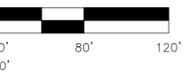

Know what's below. Call before you dig.



Know what's below. Call before you dig.

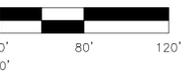


Know what's below. Call before you dig.




Know what's below. Call before you dig.



Know what's below. Call before you dig.

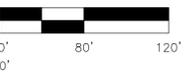

Know what's below. Call before you dig.

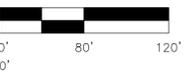

Know what's below. Call before you dig.



Know what's below. Call before you dig.




Know what's below. Call before you dig.



Know what's below. Call before you dig.

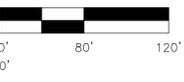


Know what's below. Call before you dig.



Know what's below. Call before you dig.
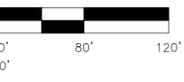



Know what's below. Call before you dig.

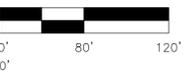

Know what's below. Call before you dig.



Know what's below. Call before you dig.

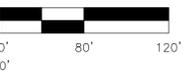

Know what's below. Call before you dig.



STELLAR DEVELOPMENT, LLC

2600 AUBURN ROAD, SUITE 140  
AUBURN HILLS, MI 48326  
PH 810-444-7815  
FX 248-553-4218

PREPARED UNDER THE DIRECTION OF:  
ANDREW ANDRE, P.E.  
MI #47380

APPLICANT:  
STELLAR HOSPITALITY ANN ARBOR, LLC  
2600 AUBURN ROAD, SUITE 240  
AUBURN HILLS, MI 48326  
PH 248-419-5551

STAYBRIDGE SUITES & RETAIL CENTER  
3860 RESEARCH PARK DRIVE  
ANN ARBOR, MI 48108

THIS PLAN AND ALL INFORMATION CONTAINED HEREIN ARE THE PROPERTY OF STELLAR DEVELOPMENT, LLC. NO PART OF THIS PLAN OR INFORMATION SHALL BE REPRODUCED, COPIED, OR TRANSMITTED IN ANY FORM OR BY ANY MEANS, ELECTRONIC OR MECHANICAL, INCLUDING PHOTOCOPYING, RECORDING, OR BY ANY INFORMATION STORAGE AND RETRIEVAL SYSTEM, WITHOUT THE WRITTEN PERMISSION OF STELLAR DEVELOPMENT, LLC.

ISSUED FOR	DATE
SPA	12/29/14
SPA	02/20/15
SPA	03/23/15
SPA	04/23/15
PERMITS	08/12/15
SPA	08/17/15
CONST PLANS	09/03/15
CONST PLANS	10/02/15
CONST PLANS	11/05/15
CONST PLANS	12/09/15
STORM REVISION	01/15/16
UG DETENTION	03/08/16
RETAIL UTILITIES	03/21/16
STORM-COURTYARD	06/22/20
SPA	01/21/21

DATE: \_\_\_\_\_  
 DRAWN: ACA  
 CHECKED: \_\_\_\_\_  
 SCALE: 1"=40'  
 JOB NO: BD-14-322  
 SHEET TITLE:  
**STORM LAYOUT PLAN**

SHEET  
**C5.1**

### STORMTECH VOLUME CALCULATIONS

Project: **STAYBRIDGE SUITES**

Chamber Model - **SC-740**  
 Units - **Imperial**

Number of chambers - **373**  
 Voids in the stone (porosity) - **30** %  
 Base of Stone Elevation - **829.14** ft  
 Amount of Stone Above Chambers - **12** in  
 Amount of Stone Below Chambers - **6** in  
 Area of system - **14361** sf Min. Area - 12609 sf min. area

SC-740 Imperial	Imperial
367	373
	30
	829.14
	12
	6
	14361

Include Perimeter Stone in Calculations



### StormTech SC-740 Cumulative Storage Volumes

Height of System (inches)	Incremental Single Chamber (cubic feet)	Incremental Chamber (cubic feet)	Incremental Stone (cubic feet)	Incremental Ch & St (cubic feet)	Cumulative Chamber (cubic feet)	Elevation (feet)
48	0.00	0.00	359.03	359.03	29230.97	833.14
47	0.00	0.00	359.03	359.03	28871.94	833.06
46	0.00	0.00	359.03	359.03	28512.92	832.97
45	0.00	0.00	359.03	359.03	28153.89	832.89
44	0.00	0.00	359.03	359.03	27794.87	832.81
43	0.00	0.00	359.03	359.03	27435.84	832.72
42	0.00	0.00	359.03	359.03	27076.82	832.64
41	0.00	0.00	359.03	359.03	26717.79	832.56
40	0.00	0.00	359.03	359.03	26358.77	832.47
39	0.00	0.00	359.03	359.03	25999.74	832.39
38	0.00	0.00	359.03	359.03	25640.72	832.31
37	0.00	0.00	359.03	359.03	25281.69	832.22
36	0.05	20.51	352.87	373.38	24922.67	832.14
35	0.16	60.77	340.79	401.56	24563.64	832.06
34	0.28	105.16	327.48	432.64	24204.62	831.97
33	0.60	225.28	291.44	516.72	23845.59	831.89
32	0.80	299.04	269.31	568.35	23486.57	831.81
31	0.95	354.60	252.64	607.25	23127.54	831.72
30	1.07	400.79	238.79	639.58	22768.52	831.64
29	1.18	440.32	226.93	667.25	22409.50	831.56
28	1.27	472.09	217.40	689.49	22050.47	831.47
27	1.36	505.42	207.40	712.82	21691.45	831.39
26	1.45	542.38	196.31	738.69	21332.43	831.31
25	1.52	568.72	188.41	757.13	20973.41	831.22
24	1.58	590.21	181.96	772.17	20614.39	831.14
23	1.64	612.57	175.25	787.82	20255.37	831.06
22	1.70	633.92	168.85	802.77	19896.35	830.97
21	1.75	653.84	162.87	816.71	19537.33	830.89
20	1.80	672.45	157.29	829.74	19178.31	830.81
19	1.85	691.91	151.45	843.37	18819.29	830.72
18	1.89	706.12	147.19	853.31	18460.27	830.64
17	1.93	721.38	142.61	863.99	18101.25	830.56
16	1.97	736.67	138.02	874.70	17742.23	830.47
15	2.01	749.70	134.11	883.82	17383.21	830.39
14	2.04	762.78	130.19	892.97	17024.19	830.31
13	2.07	773.96	126.84	900.80	16665.17	830.22
12	2.10	785.13	123.49	908.62	16306.15	830.14
11	2.13	795.16	120.48	915.64	15947.13	830.06
10	2.15	803.39	118.01	921.40	15588.11	829.97
9	2.18	812.04	115.41	927.46	15229.09	829.89
8	2.20	819.99	113.03	933.02	14870.07	829.81
7	2.21	823.33	112.03	935.36	14511.05	829.72
6	0.00	0.00	359.03	359.03	14152.03	829.64
5	0.00	0.00	359.03	359.03	13793.01	829.56
4	0.00	0.00	359.03	359.03	13434.00	829.47
3	0.00	0.00	359.03	359.03	13075.00	829.39
2	0.00	0.00	359.03	359.03	12716.00	829.31
1	0.00	0.00	359.03	359.03	12357.00	829.22


AS-BUILT INFORMATION (03/23/2017)		
Event	A.B. Elev	A.B. Vol (c.f.)
First Flush:	830.41	10583
Bankfull:	831.47	20716
100-Year:	832.90	28197

### STORM SEWER CALCULATIONS

$Q_p = C \cdot I \cdot A$   
 $Q_p = A \times 1.486 \cdot m \times R^{2.48} \times S^{0.48}$   
 $I = 170 / (23 + L_e)$  for 10 year storm event

AREA NO.	FROM MH/CB	TO MH/CB	AREA A	COEFF. C*	A x C	AREA TOTAL AT	COEFF. Wt	A1 x Cw	TIME t <sub>c</sub>	INT. I	n	FLOW Q <sub>a</sub>	PIPE CAP. Q <sub>p</sub>	PIPE DIA.	PIPE LENGTH	PIPE SLOPE	VEL. FULL	TIME FLOW	RIM ELEV HIGH	RIM ELEV LOW	H.G.L. 10-YEAR		INVERT ELEV.	
																					END HGL	END HGL	END INV	END INV
DA1	1	2	0.19	0.74	0.14	0.19	0.74	0.14	15.00	4.38	0.013	0.61	2.02	12	140	0.32%	2.57	0.91	834.60	834.60	834.25	833.67	832.43	831.98
DA2	2	14	0.23	0.76	0.17	0.42	0.75	0.31	15.91	4.37	0.013	1.37	2.04	12	122	0.33%	2.60	0.78	834.60	834.80	833.57	833.06	831.88	831.48
DA13	14	DET	0.20	0.78	0.15	0.61	0.76	0.47	16.69	4.28	0.013	2.00	6.32	12	55	3.15%	8.05	0.11	834.80	837.00	833.06	831.18	831.48	829.75
DA3	3	4	0.19	0.88	0.17	0.19	0.88	0.17	15.00	4.38	0.013	0.74	2.02	12	112	0.32%	2.57	0.73	834.30	834.30	834.27	833.81	832.13	831.77
DA4	4	5	0.15	0.88	0.14	0.34	0.88	0.30	15.73	4.39	0.013	1.33	2.02	12	84	0.32%	2.57	0.55	834.30	834.65	833.71	833.36	831.67	831.40
DA5	5	6	0.05	0.87	0.05	0.40	0.88	0.35	16.27	4.33	0.013	1.51	2.02	12	80	0.32%	2.57	0.52	834.65	834.25	833.26	832.94	831.30	831.05
DA6	6	10	0.52	0.93	0.49	0.92	0.91	0.84	16.79	4.27	0.013	3.58	3.80	15	114	0.31%	2.93	0.65	834.25	834.25	832.84	832.40	830.95	830.59
DA7	7	8	0.05	0.95	0.05	0.05	0.95	0.05	15.00	4.38	0.013	0.23	2.02	12	70	0.32%	2.57	0.45	835.50	835.50	832.75	832.17	831.66	831.44
DA8	8	9	0.04	0.95	0.04	0.10	0.95	0.09	15.45	4.42	0.013	0.41	2.02	12	55	0.32%	2.57	0.36	835.50	835.50	833.07	832.85	831.34	831.16
DA9	9	10	0.03	0.95	0.03	0.13	0.95	0.12	15.81	4.38	0.013	0.52	2.02	12	83	0.32%	2.57	0.54	835.50	834.25	832.75	832.40	831.06	830.79
DA10	10	11	0.45	0.92	0.41	1.49	0.92	1.37	17.44	4.20	0.013	5.75	5.75	18	121	0.30%	3.26	0.62	834.25	833.60	832.00	831.58	830.39	830.03
DA11	11	13	0.51	0.91	0.46	2.00	0.91	1.83	18.06	4.14	0.013	7.57	8.76	24	75	0.15%	2.79	0.45	833.60	834.00	831.38	831.25	829.83	829.72
DA13	13	17	0.23	0.91	0.21	2.23	0.91	2.03	18.51	4.10	0.013	8.33	8.76	24	27	0.15%	2.79	0.16	834.00	834.10	831.25	831.20	829.72	829.68
DA12	12	17	0.23	0.91	0.21	0.23	0.91	0.21	15.00	4.38	0.013	0.91	2.02	12	35	0.32%	2.57	0.23	833.85	834.10	832.15	832.00	830.59	830.48
---	17	18	0.00	0.00	0.00	2.45	0.91	2.24	18.67	4.08	0.013	9.14	11.54	24	9	0.26%	3.67	0.04	834.10	834.67	831.20	831.18	829.68	829.65

### RESEARCH PARK DRIVE

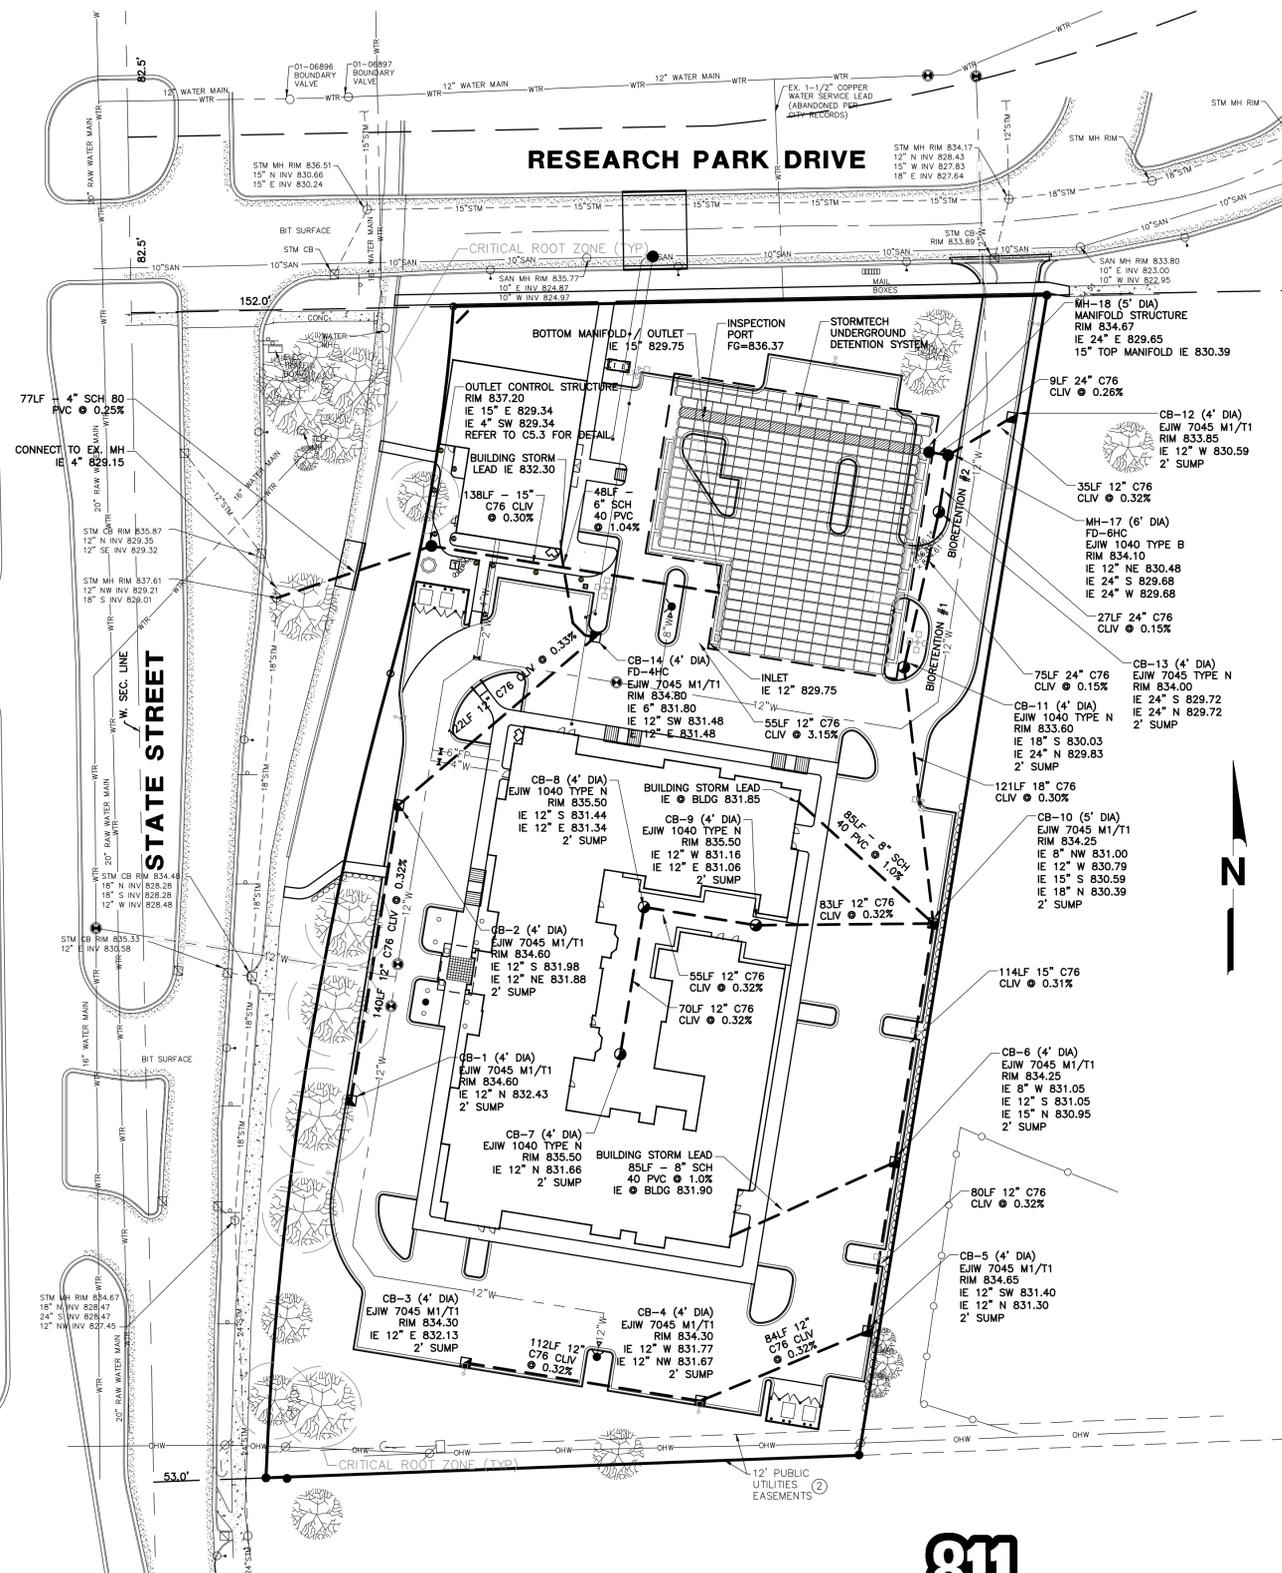

UTILITY CONTACTS	
<b>ELECTRIC</b> DTE ONE ENERGY PLAZA ROOM 518 S.B. DETROIT, MI 48226 (313) 235-5632	<b>GAS</b> DTE ONE ENERGY PLAZA-WC81836 DETROIT, MI 48226 (313) 235-5111
<b>ZONING</b> CITY OF ANN ARBOR PLANNING & DEVELOPMENT 100 N FIFTH AVE. ANN ARBOR, MICHIGAN 48107 (734) 794-6265	<b>WATER/SEWER</b> CITY OF ANN ARBOR ENGINEERING DEPT. 301 E. HURON ANN ARBOR, MICHIGAN 48107 (734) 794-6410

**811**  
Know what's below.  
Call before you dig.

SCALE: 1" = 40'

THE LOCATION OF ALL UNDERGROUND UTILITIES AS SHOWN ON THESE DRAWINGS ARE BASED ON RECORDS PROVIDED BY THE UTILITY OWNERS AND VISIBLE EVIDENCE OBTAINED IN THE FIELD. NO GUARANTEE IS EITHER EXPRESSED OR IMPLIED TO THE COMPLETENESS OR ACCURACY THEREOF.



TASK:	STREETS	CATCH BASIN INLET CASINGS	STORM SEWER SYSTEM	OUTFLOW CONTROL STRUCTURES	UNDERGROUND DETENTION	COMPONENTS:	SCHEDULE:
INSPECT FOR SEDIMENT ACCUMULATION	X	X	X	X	X	UNDERGROUND DETENTION	WEEKLY
REMOVAL OF SEDIMENT ACCUMULATION	X	X	X	X	X	UNDERGROUND DETENTION	AS NEEDED & PRIOR TO TURNOVER
INSPECT FOR FLOATABLES AND DEBRIS	X	X	X	X	X	UNDERGROUND DETENTION	QUARTERLY
CLEANING OF FLOATABLES AND DEBRIS	X	X	X	X	X	UNDERGROUND DETENTION	QUARTERLY AND AT TURNOVER
INSPECTION FOR EROSION				X	X	UNDERGROUND DETENTION	WEEKLY
REESTABLISH PERMANENT VEGETATION ON ERODED SLOPES				X	X	UNDERGROUND DETENTION	AS NEEDED & PRIOR TO TURNOVER
REPLACEMENT OF GRAVEL JACKETS				X	X	UNDERGROUND DETENTION	AS NEEDED
MOWING	X			X	X	UNDERGROUND DETENTION	0-2 TIMES PER YEAR
INSPECT STRUCTURAL ELEMENTS DURING WET WEATHER AND COMPARE TO AS-BUILT PLANS (BY PROFESSIONAL ENGINEER REPORTING TO THE CITY)		X	X	X	X	UNDERGROUND DETENTION	ANNUALLY AND AT TURNOVER
MAKE ADJUSTMENTS OR REPLACEMENTS AS DETERMINED BY ANNUAL WET WEATHER INSPECTION		X	X	X	X	UNDERGROUND DETENTION	AS NEEDED

AS NEEDED = WHEN SEDIMENT HAS ACCUMULATED TO A MAXIMUM OF ONE (1) FOOT DEPTH.


### CONSTRUCTION MAINTENANCE SCHEDULE

TASK:	STREETS	CATCH BASIN INLET CASINGS	STORM SEWER SYSTEM	OUTFLOW CONTROL STRUCTURES	UNDERGROUND DETENTION	COMPONENTS:	SCHEDULE:
INSPECT FOR SEDIMENT ACCUMULATION	X	X	X	X	X	UNDERGROUND DETENTION	ANNUALLY
REMOVAL OF SEDIMENT ACCUMULATION	X	X	X	X	X	UNDERGROUND DETENTION	EVERY 5-10 YEARS AS NEEDED
INSPECT FOR FLOATABLES AND DEBRIS	X	X	X	X	X	UNDERGROUND DETENTION	ANNUALLY
CLEANING OF FLOATABLES AND DEBRIS	X	X	X	X	X	UNDERGROUND DETENTION	ANNUALLY
INSPECTION FOR EROSION				X	X	UNDERGROUND DETENTION	ANNUALLY
REESTABLISH PERMANENT VEGETATION ON ERODED SLOPES				X	X	UNDERGROUND DETENTION	AS NEEDED
REPLACEMENT OF GRAVEL JACKETS				X	X	UNDERGROUND DETENTION	EVERY 3-5 YEARS AS NEEDED
CLEAN STREETS	X			X	X	UNDERGROUND DETENTION	SEMI-ANNUALLY
MOWING	X			X	X	UNDERGROUND DETENTION	0-2 TIMES PER YEAR
INSPECT STRUCTURAL ELEMENTS DURING WET WEATHER AND COMPARE TO AS-BUILT PLANS (BY PROFESSIONAL ENGINEER REPORTING TO THE CITY)		X	X	X	X	UNDERGROUND DETENTION	ANNUALLY
MAKE ADJUSTMENTS OR REPLACEMENTS AS DETERMINED BY ANNUAL WET WEATHER INSPECTION		X	X	X	X	UNDERGROUND DETENTION	AS NEEDED
KEEP RECORDS OF ALL INSPECTIONS AND MAINTENANCE ACTIVITIES ARE REPORT TO CITY		X	X	X	X	UNDERGROUND DETENTION	ANNUALLY
KEEP RECORDS OF ALL COSTS FOR INSPECTIONS, MAINTENANCE AND REPAIRS, REPORT TO CITY		X	X	X	X	UNDERGROUND DETENTION	ANNUALLY
CITY REVIEWS COST EFFECTIVENESS OF THE PREVENTATIVE MAINTENANCE PROGRAM AND MAKES ADJUSTMENTS AS NEEDED		X	X	X	X	UNDERGROUND DETENTION	ANNUALLY
CITY TO HAVE A PROFESSIONAL ENGINEER CARRY OUT EMERGENCY INSPECTIONS UPON IDENTIFICATION OF SEVERE PROBLEMS		X	X	X	X	UNDERGROUND DETENTION	AS NEEDED

MAINTENANCE AFTER CONSTRUCTION WILL BE RESPONSIBILITY OF THE APPLICANT.

### MAINTENANCE SCHEDULE

NOTE: REFER TO "UNDERGROUND STORMWATER MANAGEMENT SYSTEM CERTIFICATION" FORM FOR AS-BUILT INFORMATION

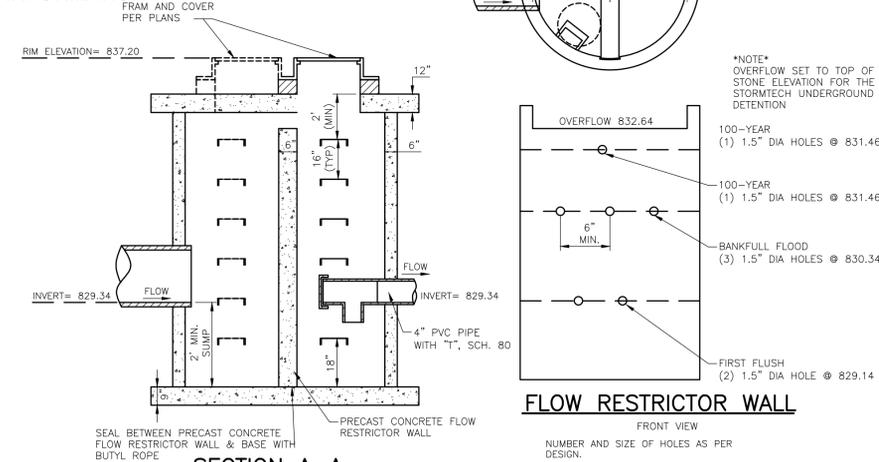

SECTION A-A

### OUTLET CONTROL STRUCTURE

NO SCALE



**CITY OF ANN ARBOR, MICHIGAN**  
301 E. Huron Street, 1<sup>st</sup> Floor, Larcom City Hall  
P.O. Box 8647, Ann Arbor, MI 48107  
Phone (734) 794-6267 Fax (734) 994-8460 www.a2gov.org

### UNDERGROUND STORMWATER MANAGEMENT SYSTEM CERTIFICATION

**Project Name** Staybridge Suites & Retail Center  
**Project Address** 3850 Research Park Drive  
**Permit Number** SOIL

#### OUTLET STRUCTURE

First Flush: Design 2 # of holes 1.5 inches in diameter area at elevation 829.14.  
As Built 2 # of holes 1.5 inches in diameter area at elevation 829.16

Bankfull: Design 3 # of holes 1.5 inches in diameter area at elevation 830.34.  
As Built 3 # of holes 1.5 inches in diameter area at elevation 830.41

100-Year: Design 1 # of holes 1.5 inches in diameter area at elevation 831.46.  
As Built 1 # of holes 1.5 inches in diameter area at elevation 831.47

#### STORAGE VOLUME

Infiltration:  No  Yes (If yes, include stone pores in the volume calculations) - 30% Stone Void  
First Flush: Design Volume is 9823 c.f. As-built Volume is 10,583 c.f. \*Refer to attached  
Bankfull: Design Volume is 20,623 c.f. As-built Volume is 20,716 c.f. documentation and  
100-Year: Design Volume is 28,094 c.f. As-built Volume is 28,197 c.f. calculations

#### STORAGE ELEVATION

First Flush: Design Elevation is 830.34 As-built Elevation is 830.41  
Bankfull: Design Elevation is 831.46 As-built Elevation is 831.47  
100-Year: Design Elevation is 832.64 As-built Elevation is 832.90

#### STORM WATER MANAGEMENT SYSTEM INFORMATION - UNDERGROUND DETENTION

Water Quality Structure: Design Model FD-4HC & FD-6HC As-built Model FD-4HC & FD-6HC  
Pipe Length: -- in diameter: Design --- L.F. As-built --- L.F. AS-BUILT INFORMATION  
Pipe Length: -- in diameter: Design --- L.F. As-built --- L.F. ADS StormTech System  
Pipe Length: -- in diameter: Design --- L.F. As-built --- L.F. SC-740 Chambers = 373 A.B.  
SC-740 End Caps = 52 A.B.

**COMMENTS** (Please describe any deviations from the approved site plan):  
Certification pertains to documentation of conditions as of 03/13/2017. BDE was not responsible for neither construction management nor construction quality. Landwise Inc. performed the field verification surveys on 03/02/17 and 03/23/17.

I hereby certify that the storm water detention facilities of the aforementioned Site is complete, and that I have inspected and verified that the structures have been installed in accordance with the approved construction plans and the City of Ann Arbor's Standards and Specifications.

Date: March 23, 2017

Signed: Architect or Professional Engineer

Doc. Ver. Nov 2012

Affix Architect or Engineer's Seal



### First Defense®

Cost-effective stormwater treatment with adaptability to meet demanding site requirements

#### Product Profile

The First Defense® is an enhanced vortex separator that combines an effective and economical stormwater treatment chamber with an integral peak flow bypass. It efficiently removes sediment, total suspended solids (TSS), trash and hydrocarbons from stormwater runoff without washing out previously captured pollutants. The First Defense® is available in several model configurations to accommodate a wide range of pipe sizes, peak flows and depth constraints (Table 1, next page).

#### Components

- Inlet Grate (optional)
- Inlet Chute
- Inlet Pipe (optional)
- Floatables Draw Off Slot (not pictured)
- Precast Vortex Chamber
- Internal Bypass
- Outlet Chute
- Outlet Pipe
- Oil and Floatables Storage
- Sediment Storage Sump

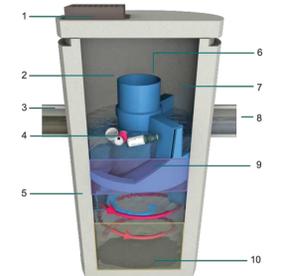


Fig. 1 The First Defense® has internal components designed to efficiently capture pollutants and prevent washout at peak flows.

#### Applications

- Stormwater treatment at the point of entry into the drainage line
- Sites constrained by space, topography or drainage profiles with limited slope and depth of cover
- Retrofit installations where stormwater treatment is placed on or tied into an existing storm drain line
- Pretreatment for filters, infiltration and storage

#### Advantages

- Inlet options include surface grate or multiple inlet pipes
- Integral high capacity bypass conveys large peak flows without the need for "off-line" arrangements using separate junction manholes
- Proven to prevent pollutant washout at up to 500% of its treatment flow
- Long flow path through the device ensures a long residence time within the treatment chamber, enhancing pollutant settling
- Delivered to site pre-assembled and ready for installation

#### How it Works

The First Defense® has internal components designed to remove and retain gross debris, total suspended solids (TSS) and hydrocarbons (Fig. 1). Contaminated stormwater runoff enters the inlet chute from a surface grate and/or inlet pipe. The inlet chute introduces flow into the chamber tangentially to create a low energy vortex flow regime (magnets arrow) that directs sediment into the sump while oils, floating trash and debris rise to the surface.


Treated stormwater exits through a submerged outlet chute located opposite to the direction of the rotating flow (blue arrow). Enhanced vortex separation is provided by forcing the rotating flow within the vessel to follow the longest path possible rather than directly from inlet to outlet.

Higher flows bypass the treatment chamber to prevent turbulence and washout of captured pollutants. An integral bypass conveys infrequent peak flows directly to the outlet chute, eliminating the need for, and expense of, external bypass control structures. A floatables draw off slot functions to convey floatables into the treatment chamber prior to bypass.

Stormwater Solutions  
Turning Water Around...®

### FIRST DEFENSE PRE-TREATMENT UNITS

NO SCALE

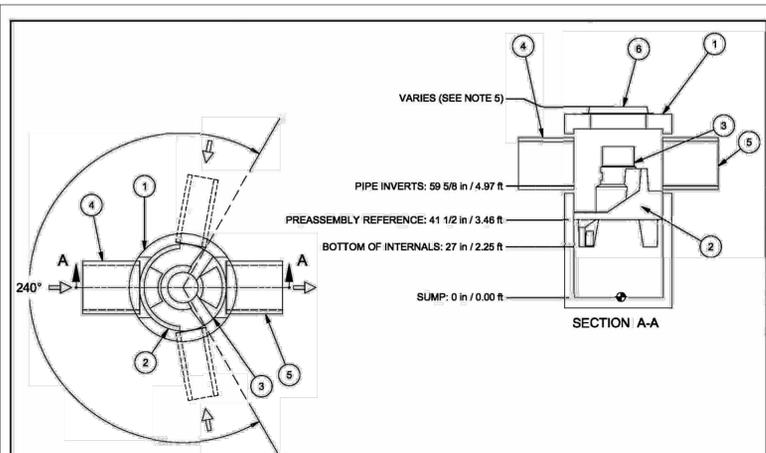


ITEM	SIZE (in)	DESCRIPTION
1	48	I.D. PRECAST MANHOLE
2		LEDGER SUPPORT
3		SEPARATION MODULE
4	24	INLET PIPE (BY OTHERS)
5	24	OUTLET PIPE (BY OTHERS)
6	30	FRAME AND COVER (OR GRATE) (ROUND)

© 2014 Hydro International

### FIRST DEFENSE FD-4HC

NO SCALE

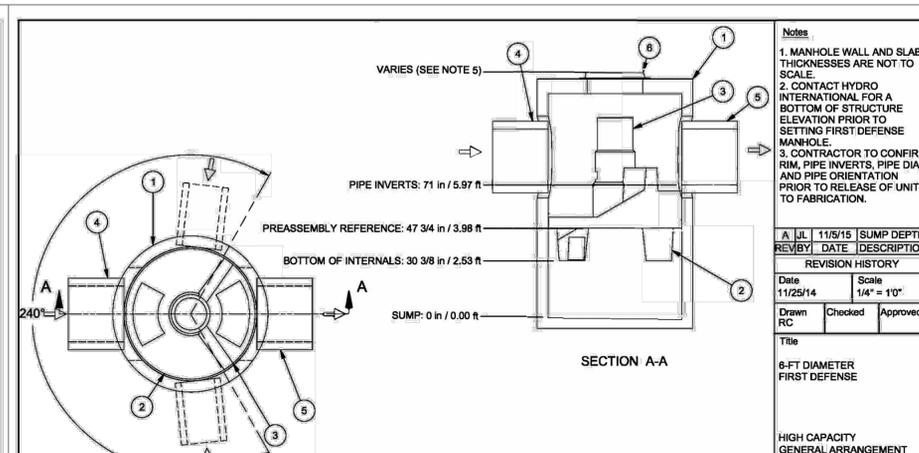

ITEM	SIZE (in)	DESCRIPTION
1	72	I.D. PRECAST MANHOLE
2		LEDGER SUPPORT
3		SEPARATION MODULE
4	30	INLET PIPE (BY OTHERS)
5	30	OUTLET PIPE (BY OTHERS)
6	30	FRAME AND COVER (OR GRATE) (ROUND)

© 2008 Hydro International

### FIRST DEFENSE FD-6HC

NO SCALE

### First Defense®

#### Maintenance

The First Defense® needs minimal maintenance, but like all structural best management practices maintenance is necessary for the long-term protection of the environment.

Sediments captured by the First Defense® are stored in the sump; floatable trash and hydrocarbons are stored on the surface of the standing water. A commercially or municipally owned sump-vac is used to remove captured sediment and floatables (Fig. 2).

More information can be found in the First Defense® Operation and Maintenance Manual, available at <http://www.hydro-int.com/us/products/first-defense>.



Fig. 2 Maintenance is performed with a vacuum truck.

#### First Defense® Sizing & Design

##### Design Options for Inlet and Internal Bypass Arrangements

For maximum flexibility the First Defense® inlet and internal bypass arrangements are available in two configurations (Fig. 3a & 3b). Model parameters and design criteria are shown in Table 1.



Fig. 3a Inlet configurations for all models include options for inlet grates and multiple inlet pipes.



Fig. 3b First Defense®-HC with higher capacity internal bypass and larger maximum pipe diameter.

Table 1. First Defense® Models and Design Criteria.

First Defense® Model Number	Diameter	Typical Flow Rates for TSS Treatment		Peak Flow Rate	Maximum Pipe Diameter <sup>1</sup>	Storage Capacity	Typical Sediment Storage Capacity <sup>2</sup>	Minimum Distance from Outlet Invert to Top of Rim <sup>3</sup>	Standard Distance from Outlet to Sump Floor
		100µm	200µm						
FD-4	4 / 1.2	0.7 / 20	1.2 / 34	6 / 170	18 / 450	180 / 681	1.3 / 1.0	3.1 / 1.1	5.47 / 1.7
FD-4HC	4 / 1.2	0.7 / 20	1.2 / 34	18 / 510	24 / 600	191 / 723	1.3 / 1.0	2.3 - 3.9 / 0.7 - 1.2	
FD-6	6 / 1.8	2.2 / 63	3.8 / 108	18 / 510	24 / 600	420 / 1,590	3.3 / 2.5	4.0 / 1.2	6.52 / 2.0
FD-6HC	6 / 1.8	2.2 / 63	3.8 / 108	32 / 906	30 / 750	496 / 1,878	3.3 / 2.5	3.0 - 5.1 / 0.9 - 1.6	

<sup>1</sup>Contact Hydro International when larger pipe sizes are required.

<sup>2</sup>Contact Hydro International when custom sediment storage capacity is required.

<sup>3</sup>The minimum distance for the 4HC and 6HC models depends on pipe diameter.

Hydro International, 94 Hutchins Drive, Portland, ME 04102  
Tel: (207) 756-6200 Fax: (207) 756-6212  
Email: [stormwaterinquiry@hydro-int.com](mailto:stormwaterinquiry@hydro-int.com) Web: [www.hydro-int.com](http://www.hydro-int.com)

Stormwater Solutions  
Turning Water Around...®  
FDS1502F

**STELLAR DEVELOPMENT, LLC**  
2600 AUBURN ROAD, SUITE 160  
AUBURN HILLS, MI 48326  
PH 810-444-7815  
FX 248-553-4218

PREPARED UNDER THE DIRECTION OF:  
ANDREW ANDRE, P.E.  
MI #47380

APPLICANT:  
STELLAR HOSPITALITY ANN ARBOR, LLC  
2600 AUBURN ROAD, SUITE 240  
AUBURN HILLS, MI 48326  
PH 248-419-5551

**STAYBRIDGE SUITES & RETAIL CENTER**  
3850 RESEARCH PARK DRIVE  
ANN ARBOR, MI 48108

THIS DRAWING IS THE PROPERTY OF STELLAR DEVELOPMENT, LLC. IT IS TO BE USED ONLY FOR THE PROJECT AND SITE SPECIFICALLY IDENTIFIED HEREIN. NO PARTS OF THIS DRAWING ARE TO BE REPRODUCED, COPIED, OR TRANSMITTED IN ANY FORM OR BY ANY MEANS, ELECTRONIC OR MECHANICAL, INCLUDING PHOTOCOPYING, RECORDING, OR BY ANY INFORMATION STORAGE AND RETRIEVAL SYSTEM, WITHOUT THE WRITTEN PERMISSION OF STELLAR DEVELOPMENT, LLC. ALL RIGHTS ARE RESERVED. THE USER OF THIS DRAWING SHALL BE RESPONSIBLE FOR OBTAINING ALL NECESSARY PERMITS AND APPROVALS FROM ALL APPLICABLE AGENCIES AND AUTHORITIES. THE USER OF THIS DRAWING SHALL BE RESPONSIBLE FOR OBTAINING ALL NECESSARY PERMITS AND APPROVALS FROM ALL APPLICABLE AGENCIES AND AUTHORITIES. THE USER OF THIS DRAWING SHALL BE RESPONSIBLE FOR OBTAINING ALL NECESSARY PERMITS AND APPROVALS FROM ALL APPLICABLE AGENCIES AND AUTHORITIES.

© 2012 STELLAR DEVELOPMENT, LLC

ISSUED FOR	DATE
SPA	12/29/14
SPA	02/20/15
SPA	03/23/15
SPA	04/23/15
PERMITS	06/12/15
SPA	08/17/15
CONST PLANS	09/05/15
CONST PLANS	10/02/15
CONST PLANS	11/05/15
CONST PLANS	12/09/15
STORM REVISION	01/15/16
UQ DETENTION	03/08/16
SPA	01/21/21

DATE: \_\_\_\_\_  
DRAWN: ACA  
CHECKED: \_\_\_\_\_  
SCALE: NTS  
JOB NO: BD-14-322

STREET TITLE:  
**STORM MANAGEMENT DETAILS**  
SHEET  
**C5.3**

PROJECT INFORMATION	
ENGINEERED PRODUCT MANAGER:	CHRIS OWEN 248-431-1361 CHRIS.OWEN@ADS-PIPE.COM
ADS SALES REP:	ANDY KELLER 248-417-4093 ANDY.KELLER@ADS-PIPE.COM
PROJECT NO.:	93256



# STAYBRIDGE SUITES & RETAIL CENTER

## ANN ARBOR, MICHIGAN

### STORMWATER CHAMBER SPECIFICATIONS

- CHAMBERS SHALL BE STORMTECH SC-740, SC-310, OR APPROVED EQUAL.
- CHAMBERS SHALL BE MANUFACTURED FROM VIRGIN POLYPROPYLENE OR POLYETHYLENE RESINS.
- CHAMBER ROWS SHALL PROVIDE CONTINUOUS, UNOBSTRUCTED INTERNAL SPACE WITH NO INTERNAL SUPPORT PANELS THAT WOULD IMPEDE FLOW OR LIMIT ACCESS FOR INSPECTION.
- THE STRUCTURAL DESIGN OF THE CHAMBERS, THE STRUCTURAL BACKFILL, AND THE INSTALLATION REQUIREMENTS SHALL ENSURE THAT THE LOAD FACTORS SPECIFIED IN THE AASHTO LRFD BRIDGE DESIGN SPECIFICATIONS, SECTION 12.12, ARE MET FOR: 1) LONG-DURATION DEAD LOADS AND 2) SHORT-DURATION LIVE LOADS, BASED ON THE AASHTO DESIGN TRUCK WITH CONSIDERATION FOR IMPACT AND MULTIPLE VEHICLE PRESENCES.
- CHAMBERS SHALL MEET ASTM F2922 (POLYETHYLENE) OR ASTM F2418 (POLYPROPYLENE), "STANDARD SPECIFICATION FOR THERMOPLASTIC CORRUGATED WALL STORMWATER COLLECTION CHAMBERS".
- CHAMBERS SHALL BE DESIGNED AND ALLOWABLE LOADS DETERMINED IN ACCORDANCE WITH ASTM F2787, "STANDARD PRACTICE FOR STRUCTURAL DESIGN OF THERMOPLASTIC CORRUGATED WALL STORMWATER COLLECTION CHAMBERS".
- ONLY CHAMBERS THAT ARE APPROVED BY THE SITE DESIGN ENGINEER WILL BE ALLOWED. THE CHAMBER MANUFACTURER SHALL SUBMIT THE FOLLOWING UPON REQUEST TO THE SITE DESIGN ENGINEER FOR APPROVAL BEFORE DELIVERING CHAMBERS TO THE PROJECT SITE:
  - A STRUCTURAL EVALUATION SEALED BY A REGISTERED PROFESSIONAL ENGINEER THAT DEMONSTRATES THAT THE SAFETY FACTORS ARE GREATER THAN OR EQUAL TO 1.35 FOR DEAD LOAD AND 1.75 FOR LIVE LOAD, THE MINIMUM REQUIRED BY ASTM F2787 AND BY AASHTO FOR THERMOPLASTIC PIPE.
  - A STRUCTURAL EVALUATION SEALED BY A REGISTERED PROFESSIONAL ENGINEER THAT DEMONSTRATES THAT THE LOAD FACTORS SPECIFIED IN THE AASHTO LRFD BRIDGE DESIGN SPECIFICATIONS, SECTION 12.12, ARE MET. THE 50 YEAR CREEP MODULUS DATA SPECIFIED IN ASTM F2418 OR ASTM F2922 MUST BE USED AS PART OF THE AASHTO STRUCTURAL EVALUATION TO VERIFY LONG-TERM PERFORMANCE.
  - STRUCTURAL CROSS SECTION DETAIL ON WHICH THE STRUCTURAL EVALUATION IS BASED.
- CHAMBERS AND END CAPS SHALL BE PRODUCED AT AN ISO 9001 CERTIFIED MANUFACTURING FACILITY.

### IMPORTANT - NOTES FOR THE BIDDING AND INSTALLATION OF THE SC-310/SC-740 SYSTEM

- STORMTECH SC-310 & SC-740 CHAMBERS SHALL NOT BE INSTALLED UNTIL THE MANUFACTURER'S REPRESENTATIVE HAS COMPLETED A PRE-CONSTRUCTION MEETING WITH THE INSTALLERS.
- STORMTECH SC-310 & SC-740 CHAMBERS SHALL BE INSTALLED IN ACCORDANCE WITH THE "STORMTECH SC-310/SC-740/DC-780 CONSTRUCTION GUIDE".
- CHAMBERS ARE NOT TO BE BACKFILLED WITH A DOZER OR AN EXCAVATOR SITUATED OVER THE CHAMBERS.
 

STORMTECH RECOMMENDS 3 BACKFILL METHODS:


  - STONES/ROCK LOCATED OFF THE CHAMBER BED.
  - BACKFILL AS ROWS ARE BUILT USING AN EXCAVATOR ON THE FOUNDATION STONE OR SUBGRADE.
  - BACKFILL FROM OUTSIDE THE EXCAVATION USING A LONG BOOM HOE OR EXCAVATOR.
- THE FOUNDATION STONE SHALL BE LEVELED AND COMPACTED PRIOR TO PLACING CHAMBERS.
- JOINTS BETWEEN CHAMBERS SHALL BE PROPERLY SEATED PRIOR TO PLACING STONE.
- MAINTAIN MINIMUM - 6" (150 mm) SPACING BETWEEN THE CHAMBER ROWS.
- EMBEDMENT STONE SURROUNDING CHAMBERS MUST BE A CLEAN, CRUSHED, ANGULAR STONE 3/4" - 2" (20-50 mm).
- THE CONTRACTOR MUST REPORT ANY DISCREPANCIES WITH CHAMBER FOUNDATION MATERIALS BEARING CAPACITIES TO THE SITE DESIGN ENGINEER.
- ADS RECOMMENDS THE USE OF "FLEXSTORM CATCH IT" INSERTS DURING CONSTRUCTION FOR ALL INLETS TO PROTECT THE SUBSURFACE STORMWATER MANAGEMENT SYSTEM FROM CONSTRUCTION SITE RUNOFF.

### NOTES FOR CONSTRUCTION EQUIPMENT

- STORMTECH SC-310 & SC-740 CHAMBERS SHALL BE INSTALLED IN ACCORDANCE WITH THE "STORMTECH SC-310/SC-740/DC-780 CONSTRUCTION GUIDE".
- THE USE OF CONSTRUCTION EQUIPMENT OVER SC-310 & SC-740 CHAMBERS IS LIMITED:
  - NO EQUIPMENT IS ALLOWED ON BARE CHAMBERS.
  - NO RUBBER Tired LOADERS, DUMP TRUCKS, OR EXCAVATORS ARE ALLOWED UNTIL PROPER FILL DEPTHS ARE REACHED IN ACCORDANCE WITH THE "STORMTECH SC-310/SC-740/DC-780 CONSTRUCTION GUIDE".
  - WEIGHT LIMITS FOR CONSTRUCTION EQUIPMENT CAN BE FOUND IN THE "STORMTECH SC-310/SC-740/DC-780 CONSTRUCTION GUIDE".
- FULL 36" (900 mm) OF STABILIZED COVER MATERIALS OVER THE CHAMBERS IS REQUIRED FOR DUMP TRUCK TRAVEL OR DUMPING.

USE OF A DOZER TO PUSH EMBEDMENT STONE BETWEEN THE ROWS OF CHAMBERS MAY CAUSE DAMAGE TO THE CHAMBERS AND IS NOT AN ACCEPTABLE BACKFILL METHOD. ANY CHAMBERS DAMAGED BY THE "DUMP AND PUSH" METHOD ARE NOT COVERED UNDER THE STORMTECH STANDARD WARRANTY.


CONTACT STORMTECH AT 1-888-892-2694 WITH ANY QUESTIONS ON INSTALLATION REQUIREMENTS OR WEIGHT LIMITS FOR CONSTRUCTION EQUIPMENT.

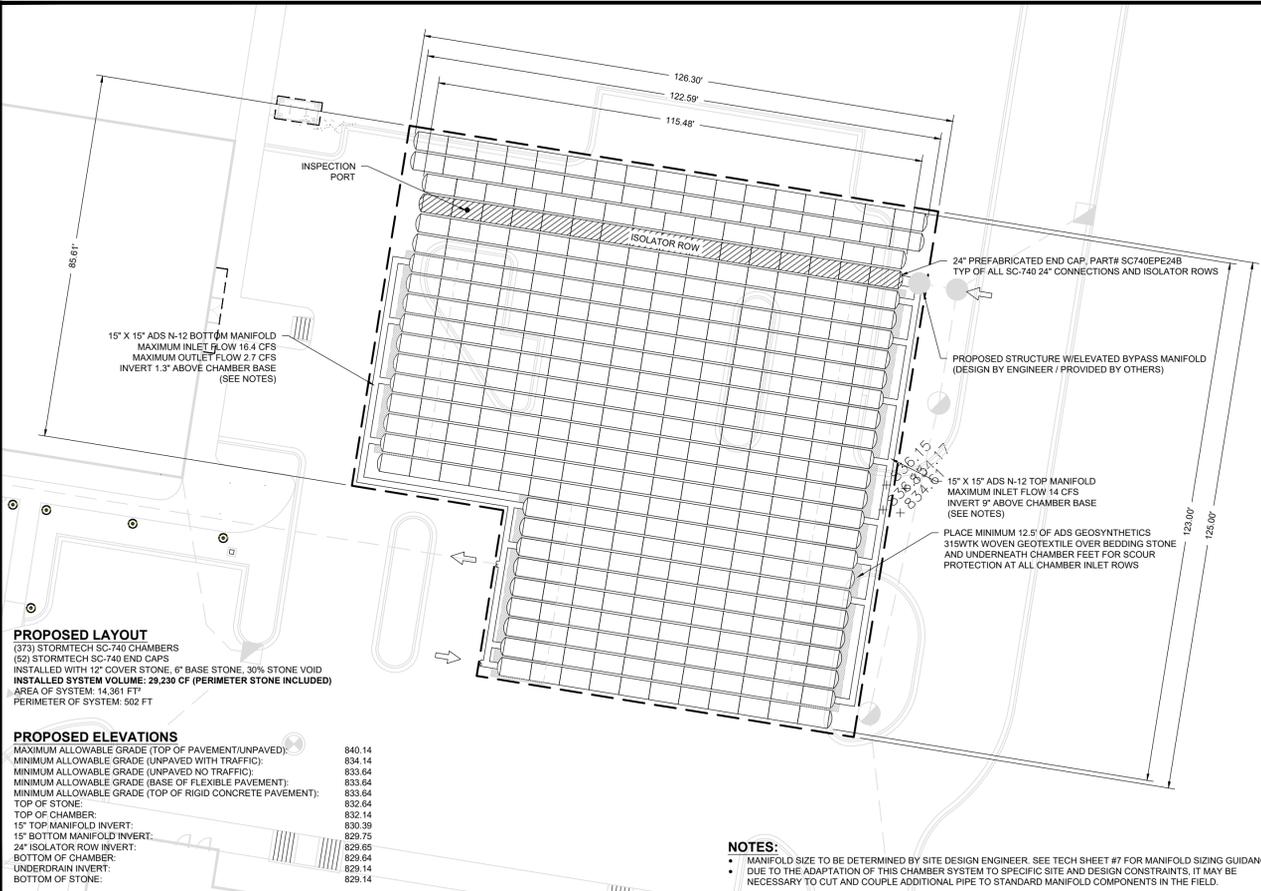

### ACCEPTABLE FILL MATERIALS: STORMTECH SC-740 CHAMBER SYSTEMS

MATERIAL LOCATION	DESCRIPTION	AASHTO MATERIAL CLASSIFICATIONS	COMPACTION / DENSITY REQUIREMENT
D FINAL FILL: FILL MATERIAL FOR LAYER 'D' STARTS FROM THE TOP OF THE 'C' LAYER TO THE BOTTOM OF FLEXIBLE PAVEMENT OR UNPAVED FINISHED GRADE ABOVE. NOTE THAT PAVEMENT SUBBASE MAY BE PART OF THE 'D' LAYER.	ANY SOIL/ROCK MATERIALS, NATIVE SOILS, OR PER ENGINEER'S PLANS. CHECK PLANS FOR PAVEMENT SUBGRADE REQUIREMENTS.	N/A	PREPARE PER SITE DESIGN ENGINEER'S PLANS. PAVED INSTALLATIONS MAY HAVE STRINGENT MATERIAL AND PREPARATION REQUIREMENTS.
C INITIAL FILL: FILL MATERIAL FOR LAYER 'C' STARTS FROM THE TOP OF THE EMBEDMENT STONE ('B' LAYER) TO 18" (450 mm) ABOVE THE TOP OF THE CHAMBER. NOTE THAT PAVEMENT SUBBASE MAY BE A PART OF THE 'C' LAYER.	GRANULAR WELL-GRADED SOIL/AGGREGATE MIXTURES, <35% FINES OR PROCESSED AGGREGATE. MOST PAVEMENT SUBBASE MATERIALS CAN BE USED IN LIEU OF THIS LAYER.	AASHTO M145 <sup>1</sup> A-1, A-2.4, A-3  OR AASHTO M43 <sup>3</sup> 3, 357, 4, 467, 5, 56, 57, 6, 67, 68, 7, 78, 8, 89, 9, 10	BEGIN COMPACTIONS AFTER 12" (300 mm) OF MATERIAL OVER THE CHAMBERS IS REACHED. COMPACT ADDITIONAL LAYERS IN 6" (150 mm) MAX LIFTS TO A MIN. 95% PROCTOR DENSITY FOR WELL GRADED MATERIAL AND 95% RELATIVE DENSITY FOR PROCESSED AGGREGATE MATERIALS. ROLLER GROSS VEHICLE WEIGHT NOT TO EXCEED 12,000 lbs (53 kN). DYNAMIC FORCE NOT TO EXCEED 20,000 lbs (89 kN).
B EMBEDMENT STONE: FILL SURROUNDING THE CHAMBERS FROM THE FOUNDATION STONE ('A' LAYER) TO THE 'C' LAYER ABOVE.	CLEAN, CRUSHED, ANGULAR STONE, NOMINAL SIZE DISTRIBUTION BETWEEN 3/4-2 INCH (20-50 mm)	AASHTO M43 <sup>3</sup> 3, 357, 4, 467, 5, 56, 57, 6, 67, 68, 7, 78, 8, 89, 9, 10	NO COMPACTION REQUIRED.
A FOUNDATION STONE: FILL BELOW CHAMBERS FROM THE SUBGRADE UP TO THE FOOT (BOTTOM) OF THE CHAMBER.	CLEAN, CRUSHED, ANGULAR STONE, NOMINAL SIZE DISTRIBUTION BETWEEN 3/4-2 INCH (20-50 mm)	AASHTO M43 <sup>3</sup> 3, 357, 4, 467, 5, 56, 57, 6, 67, 68, 7, 78, 8, 89, 9, 10	FLAT COMPACTION OR ROLL TO ACHIEVE A FLAT SURFACE. **

- PLEASE NOTE:  
 1. THE LISTED AASHTO DESIGNATIONS ARE FOR GRADATIONS ONLY. THE STONE MUST ALSO BE CLEAN, CRUSHED, ANGULAR. FOR EXAMPLE, A SPECIFICATION FOR #4 STONE WOULD STATE: "CLEAN, CRUSHED, ANGULAR NO. 4 (AASHTO M43) STONE".  
 2. STORMTECH COMPACTION REQUIREMENTS ARE MET FOR 'A' LOCATION MATERIALS WHEN PLACED AND COMPACTED IN 6" (150 mm) (MAX) LIFTS USING TWO FULL COVERAGES WITH A VIBRATORY COMPACTOR.  
 3. WHERE INFILTRATION SURFACE MAY BE COMPROMISED BY COMPACTION, FOR STANDARD DESIGN LOAD CONDITIONS, A FLAT SURFACE MAY BE ACHIEVED BY RAKING OR DRAGGING WITHOUT COMPACTION EQUIPMENT. FOR SPECIAL LOAD DESIGNS, CONTACT STORMTECH FOR COMPACTION REQUIREMENTS.

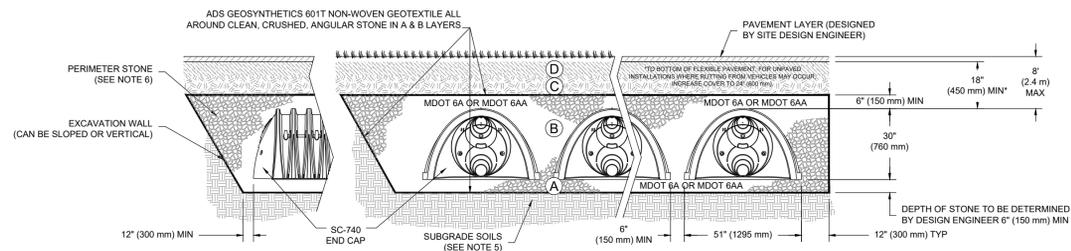

### NOTES:

- SC-740 CHAMBERS SHALL CONFORM TO THE REQUIREMENTS OF ASTM F2418 "STANDARD SPECIFICATION FOR POLYPROPYLENE (PP) CORRUGATED WALL STORMWATER COLLECTION CHAMBERS" OR ASTM F2922 "STANDARD SPECIFICATION FOR POLYETHYLENE (PE) CORRUGATED WALL STORMWATER COLLECTION CHAMBERS".
- SC-740 CHAMBERS SHALL BE DESIGNED IN ACCORDANCE WITH ASTM F2787 "STANDARD PRACTICE FOR STRUCTURAL DESIGN OF THERMOPLASTIC CORRUGATED WALL STORMWATER COLLECTION CHAMBERS".
- "ACCEPTABLE FILL MATERIALS" TABLE ABOVE PROVIDES MATERIAL LOCATIONS, DESCRIPTIONS, GRADATIONS, AND COMPACTION REQUIREMENTS FOR FOUNDATION, EMBEDMENT, AND FILL MATERIALS.
- THE "SITE DESIGN ENGINEER" REFERS TO THE ENGINEER RESPONSIBLE FOR THE DESIGN AND LAYOUT OF THE STORMTECH CHAMBERS FOR THIS PROJECT.
- THE SITE DESIGN ENGINEER IS RESPONSIBLE FOR ASSESSING THE BEARING RESISTANCE (ALLOWABLE BEARING CAPACITY) OF THE SUBGRADE SOILS AND THE DEPTH OF FOUNDATION STONE WITH CONSIDERATION FOR THE RANGE OF EXPECTED SOIL MOISTURE CONDITIONS.
- PERIMETER STONE MUST BE EXTENDED HORIZONTALLY TO THE EXCAVATION WALL FOR BOTH VERTICAL AND SLOPED EXCAVATION WALLS.
- ONCE LAYER 'C' IS PLACED, ANY SOIL/MATERIAL CAN BE PLACED IN LAYER 'D' UP TO THE FINISHED GRADE. MOST PAVEMENT SUBBASE SOILS CAN BE USED TO REPLACE THE MATERIAL REQUIREMENTS OF LAYER 'C' OR 'D' AT THE SITE DESIGN ENGINEER'S DISCRETION.

STAYBRIDGE SUITES & RETAIL  
ANN ARBOR, MICHIGAN  
DATE: 3-24-15  
DRAWN: SKR  
PROJECT #: 93256  
CHECKED: GFI

4640 TOLLEMAN BLVD  
HILLIARD, OH 43026  
1-800-733-7473

ADS  
ADVANCED DRAINAGE SYSTEMS, INC.  
11500 STATE ROUTE 100  
WINDYBROOK VALLEY, INDIANAPOLIS, IN 46254

SHEET 3 OF 5

STAYBRIDGE SUITES & RETAIL  
ANN ARBOR, MICHIGAN  
DATE: 3-24-15  
DRAWN: SKR  
PROJECT #: 93256  
CHECKED: GFI

4640 TOLLEMAN BLVD  
HILLIARD, OH 43026  
1-800-733-7473

ADS  
ADVANCED DRAINAGE SYSTEMS, INC.  
11500 STATE ROUTE 100  
WINDYBROOK VALLEY, INDIANAPOLIS, IN 46254

SHEET 4 OF 5

**SC-740 ISOLATOR ROW DETAIL**  
NTS

COVER ENTIRE ISOLATOR ROW WITH ADS GEOSYNTHETICS 601T NON-WOVEN GEOTEXTILE 8" (2.4 m) MIN WIDE

STORMTECH HIGHLY RECOMMENDS FLEXSTORM PURE INSERTS IN ANY UPSTREAM STRUCTURES WITH OPEN GRATES

SC-740 CHAMBER

OPTIONAL INSPECTION PORT

SC-740 END CAP

CATCH BASIN OR MANHOLE

SUMP DEPTH TBD BY SITE DESIGN ENGINEER (24" (600 mm) MIN RECOMMENDED)

24" (600 mm) HDPE ACCESS PIPE REQUIRED USE FACTORY PRE-FABRICATED END CAP PART #: SC740EPE24B

TWO LAYERS OF ADS GEOSYNTHETICS 315WTK WOVEN GEOTEXTILE BETWEEN FOUNDATION STONE AND CHAMBERS 5" (1.5 m) MIN WIDE CONTINUOUS FABRIC WITHOUT SEAMS

**INSPECTION & MAINTENANCE**

STEP 1) INSPECT ISOLATOR ROW FOR SEDIMENT

A. INSPECTION PORTS (IF PRESENT)

A.1. REMOVE/OPEN LID ON NYLOPLAST INLINE DRAIN

A.2. REMOVE AND CLEAN FLEXSTORM FILTER IF INSTALLED

A.3. USING A FLASHLIGHT AND STADA ROD, MEASURE DEPTH OF SEDIMENT AND RECORD ON MAINTENANCE LOG

A.4. LOWER A CAMERA INTO ISOLATOR ROW FOR VISUAL INSPECTION OF SEDIMENT LEVELS (OPTIONAL)

A.5. IF SEDIMENT IS AT, OR ABOVE, 3" (80 mm) PROCEED TO STEP 2; IF NOT, PROCEED TO STEP 3.

B. ALL ISOLATOR ROWS

B.1. REMOVE COVER FROM STRUCTURE AT UPSTREAM END OF ISOLATOR ROW

B.2. USING A FLASHLIGHT, INSPECT DOWN THE ISOLATOR ROW THROUGH OUTLET PIPE

i) MIRRORS ON POLES OR CAMERAS MAY BE USED TO AVOID A CONFINED SPACE ENTRY

ii) FOLLOW OSHA REGULATIONS FOR CONFINED SPACE ENTRY IF ENTERING MANHOLE

B.3. IF SEDIMENT IS AT, OR ABOVE, 3" (80 mm) PROCEED TO STEP 2; IF NOT, PROCEED TO STEP 3.

STEP 2) CLEAN OUT ISOLATOR ROW USING THE JET/VAC PROCESS

A. A FIXED CULVERT CLEANING NOZZLE WITH REAR FACING SPREAD OF 45° (1.1 m) OR MORE IS PREFERRED

B. APPLY MULTIPLE PASSES OF JET/VAC UNTIL BACKFLUSH WATER IS CLEAN

C. VACUUM STRUCTURE SUMP AS REQUIRED

STEP 3) REPLACE ALL COVERS, GRATES, FILTERS, AND LIDS, RECORD OBSERVATIONS AND ACTIONS.

STEP 4) INSPECT AND CLEAN BASINS AND MANHOLES UPSTREAM OF THE STORMTECH SYSTEM.

**NOTES**

- INSPECT EVERY 6 MONTHS DURING THE FIRST YEAR OF OPERATION. ADJUST THE INSPECTION INTERVAL BASED ON PREVIOUS OBSERVATIONS OF SEDIMENT ACCUMULATION AND HIGH WATER ELEVATIONS.
- CONDUCT JETTING AND VACTORING ANNUALLY OR WHEN INSPECTION SHOWS THAT MAINTENANCE IS NECESSARY.

**SC-740 INSPECTION PORT DETAIL**  
NTS

CONCRETE COLLAR

PAVEMENT

CONCRETE COLLAR NOT REQUIRED FOR UNPAVED APPLICATIONS

12" (300 mm) NYLOPLAST INLINE DRAIN BODY W/SLID HINGED COVER OR GRATE PART# 2712AG10N SOLID COVER 1299CGG GRATE: 1299CGS

CONCRETE SLAB 8" (200 mm) MIN THICKNESS

FLEXSTORM CATCH IT PART# 621NYFX WITH USE OF OPEN GRATE

10" (250 mm) ADS N-12 HDPE PIPE

SC-740 CHAMBER

THE LOCATION OF ALL UNDERGROUND UTILITIES AS SHOWN ON THESE DRAWINGS ARE BASED ON RECORDS PROVIDED BY THE UTILITY OWNERS AND VISIBLE EVIDENCE OBTAINED IN THE FIELD. NO GUARANTEE IS EITHER EXPRESSED OR IMPLIED TO THE COMPLETENESS OR ACCURACY THEREOF.



STARLAR DEVELOPMENT, LLC  
2600 AUBURN ROAD, SUITE 160  
AUBURN HILLS, MI 48326  
PH 810-444-7815  
FX 248-553-4218

PREPARED UNDER THE DIRECTION OF:  
ANDREW ANDRE, P.E.  
MI #47380

APPLICANT:  
STARLAR HOSPITALITY ANN ARBOR, LLC  
2600 AUBURN ROAD, SUITE 240  
AUBURN HILLS, MI 48326  
PH 248-419-5551

STAYBRIDGE SUITES & RETAIL CENTER  
3860 RESEARCH PARK DRIVE  
ANN ARBOR, MI 48108



SHEET TITLE:  
UNDERGROUND DETENTION PLANS

SHEET C5.8

DATE: 03/06/16  
SQA  
01/21/21


SCALE: AS NOTED  
DB NO: BD-14-322



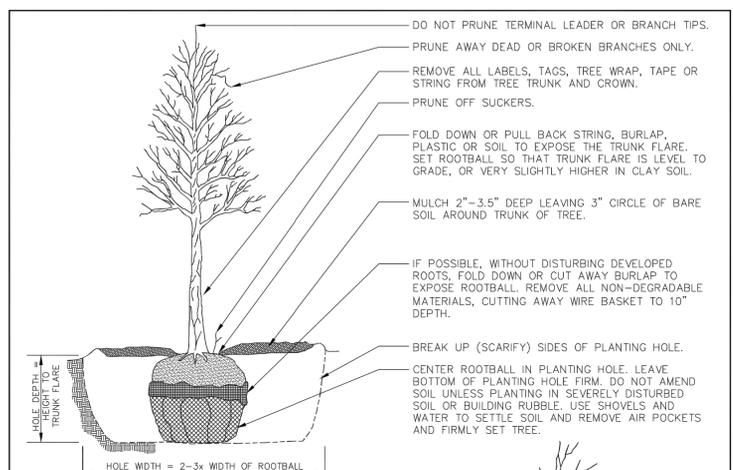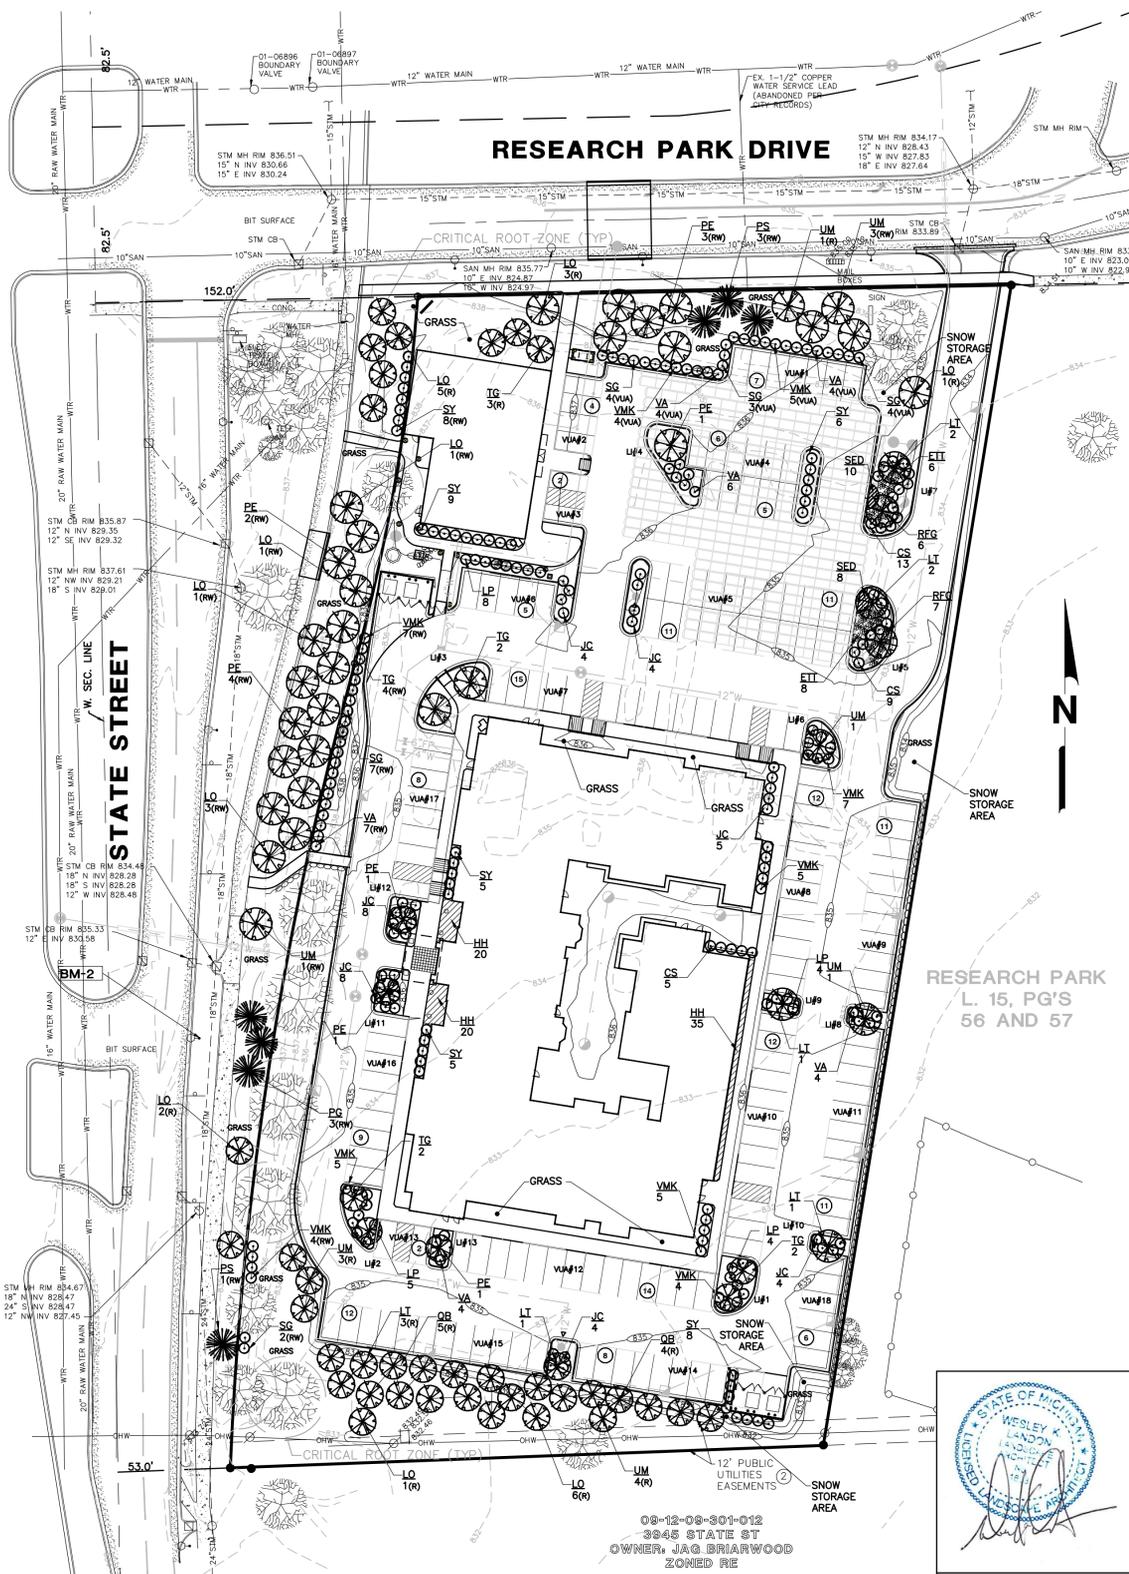

- DO NOT STAKE UNLESS IN HEAVY CLAY SOIL, WINDY CONDITIONS, 3" OR GREATER DIAMETER TREE TRUNK OR LARGE CROWN. IF STAKING IS NEEDED DUE TO THESE CONDITIONS:
- STAKE WITH 2 x 2 HARDWOOD STAKES, OR APPROVED EQUAL, DRIVEN 6"-8" OUTSIDE OF ROOTBALL.
  - LOOSELY STAKE TREE TRUNK TO ALLOW FOR TRUNK FLEXING.
  - STAKE TREES JUST BELOW FIRST BRANCH WITH 2"-3" WIDE BELT-LIKE, NYLON OR PLASTIC STRAPS (2 PER TREE ON OPPOSITE SIDES OF TREE, CONNECT FROM TREE TO STAKE HORIZONTALLY. DO NOT USE ROPE OR WIRE THROUGH A HOSE.)
  - REMOVE ALL STAKING MATERIALS AFTER 1 YEAR.

REVISIONS	REV. NO.	DR. BY	CH. BY	DATE
<b>PUBLIC SERVICES DEPARTMENT CITY OF ANN ARBOR</b>				
<b>TREE PLANTING DETAIL</b>				
DR. BY	ARG	CH. BY	CSS	DRAWING NO.
SCALE	NONE	DATE	7-23-10	SD-L-3
INCH				SHEET NO. _____ OF _____

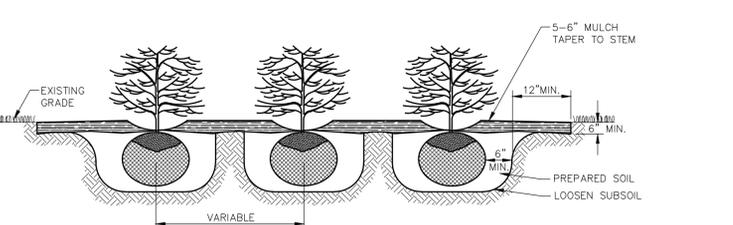

-FIRST AND SECOND WATERING AND CULTIVATION SHALL INCLUDE SHRUB BEDS.  
-CUT 6" X 12" (MIN.) EDGING AROUND THE PERIMETER OF ALL SHRUB BEDS SHOWN ON THE PLANS. SPRAY A NON-PERSISTENT GLYPHOSATE HERBICIDE TO ENTIRE SHRUB BEDS PRIOR TO PLANTING AND BARK PLACEMENT.  
-SHRUB BEDS ARE TO BE PAID FOR BY THE PAY ITEM "SITE PREPARATION".  
-ALL PLANTS SHALL BE SET PLUMB AND HAVE THE BEST SIDE OF PLANT FACING THE MAIN VIEWING DIRECTION.

**SHRUB BED DETAIL**  
SCALE: NONE

QUANTITY	KEY	BOTANICAL NAME	COMMON NAME	SIZE
75	HH	HEMEROCALLIS 'HAPPY RETURNS'	HAPPY RETURNS DAYLILLY	#1 POT
18	SED	SEDUM X. 'NEON'	NEON SEDUM	#1 POT
14	EIT	ECHINACEA 'TIKI TORCH'	TIKI TORCH ORANGE CONEFLOWER	#1 POT
13	RFG	RUBRIBECKIA FULGIDA S. 'GOLDSTRUM'	GOLDSTRUM ORANGE CONEFLOWER	#1 POT
27	CS	CORNUS SERICEA	RED TWIG DOGWOOD	24" HT B&B
41	SY	TAXUS S.M. 'SEBIAN'	SEBIAN YEW	24" HT B&B
21	LP	SPIRAEA JAPONICA 'LITTLE PRINCESS'	LITTLE PRINCESS SPIRAEA	24" HT B&B
20	SG	SPIREA JAPONICA 'GOLDFLAME'	GOLDFLAME SPIRAEA	24" HT B&B
46	VMA	VIBURNUM X.B. 'MOHAWK'	MOHAWK VIBURNUM	24" HT B&B
29	VA	VIBURNUM DENTATUM	ARROWWOOD VIBURNUM	24" HT B&B
37	JC	JUNIPERUS C. 'SEAGREEN'	SEA GREEN JUNIPER	24" HT B&B
4	PS	PINUS STROBUS	EASTERN WHITE PINE	8' HT.
3	PG	PICEA GLAUCA	WHITE SPRUCE	8' HT.
14	UM	ULMUS AMERICANA 'VALLEY FORGE'	VALLEY FORGE AMERICAN ELM	2" CAL B&B
24	LO	GLEDITSIA T. INERMIS 'SKYCOLE'	SKYLINE LOCUST	2-1/2" CAL B&B
13	TG	TILIA CORDATA 'GREENSPIRE'	GREENSPIRE LINDEN	2" CAL B&B
10	LT	LIRIODENDRON TULIPIFERA	TULIPTREE	2" CAL B&B
9	QB	QUERCUS BICOLOR	SWAMP WHITE OAK	2" CAL B&B
13	PE	PLATANUS X EXCLAMATION	LONDON PLANETREE	2" CAL B&B

LI#	S.F.
1	409
2	444
3	604
4	534
5	586
6	300
7	567
8	165
9	165
10	165
11	275
12	275
13	165
14	214
	4868

VUA#	S.F.
1	1134
2	648
3	432
4	1782
5	3563.41
6	816.1
7	2717.70
8	1948.09
9	1781.8
10	2087.54
11	1943.78
12	2267.53
13	467.95
14	1619.64
15	1952.57
16	1466.67
17	1421.68
18	971.91
	29022.37

Total =	29,022.37
Use Ratio =	20
Req. S.F. =	1452
DEPRESSED BIORETENTION	
Req. % =	50%
Area =	1452
Req Area =	726
UTILIZE ISLANDS	
5	586
7	567
Total Prov. =	1153

STREET TREE ESCROW CALCULATION	
SOUTH STATE STREET	
558 LF ROADWAY	
12 # EX. TREES	
45 LF DEDUCT / TREE	
540 DEDUCT	
18 LF	
\$ 1.30 RATE	
\$ 23.40 ESCROW	
RESEARCH PARK DRIVE	
280 LF ROADWAY	
2 # EX. TREES	
45 LF DEDUCT / TREE	
90 DEDUCT	
190 LF	
\$ 1.30 RATE	
\$ 247.00 ESCROW	

**SOUTH STATE STREET RIGHT-OF-WAY LANDSCAPING**  
1 TREE / 30 L.F. OF FRONTAGE  
558 L.F. / 30 = 18.6 = 19 TREES  
R.O.W. LANDSCAPING REQUIRED = 19 TREES  
R.O.W. LANDSCAPING PROVIDED = 21 TREES

(RW) = RIGHT-OF-WAY TREES  
**RESEARCH PARK DRIVE RIGHT-OF-WAY LANDSCAPING**  
1 TREE / 30 L.F. OF FRONTAGE  
280 L.F. / 30 = 9.3 = 9 TREES  
R.O.W. LANDSCAPING REQUIRED = 9 TREES  
R.O.W. LANDSCAPING PROVIDED = 9 TREES

(RW) = RIGHT-OF-WAY TREES  
**VEHICULAR USE AREA LANDSCAPING**  
1 SHRUB / 4 L.F. OF V.U.A. FRONTAGE  
64 L.F. / 4 = 16 SHRUBS  
V.U.A. LANDSCAPING REQUIRED = 16 SHRUBS  
V.U.A. LANDSCAPING PROVIDED = 16 SHRUBS

(VUA) = VEHICULAR USE AREA RIGHT-OF-WAY PLANTINGS  
**GENERAL NOTES**

- CONTRACTOR TO PROVIDE DESIGN AND INSTALLATION OF UNDERGROUND IRRIGATION SYSTEM IN ACCORDANCE WITH PROJECT SPECIFICATIONS AND REGULATORY AGENCY REQUIREMENTS. ALL LANDSCAPING AND GRASS AREAS TO BE IRRIGATED. IRRIGATION CONTROL PANEL SHALL BE LOCATED WITHIN THE HVAC ENCLOSURE.
- ALL GREEN SPACES AND PLANTING AREAS SHALL BE IRRIGATED.
- IT IS THE CONTRACTOR'S RESPONSIBILITY TO SECURE ALL PERMITS AND POST ALL BONDS PRIOR TO CONSTRUCTION.
- REFER TO PLUMBING PLANS FOR LOCATION OF IRRIGATION METER.
- ALL GRASS AREAS TO BE SOODED.
- SPACE ALL SHRUBS AT 5- FEET ON CENTER UNLESS OTHERWISE INDICATED ON THE PLANS
- ALL DISTURBED LAWN AREAS SHALL BE RESTORED TO AT LEAST PREVIOUS CONDITION IN ACCORDANCE WITH PROJECT SPECIFICATIONS.
- THE GENERAL CONTRACTOR SHALL INCLUDE TOPSOIL IN BASE BID. NO GUARANTEE IS EITHER EXPRESSED OR IMPLIED AS TO THE AMOUNT OF TOPSOIL AVAILABLE ON-SITE.

**DESCRIPTION**  
THIS WORK SHALL CONSIST OF PROVIDING ALL NECESSARY MATERIALS, LABOR, EQUIPMENT, TOOLS AND SUPERVISION REQUIRED FOR THE EXECUTION AND GUARANTEE OF ALL PLANTINGS AND RELATED WORK AS SHOWN ON THE DRAWINGS.  
PLANT MATERIALS SHALL CONFORM TO THE SIZES STATED ON THE PLANT LIST AND SHALL BE OF A MINIMUM SIZE OR LARGER. ALL MEASUREMENTS OF SPREAD, CALIPER, BALL SIZE, TRUNK CROWN RATIO, QUALITY DESIGNATIONS, ETC., SHALL BE IN ACCORDANCE WITH THE LATEST EDITION OF THE "ANSI STANDARDS FOR NURSERY STOCK". PLANT MATERIAL SHALL BE NURSERY GROWN AND INSPECTED BY THE OWNER'S REPRESENTATIVE AT THE SITE PRIOR TO PLANTING. THE OWNER'S REPRESENTATIVE RESERVES THE RIGHT TO REQUEST ANY PLANT MATERIAL AT ANY TIME.

NURSERY STOCK SHALL BE PREPARED FOR SHIPMENT IN ACCORDANCE WITH THE REQUIREMENTS OF THE CURRENT ANSI SPECIFICATION 260.1 AND SHALL BE ENCLOSED OR COVERED DURING TRANSPORTATION TO PREVENT DRYING.

**SITE PREPARATION**  
THE CONTRACTOR SHALL VERIFY ALL EXISTING AND PROPOSED UTILITY LOCATIONS PRIOR TO CONSTRUCTION AND PROTECT AND REPAIR UTILITIES ENCOUNTERED DURING CONSTRUCTION WHETHER SHOWN ON THE PLANS OR NOT.

INDIVIDUAL HOLES SHALL BE CENTERED AT STAKED PLANT LOCATIONS. CONTRACTOR IS TO STAKE PRIOR TO PLACEMENT OF PLANT MATERIAL AND OBTAIN APPROVAL FROM THE OWNER'S REPRESENTATIVE. PLANTING HOLES SHALL BE DUG LARGE ENOUGH TO PERMIT PLACING PREPARED TOPSOIL 18" LATERALLY BEYOND THE ENDS OF THE ROOT BALLS FOR SHADE AND EVERGREEN TREES AND 6" LATERALLY FOR SHRUBS UNLESS OTHERWISE SPECIFIED.

EXCAVATED MATERIAL SHALL BE REMOVED FROM THE SITE AT THE TIME THE HOLE IS DUG. THE PLANTING HOLE SHALL BE BACKFILLED WITH PREPARED TOPSOIL THE SAME DAY THEY ARE DUG.

TOPSOIL SHALL AT FERTILE, FRIABLE, NATURAL TOPSOIL OF CLAY LOAM CHARACTER CONTAINING AT LEAST 5% BUT NOT MORE THAN 20% BY WEIGHT OF ORGANIC MATTER WITH A PH RANGE FROM 6.0 TO 7.0. TOPSOIL SHALL BE FREE OF CLAY LUMPS, COURSE SAND, STONES, PLANT ROOTS, STICKS OR OTHER FOREIGN MATTER.

**CARE FOR PLANTS BEFORE PLANTING**  
PLANTS DESIGNATED "BB" SHALL BE BALLED AND BURLAPPED WITH FIRM NATURAL BALLS OF EARTH. CRACKED, LOOSENED OR BROKEN BALLS SHALL NOT BE PLANTED. THEY SHALL BE MARKED WITH SPRAY PAINT AND IMMEDIATELY REMOVED FROM THE JOB SITE. IMMEDIATELY FOLLOWING DELIVERY AT THE JOB SITE, ALL PLANTS THAT WILL NOT BE PLANTED THAT SAME DAY SHALL BE "HEELED IN" WITH SHREDDED BARK OR MOIST SOIL AND KEPT MOIST UNTIL PLANTED.  
THE TRUNKS AND BRANCHES OF ALL TREES SHALL BE PROTECTED FROM INJURY OF ANY KIND DURING ALL OPERATIONS. THE OWNER'S REPRESENTATIVE SHALL REJECT ANY TREES THAT ARE INJURED.

**PLANTING**  
THE CONTRACTOR IS RESPONSIBLE FOR PLANTING MATERIALS PLUMB, SET THE TOP OF THE ROOT BALL AT OR SLIGHTLY HIGHER THAN THE SURROUNDING GRADE. PLANTS SHALL BE FACED TO GIVE THE BEST APPEARANCE OR RELATIONSHIP TO ADJACENT STRUCTURES. NO FILLING WILL BE PERMITTED AROUND TRUNK OR STEMS. WHEN THE PLANT HAS BEEN PROPERLY SET, THE HOLE SHALL BE BACKFILLED TO 1/2 THE DEPTH OF THE BALL WITH PREPARED TOPSOIL MIXTURE, FIRMLY PACKED AND WATERED-IN AT TIME OF PLANTING. LOOSED AND REMOVE BURLAP AND LACING FROM UPPER 1/3 OF THE ROOT BALL. BACKFILL WITH PREPARED TOPSOIL, WHICH AFTER COMPACTION IS FLUSH WITH THE SURROUNDING GROUND.


**MULCHING**  
ALL PLANT MATERIAL SHALL BE ENCIRCLED WITH A COVERING OF NON-DYED SHREDDED BARK MULCH TO 6" OUTSIDE THE PLANTING HOLE. MULCH SHALL NOT BE TOUCHING THE TRUNK OF ANY TREE. SUBMIT SAMPLE TO THE OWNER'S REPRESENTATIVE FOR APPROVAL BEFORE PLACEMENT. WOOD CHIPS SHALL NOT BE ALLOWED ON THIS JOB. MULCHING SHALL FOLLOW THE CITY OF ANN ARBOR PLANTING DETAILS.

**STEEL LANDSCAPE EDGING**  
4" STEEL LANDSCAPE EDGING SHALL BE USED ON THIS PROJECT. ALUMINUM OR PLASTIC EDGING WILL NOT BE ALLOWED.

**PRUNING**  
UPON COMPLETION, ONLY PRUNE DEAD OR BROKEN BRANCHES FROM TREES. THE AMOUNT OF PRUNING SHALL BE LIMITED TO THE MINIMUM NECESSARY TO REMOVE DEAD OR INJURED BRANCHES. PRUNING PAINT SHALL NOT BE USED.

**FINISHING AND CLEANING UP**  
IMMEDIATELY UPON COMPLETION OF THE WORK, THE CONTRACTOR SHALL CLEAN UP THE AREA OF SURPLUS MATERIALS. THE CONTRACTOR SHALL REPAIR AND RE-ESTABLISH TURF IN RUTTED AREAS.

**WARRANTY**  
THE LANDSCAPE INSTALLATION CONTRACTOR SHALL REPLACE ALL UNHEALTHY VEGETATION AND PLANTINGS WITHIN ONE (1) YEAR OF INITIAL PLANTING OR SUBSEQUENT PLANTING PERIOD.

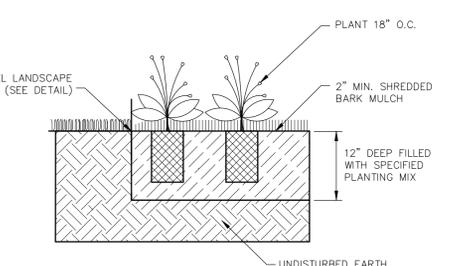

**PERENNIAL PLANTING BED**  
SCALE: NONE

**CITY OF ANN ARBOR LANDSCAPE NOTES**

- LANDSCAPE CONTRACTOR SHALL REFER TO CITY OF ANN ARBOR LANDSCAPE AND SCREENING ORDINANCE (CHAPTER 62)
- COMPACTED SOILS SHALL BE SCARIFIED TO A DEPTH OF 6" TO ELIMINATE ANY SOIL COMPACTION CREATED DURING CONSTRUCTION.
  - ALL DISEASED, DAMAGED, OR DEAD MATERIAL SHALL BE REPLACED IN ACCORDANCE WITH CHAPTER 62 BY THE END OF THE FOLLOWING PLANTING SEASON.
  - SNOW STORAGE AREAS ARE INDICATED ON THE PLAN. SNOW SHALL NOT BE PUSHED ON TO THE INTERIOR LANDSCAPE ISLANDS.
  - THE CITY OF ANN ARBOR HAS ADOPTED AN ORDINANCE LIMITING PHOSPHORUS IN FERTILIZER. TO ASSIST IN COMPLIANCE WITH THE STATE MANDATED TOL FOR PHOSPHORUS WITHIN THE MIDDLE HURON RIVER BASIN, APPLICATIONS OF FERTILIZER BEYOND THE INITIAL TOPSOIL AND SEEDING SHALL BE A FERTILIZER WITH NO PHOSPHORUS.

**STELLAR DEVELOPMENT, LLC**  
2600 AUBURN ROAD, SUITE 140  
AUBURN HILLS, MI 48326  
PH 810-444-7815  
FX 248-553-4218

PREPARED UNDER THE DIRECTION OF:  
ANDREW ANDRE, P.E.  
MI #47380

APPLICANT:  
STELLAR HOSPITALITY ANN ARBOR, LLC  
2600 AUBURN ROAD, SUITE 240  
AUBURN HILLS, MI 48326  
PH 248-419-5551

**STAYBRIDGE SUITES & RETAIL CENTER**  
3860 RESEARCH PARK DRIVE  
ANN ARBOR, MI 48108


THIS PLAN AND ALL INFORMATION CONTAINED HEREIN ARE THE PROPERTY OF STELLAR DEVELOPMENT, LLC. NO PART OF THIS PLAN OR INFORMATION SHALL BE REPRODUCED OR TRANSMITTED IN ANY FORM OR BY ANY MEANS, ELECTRONIC OR MECHANICAL, INCLUDING PHOTOCOPYING, RECORDING, OR BY ANY INFORMATION STORAGE AND RETRIEVAL SYSTEM, WITHOUT THE WRITTEN PERMISSION OF STELLAR DEVELOPMENT, LLC. THE USER SHALL BE RESPONSIBLE FOR OBTAINING ALL NECESSARY PERMITS AND APPROVALS FROM THE CITY OF ANN ARBOR AND ANY OTHER AGENCIES. THE USER SHALL BE RESPONSIBLE FOR OBTAINING ALL NECESSARY PERMITS AND APPROVALS FROM THE CITY OF ANN ARBOR AND ANY OTHER AGENCIES. THE USER SHALL BE RESPONSIBLE FOR OBTAINING ALL NECESSARY PERMITS AND APPROVALS FROM THE CITY OF ANN ARBOR AND ANY OTHER AGENCIES.

ISSUED FOR	DATE
SPA	12/29/14
SPA	02/20/15
SPA	03/23/15
SPA	04/23/15
PERMITS	08/12/15
SPA	08/17/15
CONST PLANS	09/05/15
CONST PLANS	10/02/15
CONST PLANS	11/05/15
CONST PLANS	12/09/15
UD DETENTION	03/06/16
LANDSCAPE REV.	04/04/17
LANDSCAPE REV.	04/07/17
SPA	01/21/21

DATE: \_\_\_\_\_  
DRAWN: ACA  
CHECKED: \_\_\_\_\_  
SCALE: 1"=40'  
JOB NO: BD-14-322  
SHEET TITLE: **LANDSCAPE PLAN AND DETAILS**  
SHEET **L1.0**

**811**  
Know what's below.  
Call before you dig.

THE LOCATION OF ALL UNDERGROUND UTILITIES AS SHOWN ON THESE DRAWINGS ARE BASED ON RECORDS PROVIDED BY THE UTILITY OWNERS AND VISIBLE EVIDENCE OBTAINED IN THE FIELD. NO GUARANTEE IS EITHER EXPRESSED OR IMPLIED TO THE COMPLETENESS OR ACCURACY THEREOF.

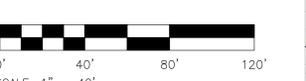

Tree	dbh	INCHES Caliper replacement required
2421	21	
2422	24	
2423	19	
2424	17	
2426	23	
2427	21	
2440	18	
2441	20	
2444	19	
182		INCHES Caliper replacement required
50%		Replacement Ratio (50% DBH)
91		Required Caliper (inches) Replacement

WESLEY K. LANDON, ASLA  
LANDSCAPE ARCHITECT  
NATIVE EDGE, LLC  
PO BOX 140021  
GRAND RAPIDS, MI 49514