




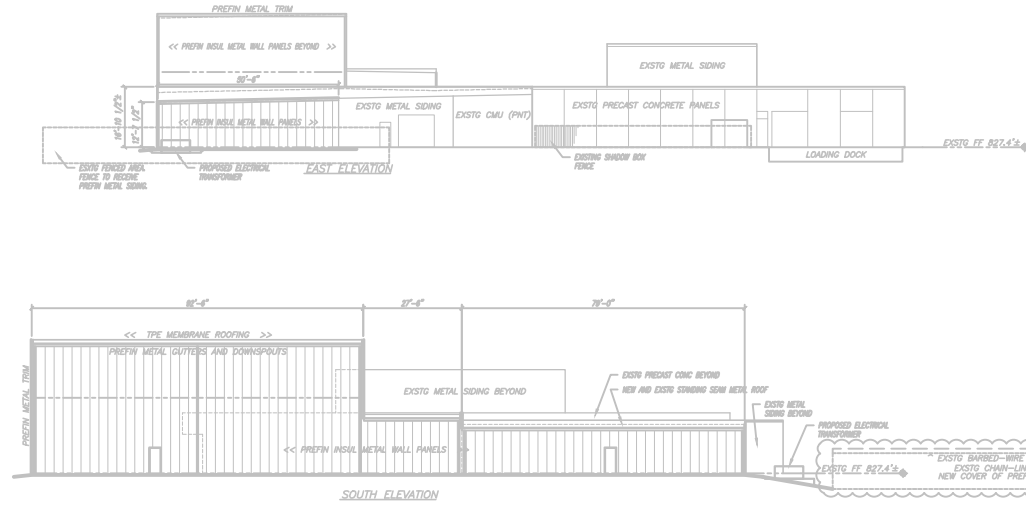


AIRIAL PHOTO W/ PROPOSED ADDITION - 100' EXTENDING SOUTH

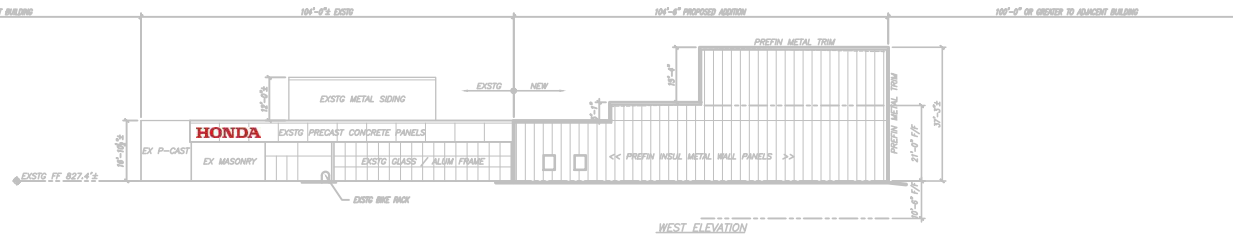

EXTERIOR ELEVATIONS  
1/16" = 1'-0"

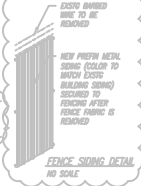

EXISTING BUILDING

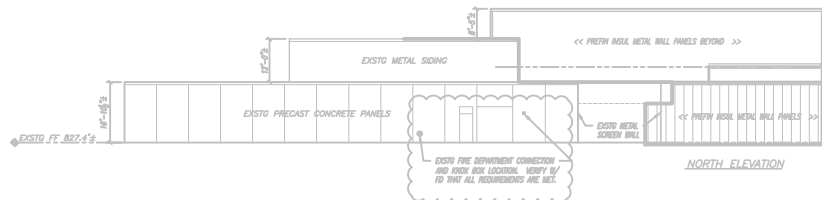

| NO | DATE    | DESCRIPTION                                   |
|----|---------|-----------------------------------------------|
| 2  | 7/22/13 | RE-ISSUED FOR ANN ARBOR PLAN REVIEW REVISIONS |
| 1  | 6/24/13 | ISSUED FOR ANN ARBOR PLAN REVIEW              |



**POGGEMEYER DESIGN GROUP, INC.**  
ARCHITECTS & ENGINEERS  
1188 NORTH MAIN STREET (419) 352-7537 BOWLING GREEN, OHIO 43402

**Honda Corporation USA Office**  
2000 WEST MAIN AVENUE, SUITE 100  
ANN ARBOR, MI 48106-1522  
PHONE: (734) 462-2200 FAX: (734) 462-2222

**HONDA**  
TESTING FACILITY EXPANSION  
ANN ARBOR, MICHIGAN

**PROPOSED ELEVATIONS**

REVIEWED BY: ENF  
REVISION

4  
OF  
20  
8118-004