### PLANNING AND DEVELOPMENT SERVICES STAFF REPORT

For Planning Commission Meeting of September 3, 2014

SUBJECT: MAVD Financial Institution Rezoning, Special Exception Use, Site Plan for City Council Approval, and Street Vacation (2727 South State Street) File Nos. Z14-022, SEU14-012, SP14-034, and SV14-003

### PROPOSED CITY PLANNING COMMISSION MOTION

The Ann Arbor City Planning Commission hereby recommends that the Mayor and City Council approve the MAVD Financial Institution rezoning from M1 (Limited Industrial District) to O (Office District).

### PROPOSED CITY PLANNING COMMISSION MOTION

The Ann Arbor City Planning Commission, after hearing all interested persons and reviewing all relevant information, finds the petition to substantially meet the standards in Chapter 55 (Zoning Ordinance), Sections 5:10.12(3)(c) and 5:104 (Special Exceptions), subject to approval of the corresponding site plan, and, therefore, approves the MAVD Financial Institution Special Exception Use for a four-lane drive-thru financial facility.

### PROPOSED CITY PLANNING COMMISSION MOTION

The Ann Arbor City Planning Commission hereby recommends that the Mayor and City Council approve the MAVD Financial Institution Site Plan, subject to: 1) special exception use approval for a drive-thru facility; 2) recording of cross access easements, 3) approval of a land division, and 4) approval of an administrative amendment to the parent site plan and the site plan located north of this site.

### PROPOSED CITY PLANNING COMMISSION MOTION

The Ann Arbor City Planning Commission hereby recommends that the Mayor and City Council approve the vacation of a 50-foot wide easement for future right-of-way across 2727 South State Street.

### PROPOSED CITY PLANNING COMMISSION MOTION

The Ann Arbor City Planning Commission hereby approves the proposed landscape modifications to South State Commons I (2723 South State Street) and South State Commons III (2727 South State Street) in order to maintain their previously approved landscape plans in accordance with Chapter 62 (Landscape and Screening Ordinance), Section 5:608(2)(c).

### STAFF RECOMMENDATION

Staff recommends that the rezoning petition be **approved** because the proposed uses permitted under the O (Office) zoning district are consistent with the recommendations of the <u>Master Plan:</u> <u>Land Use Element</u> and would be compatible with the City's adopted plans and policies and with the surrounding properties.

Staff recommends that the special exception use petition for a drive-thru facility be **approved** because the proposed use is of such location, size and character as to be compatible with the zoning district in which the site is situated; and the location and size of the proposed use, its nature and intensity, the site layout and access, and effect of the proposed use on public services would not be hazardous or inconvenient to the neighborhood nor unduly conflict with the normal traffic or the neighborhood.

Staff recommends that the site plan petition be **approved** because the plan would comply with all local, state and federal laws and regulations; the development would limit the disturbance of natural features to the minimum necessary to allow a reasonable use of the land; and the development would not cause a public or private nuisance and would not have a detrimental effect on public health, safety or welfare.

Staff recommends that the vacation request for a 50-foot wide easement for future right-of-way across 2727 South State Street be **approved**. The vacation does not adversely impact future street expansion and is consistent with existing traffic circulation.

Staff recommends that the landscape modification request for South State Commons I and South State Commons III be **approved** because the modifications are consistent with the intent of the ordinance and are associated with previously approved site plans.

### LOCATION

This site is located at the east side of South State Street, between Oakbrook Drive and Eisenhower Parkway (South Area, Malletts Creek Watershed, Ward 4).

### **DESCRIPTION OF PETITION**

The petitioner seeks to construct a 5,000-square foot financial institution, including a drive-thru facility, on a newly created parcel and rezone that new parcel from M1 (Limited Industrial District) to O (Office District).

<u>Subject Site</u> – A 0.8 acre parcel for the proposed financial institution is being created through a land division and land transfer petition (administrative procedures) and an easement vacation request (herein). A 0.2 acre portion at the northwest corner of 2727 South State Street will be transferred to 2723 South State Street (adjacent to the north). A 50-foot wide by 230-foot long easement for future right-of-way across 2727 South State Street is to be vacated. The parcel for the proposed financial institution will be comprised of the vacated easement and area from 2727 South State Street.

<u>Rezoning</u> – The existing parcel at 2727 South State Street has a split zoning of O (Office District) and M1 (Limited Light Industrial). The petitioner proposes rezoning the M1 portion to O so that the entire site including both the full remaining portion of 2727 South State Street and the new parcel for the financial institution will be zoned O. The proposed Office zoning was requested by city staff to stay consistent with the surrounding zoning and existing uses and is supported by the <u>South State Street Corridor Plan</u>.

<u>Site Plan and Special Exception Use</u> – The petitioner proposes to construct a single-story financial building containing 5,004-square feet with a four lane drive-thru facility. Total estimated cost of project is \$1,250,000 and to be constructed in one phase.

The four-lane drive-thru will be accessed from the existing driveway off S. State Street and will be screened to the west by the proposed building. No new curb cuts are proposed in the right-of-way for the financial institution development. Vehicles will circulate through the drive-thru lanes by entering off the existing drive, heading south and looping in a clockwise direction before exiting the site.

A total of 26 parking spaces are proposed for the financial institution use. Cross access and parking easements are required as part of this proposal. Four Class C bicycle spaces are located near the north building entrance. A sidewalk link leading from the public sidewalk fronting S. State St. to the existing office building entrance located at the eastern rear of the site is proposed with a combination of striped cross walks and a sidewalk located inside a landscape island.

There are shared existing storm water facilities for 2723 and 2727 South State Street and 777 East Eisenhower Boulevard, located at the rear of these developments. The shared storm water facilities are under the jurisdiction of the Washtenaw County Water Resources Commissioner (WCWRC). Based on the total of impervious surface on the site, the petitioner is required to provide first flush, bankfull and 100-year storm detention capacity. The WCWRC has reviewed and approved the proposed minor upgrades to the existing shared system. In addition, a depressed landscape island with a bioswale is proposed on site to meet City requirements. No landmark trees or natural features are located on site.

<u>Street Vacation</u> - The petitioner requests the City vacate a 50-foot wide easement for future right-of-way across 2727 South State Street, a 230-foot length. In the past, 50-foot wide easements for future right-of-way were obtained from 2727 South State as well as other parcels along South State Street. These easements are not contiguous and the City has no plans to obtain similar easements from other parcels or use the existing ones. This proposed vacation will allow the front lot line of the proposed financial institution parcel to be aligned with the adjacent parcels to the north and south.

Landscape Modification – The proposed land division and land transfer requires the site plan for South State Commons I (2723 S. State St.) and South State Commons III (2727 S. State St.) be administratively amended. A request for modification of the requirements of Chapter 62 (Landscape and Screening Ordinance) is needed because those site plans and the existing conditions on the sites do not meet the current requirements of Chapter 62. Current requirements include 1) at least 50% of the interior landscape area must be depressed bioretention areas and utilized for storm water management; and 2) there be no more than 15 contiguous parking spaces in a row without a landscape island break. None of the existing interior landscape islands are depressed and there are several rows of parking spaces in excess of 15 spaces. The petitioner seeks to have these two landscaping requirements be waived.

A post card was sent to neighbors within 500 feet of 2727 South State Street notifying them of this project. At the time this staff report was written, the petitioner and the City have not received any comments or concerns from the public regarding this proposal.

	EXISTING	PROPOSED (NEW SITE)	REQUIRED/PERMITTED
Zoning	O & M1 (Office & Limited Industrial District)	0	0
Gross Lot Area	169,884 sq ft	34,846 sq ft	6,000 sq ft MIN
Floor Area in Percentage of Lot Area	40,912 sq ft 24.1%	5,004 sq ft 14%	26,135 sq ft 75% MAX
Setback – Front	350 ft	15 ft	15 ft MIN 40 ft MAX
Setback - Side	30 ft	45 ft	None
Setback – Rear	5 ft	95 ft	None
Height	2 story	1 story 24 ft	4 stories MAX 55 ft MAX
Parking – Automobile	190 spaces	25 spaces	23 spaces MIN
Parking – Bicycle	4 spaces – Class A 28 spaces – Class C	4 spaces-Class C	2 spaces MIN – 2 Class C

### **COMPARISON CHART**

### SURROUNDING LAND USES AND ZONING

	LAND USE	ZONING
NORTH	Bank & Offices	O (Office District)
EAST	Mixed Uses & School	ORL & M1(Limited Industrial District)
SOUTH	Offices	O (Office District)
WEST	Apartment & Offices	R4C (Multiple-Family Dwelling District), PUD (Planned Unit Development) & M1

### SPECIAL EXCEPTION USE STANDARDS

<u>General Standards</u> - The Planning Commission, in arriving at its decision relative to any application for a special exception, shall apply the following standards (petitioner's response in regular type, staff's comments in *italic type*):

(a) The proposed use or uses shall be of such location, size and character as to be compatible with the appropriate and orderly development of the zoning district and adjacent zoning districts in which the site is situated. In applying this standard, the Planning Commission shall consider whether the proposed use:

### 1. Will be consistent with the general objectives of the City Master Plan;

Financial institutions are permitted principal uses in the O (Office) Zoning District.

The <u>Land Use Element</u> recommends office uses for this site. The O zoning allows bank drive-ins as a special exception use.

# 2. Will be designed, constructed, operated, and maintained in a manner that is compatible with the existing and planned character of the general vicinity;

The drive-thru lanes will be completely blocked from view from State St by the building.

The existing use for this site is office use and the proposed financial use and drive-thru use fit with the existing and surrounding office and bank uses.

The proposed drive thru lane will be located behind the financial center and adhere to the newly adopted drive-thru requirements in the O district.

# 3. Will be consistent with the general character of the neighborhood considering population density, design, scale and bulk; and the intensity and character of activity;

The drive-thru lanes and stacking will not be visible from State St. The surrounding uses which may see them are office uses to the north, south and east.

This project is consistent with the surrounding area in that this proposal is similar in use to other office uses and drive-thrus in the area.

# 4. Will not be detrimental to the use, peaceful enjoyment, economic value or development of neighboring property, or the neighborhood area in general;

The use is consistent with the neighboring properties and the drive-thru lanes are not obtrusive or detrimental to them. There is another financial institution with drive thru lanes existing to the north of this proposed project.

Neighbors were notified by the petitioner of the proposed project and no objections have been received at the time this report was written.

### 5. Will not have a detrimental effect on the natural environment.

The existing condition of the site is a parking lot. The drive-thru lanes will not have any additional detriment to the natural environment.

The proposed project will not have any effect on the environment other than improving storm water quality and quantity. There are no natural features on site.

- (b) The location and size of the proposed use or uses, the nature and intensity of the principal use and all accessory uses, the site layout and its relation to streets giving access to it, shall be such that traffic to and from the use or uses, the assembly of persons in connection therewith, and the effect of the proposed use on public services and facilities, will not be hazardous or inconvenient to the neighborhood nor unduly conflict with the normal traffic of the neighborhood. In applying this standard the Planning Commission shall consider, at minimum:
  - 1. The location of and access to off-street parking and the safe provisions for pedestrian traffic;

Off-street parking is accessed via an existing curb cut. Pedestrian traffic will be able to access the building via a proposed sidewalk to the State Street sidewalk.

New on site sidewalks will meet ADA requirements and connect to the public sidewalk. Offstreet parking is located on site.

# 2. The relationship of the proposed use to main traffic thoroughfares and to streets and road intersections;

The drive- thru lanes will be accessed via a drive behind the proposed building which is accessed via an existing driveway.

This relationship will remain largely unchanged.

### 3. Vehicular turning movements in relationship to traffic flow routes;

Vehicular turning movements are all on the interior of the parking lot.

This proposal uses one existing curb cut. No additional curb cuts are proposed.

4. The intensity and character of traffic and parking conditions on the site, and in the general area;

The proposed financial institution will have sufficient parking on its site.

The Traffic Impact Statement states the proposed 5,000 sq. ft financial institution will have a minimal delay with the exception of vehicles exiting the site making a southbound, left hand turn.

5. The requirements for additional public services and facilities which will be created by the proposed use will not be detrimental to the social and economic welfare of the community.

The proposed financial institution will not have any undue requirements nor will it be detrimental to the social and economic welfare of the community.

This site will not require sanitary sewer mitigation. The existing office building is presently using city utilities.

(c) The standards of density and required open spaces for the proposed use shall be at least equal to those required by Chapter 55 in the zoning district in which the proposed use is to be located, unless a variance is granted.

NA

### HISTORY

The existing development was identified as Building B of the 777 Office Campus Area Plan on January 4, 1988. At the same time, the Building B Site Plan was approved. It was built during 1988 and 1989, and 2727 South State Street has been used as an office building since that time. In February 1989, an administrative lot division was approved to revise existing lot lines to provide each building in the office campus its own building site. In June 1989, an administrative amendment was approved for this site for minor revisions to the parking lot, landscaping, utilities and entry drive. In 1996, a Site Plan for Minor Modifications was approved to reconfigure the parking lot and increase the total number of parking spaces from 160 to 190.

### PLANNING BACKGROUND

The <u>Master Plan: Land Use Element</u> recommends office, research and industrial uses for this site. The <u>South State Street Corridor Plan</u> recommends office and residential uses for this site. New buildings should be fronted along South State Street to encourage non-motorized and transit access. As parcels in this area are redeveloped, the O zoning is most appropriate zoning to support the future residential/office mix.

Phase II of the <u>Connector Feasibility Study</u> is currently determining if the South State Street Corridor should be part of the high capacity transportation service connecting the south part of the city with Downtown, Central Campus and Plymouth Road activity centers. Higher density, mixed-use land uses have been shown to better support transit compared to low density, singleland uses. The <u>Non-Motorized Plan</u> recommends bicycle lanes and sidewalks on both sides of the street for South State Street. These currently exist on both sides of the street.

### **STAFF COMMENTS**

<u>Traffic</u> – Staff agrees with the conclusions of the traffic report for this site. The proposed drivethru financial institution generates little to no traffic volume in the AM peak hours. Approximately 224 customer trips during the afternoon peak hour are anticipated. About half of these customers will primarily be traffic that is already driving by the site. The amount of anticipated new traffic is not expected to cause traffic back-ups and will not have a significant impact on the traffic flow along South State Street or Oakbrook Drive.

<u>Project Management</u> – No footing drain mitigation for the proposed building is necessary. The city has recently revised City Code language requiring payment of improvement charges for a property's initial sanitary sewer service and water service connections (i.e., for vacant parcels). These improvement charges will be due at the time the utility services become active (i.e., when the water meter is set in the building).

Staff has no comments on the request to vacate the easement for future right-of-way.

<u>Systems Planning – Storm Water</u> – The Washtenaw County Water Resources Commissioner has approved the improvements to the existing shared storm water management system.

<u>Planning</u> – Staff supports the proposed vacation of the 50-foot wide easement for future right-ofway across 2727 South State Street. Traffic Engineering evaluated this location and its position relative to a future boulevard and determined it was farther north than the potential boulevard would expect to be constructed. Since the building pattern is also largely fixed to the north and it's unlikely the City is able to fill in the gaps between the future right-of-way easements on the east side of S. State, vacating the easement across 2727 brings this site into alignment with the existing front lot lines on either side of this parcel.

The <u>Master Plan: Land Use Element</u> recommends office uses for this site with strong pedestrian connections. The petitioner has designed the site with pedestrian connections off State Street and interior to the site leading to the existing eastern office building.

The drive-thru lane now requires special exception use approval in the O district and meets the recently passed drive-thru amendments. The drive-thru facility is not located between S. State Street and the principal building and the vehicular circulation to enter and exit the facility does not impair the general circulation on site or with pedestrian circulation on or off the site. Although the drive-thru financial facility is expected to increase daily traffic to this site, most of this traffic is existing drive-by trips during the morning and afternoon hours with the Level of Service remaining the same. The proposed drive-thru facility also meets the Chapter 59 (Off-Street Parking) standards for drive-thrus.

The Planning Commission has the authority to approve a modification to allow landscape elements which are part of a previously approved site plan to be maintained and continued as nonconforming provided no alterations of the existing landscape elements are proposed. The petitioners are requesting a modification to allow all existing landscape islands to remain as MAVD Financial Institution Page 9


previously approved. With approval of the modification request, staff may be able to approve the administrative amendments under review. Staff supports the landscape modifications as they are consistent with the intent of the ordinance and are associated with a previously approved site plan.


Prepared by Chris Cheng Reviewed by Alexis DiLeo mg/8/29/14

- Attachments: Zoning/Parcel Maps Aerial Photo Site Plan Easement Survey Landscape Plan Elevations Application for Landscape Modification
- c: Petitioner/Owner: MAV Development 2723 S. State Street Ann Arbor, MI 48104

Petitioner's Representative: Robert Wanty, PE Washtenaw Engineering Company 3526 W. Liberty Rd., Suite 400 Ann Arbor, MI 48103

Project Management Systems Planning File No. SP14-034 Z14-022 SEU14-012 SV14-003 SP14-032

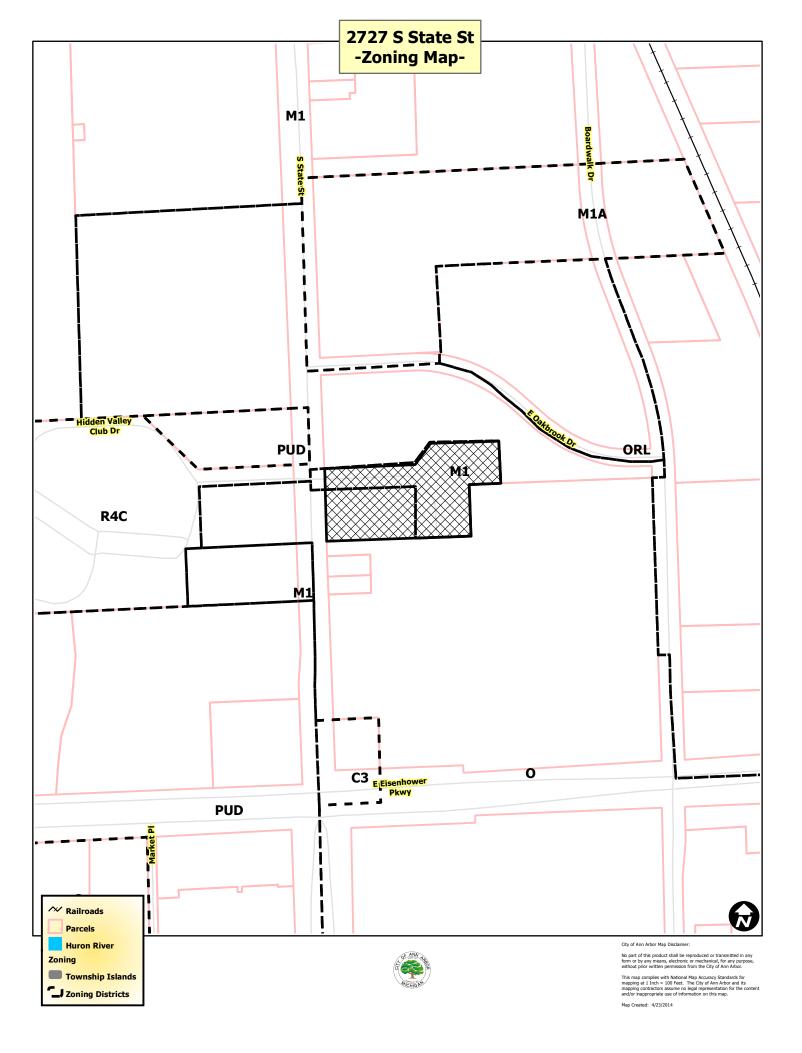

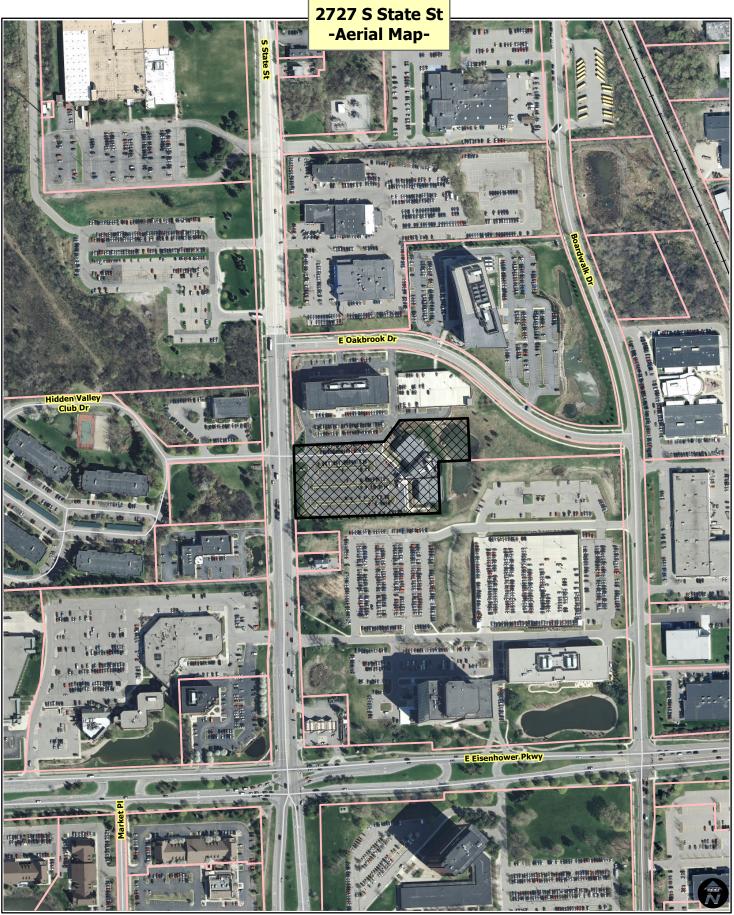

Railroads
 Parcels
 Huron River



City of Ann Arbor Map Disclaime

No part of this product shall be reproduced or transmitted in any form or by any means, electronic or mechanical, for any purpose, without prior written permission from the City of Ann Arbor.

This map complies with National Map Accuracy Standards for mapping at 1 Inch = 100 Feet. The City of Ann Arbor and Its mapping contractors assume no legal representation for the content and/or nappropriate use of information on this map. Map Created: 4/23/2014




Railroads
Parcels
Huron River



City of Ann Arbor Map Disclai

No part of this product shall be reproduced or transmitted in any form or by any means, electronic or mechanical, for any purpose, without prior written permission from the City of Ann Arbor.

This map complies with National Map Accuracy Standards for mapping at 1 Inch = 100 Feet. The City of Ann Arbor and its mapping contractors assume no legal representation for the content and/or nappropriate use of information on this map. Map Created: 4/23/2014

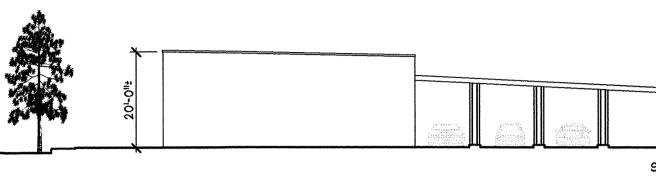

٠

F



G

٠

	ZONING CHART	
ZONING CLASSIFICATIONS	OFFICE	
LOT AREA	.8 ACRES	
FLOOR AREA (FAR) AND/OR # OF DWELLING UNITS	GROSS BUILDING AREA / GROSS PROPERTY AREA = FAR	5004 SF / 34864 SF = .14
OPEN SPACE AND ACTIVE OPEN SPACE	N/A	
SETBACKS - FRONT, SIDE AND REAR	15'-O" MINIMUM	40'-0" MAXIMUM
HEIGHT	24 <sup>1</sup> -0 <sup>11</sup>	55'-0" MAXIMUM
OFF-STREET PARKING, INCLUDING ACCESSIBLE AND BARRIER FREE	25 PARKING SPACES PROVIDED	23 PARKING SPACES REQUIRED
BICYCLE PARKING, INCLUDING CLASS	4 PROVIDED (2 REQUIRED)	CLASS C

# SIDEWALK MAINTENANCE:

G

٠

ALL SIDEWALKS WITHIN THE CITY SHALL BE KEPT AND MAINTAINED IN GOOD REPAIR BY THE OWNER OF THE LAND ADJACENT TO AND ABUTTING UPON THE SAME, AND IF ANY OWNER SHALL NEGLECT TO KEEP AND MAINTAIN THE SIDEWALK ALONG THE FRONT, REAR, SIDE OF THE LAND OWNED BY HER OR HIM IN GOOD REPAIR AND SAFE FOR THE USE OF THE PUBLIC, THE SAID OWNER SHALL BE LIABLE TO THE CITY FOR ANY DAMAGES RECOVERED AGAINST THE CITY SUSTAINED BY ANY PERSON BY REASON OF SAID SIDEWALK BEING UNSAFE AND OUT OF REPAIR. IF THE PUBLIS SERVICES AREA ADMINISTRATOR DETERMINES THAT THE CONDITION OF A SIDEWALK FAILS TO MAKE THE REPAIRS AFTER NOTICE FROM THE CITY, THE CITY MAY PROCEED TO REPAIR THE SAME AND THE COST OF SUCH REPAIRS SHALL BE CHARGED AGAINST THE LAND WHICH SAID SIDEWALK ADJOINS AND THE OWNER OF SAID LAND, AND SHALL BE COLLECTED AS A SIGNLE LOT ASSESSMENT AS PROVIED IN SECTION 1:292 OF THIS CODE. AS USED IN THIS SUBSECTION (A), "SIDEWALK" DOES NOT INCLUDE CURB RAMPS OR ANY SIDEWLAK FLAG THAT IS BOTH ADJACENT TO THE TOP EDGE OF 1 OR MORE CURB RAMPS AND AT THE CORNER OF A PROPERTY.

F

•

٠

Ε

D

•

Н

٠

٠


3

٠

2

Н


٠

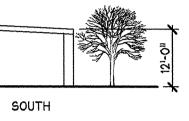

Ε

٠

•

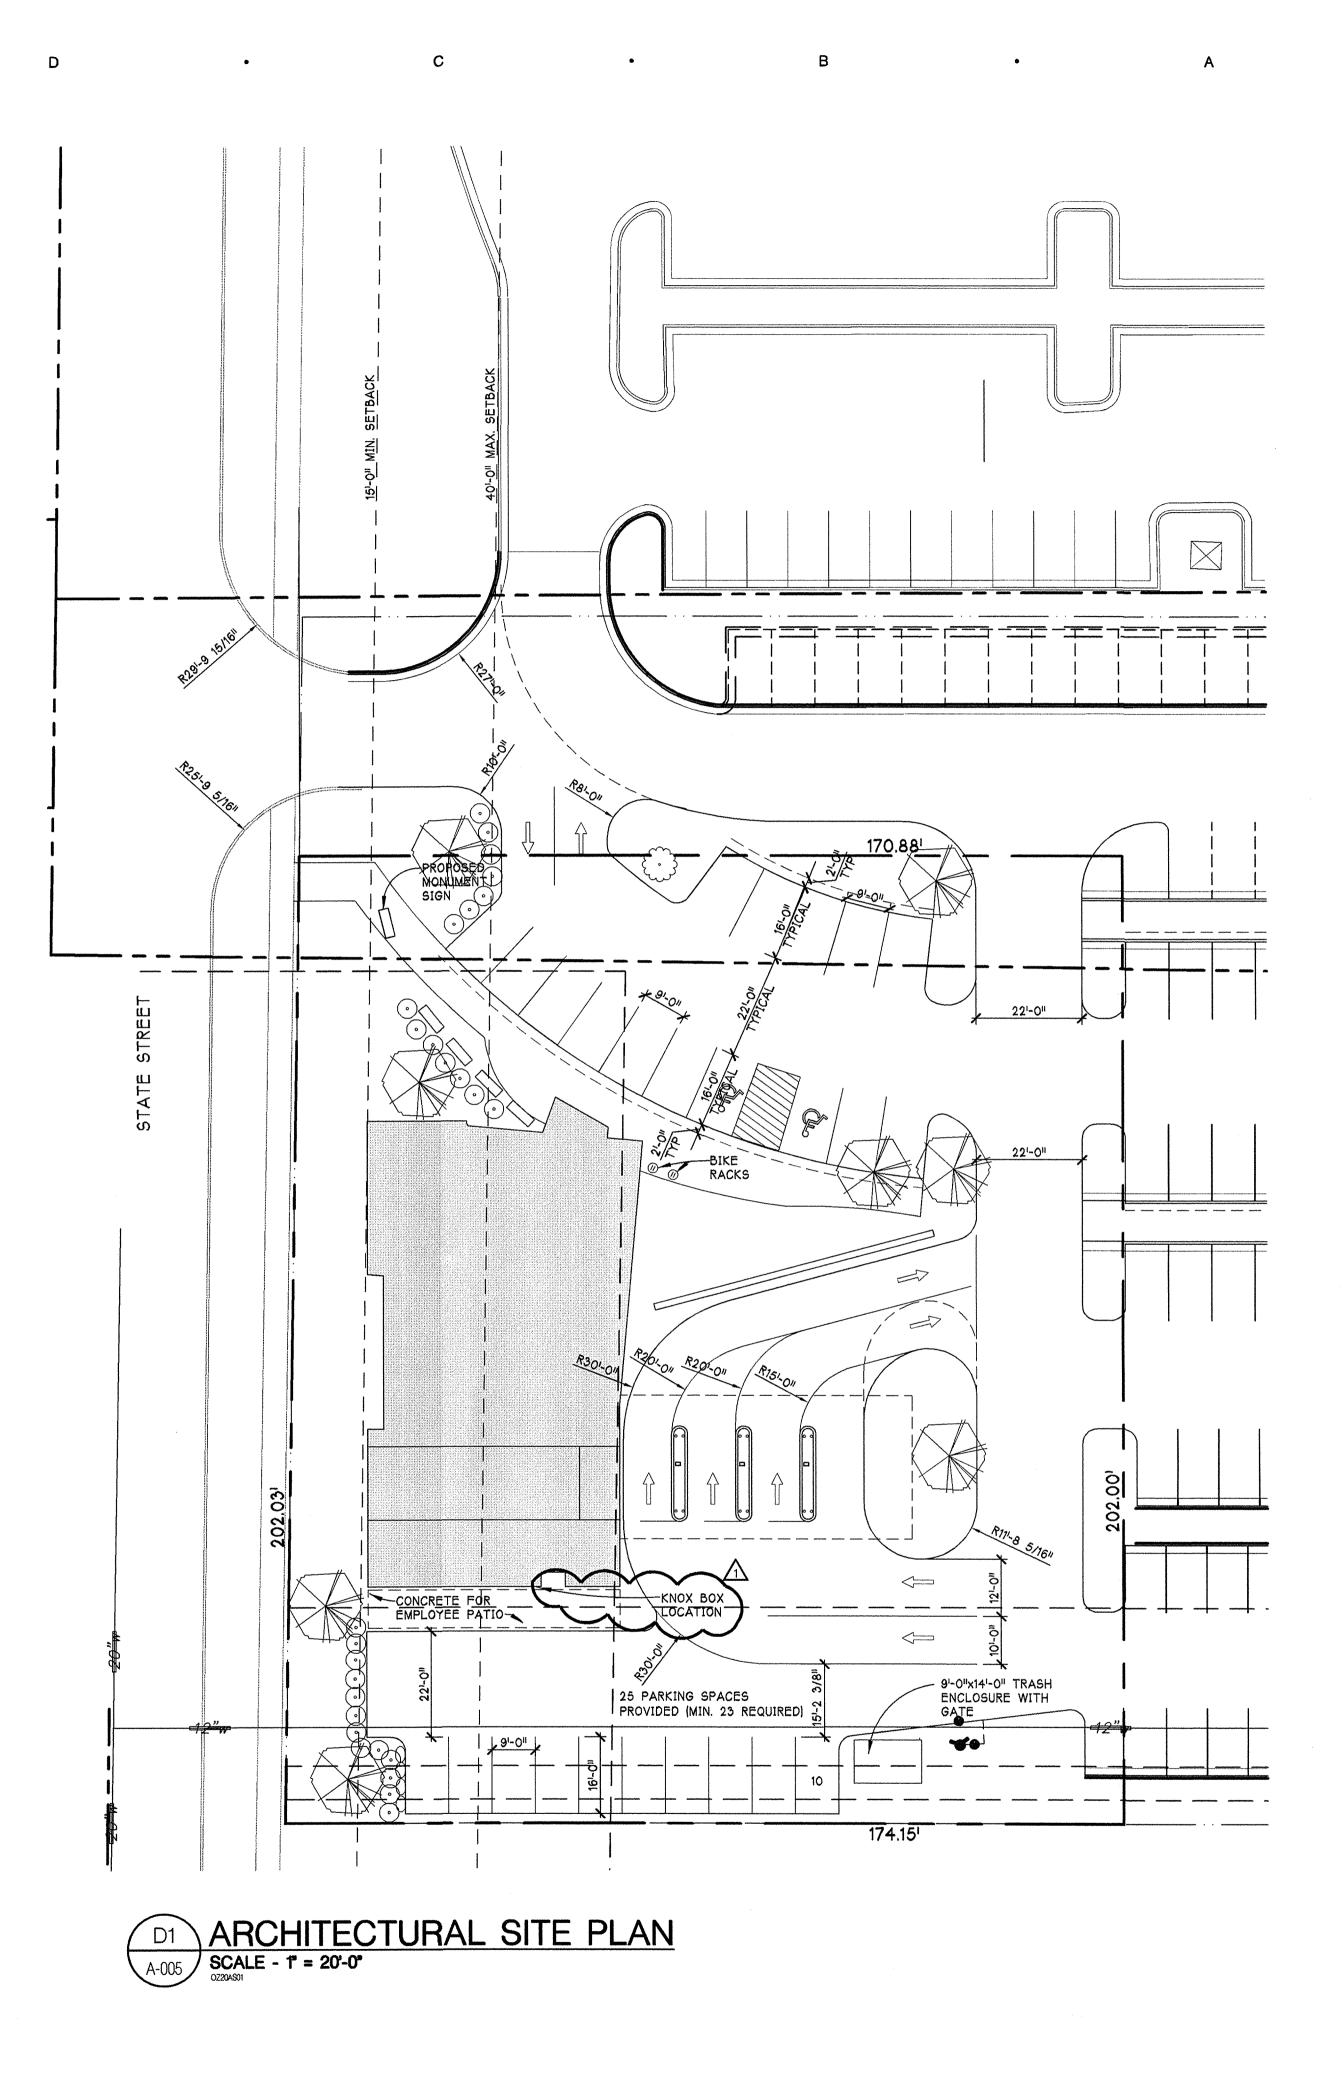

SITE PLAN 8/08 SITE PLAN 8/08 SITE PLAN APPROVAL 6/30 SITE PLAN REVIEW SET 6/25 SITE PLAN PRE-APPLICATION 4/23 DATE ISSUE DRAWN B CHECKED I CHECKED I	
SITE PLAN APPROVAL 6/30 SITE PLAN REVIEW SET 6/25 SITE PLAN PRE-APPLICATION 4/23 DATE ISSUE DRAWN E CHECKED E CHECKED E CHECKED E CHECKED E CHECKED E CHECKED E	
SITE PLAN APPROVAL 6/30 SITE PLAN REVIEW SET 6/25 SITE PLAN PRE-APPLICATION 4/23 DATE ISSUE DRAWN E CHECKED E CHECKED E LLLL BARDESSEE	
SITE PLAN APPROVAL 6/30 SITE PLAN REVIEW SET 6/25 SITE PLAN PRE-APPLICATION 4/23 DATE ISSUE DRAWN E CHECKED E CHECKED E LLLL BARDESSEE	
SITE PLAN APPROVAL 6/30 SITE PLAN REVIEW SET 6/25 SITE PLAN PRE-APPLICATION 4/23 DATE ISSUE DRAWN E CHECKED E CHECKED E LLLL BARDESSEE	
SITE PLAN APPROVAL 6/30 SITE PLAN REVIEW SET 6/25 SITE PLAN PRE-APPLICATION 4/23 DATE ISSUE DRAWN E CHECKED E CHECKED E LLLLL LANDERSEE CHECKED E	
SITE PLAN APPROVAL 6/30 SITE PLAN REVIEW SET 6/25 SITE PLAN PRE-APPLICATION 4/23 DATE ISSUE DRAWN E CHECKED E CHECKED E LLLL BARDESSEE	
CHECKED	5/14 5/14 5/14 ED
	<b>В</b> А
	t
<b>TAR BBB</b> <b>A R BBB</b> 100 N. State St. Ann Arbor, MI 48104 P.734.663.4189	www.nopps-plack.com
	Ann Arbor, IVII 40104
CONSULTA ARCHITECTURA SITE PLAN	<u></u>
SHEET TI	ΓLE
PROJECT NUME	

Sheet Size - 24x36

6

٠

5

٠

4

3

2

•

1

-----

© Copyright 2012 Hobbs+Black Associates, Inc. ALL RIGHTS RESERVED

В


٠


Α

•

С


٠

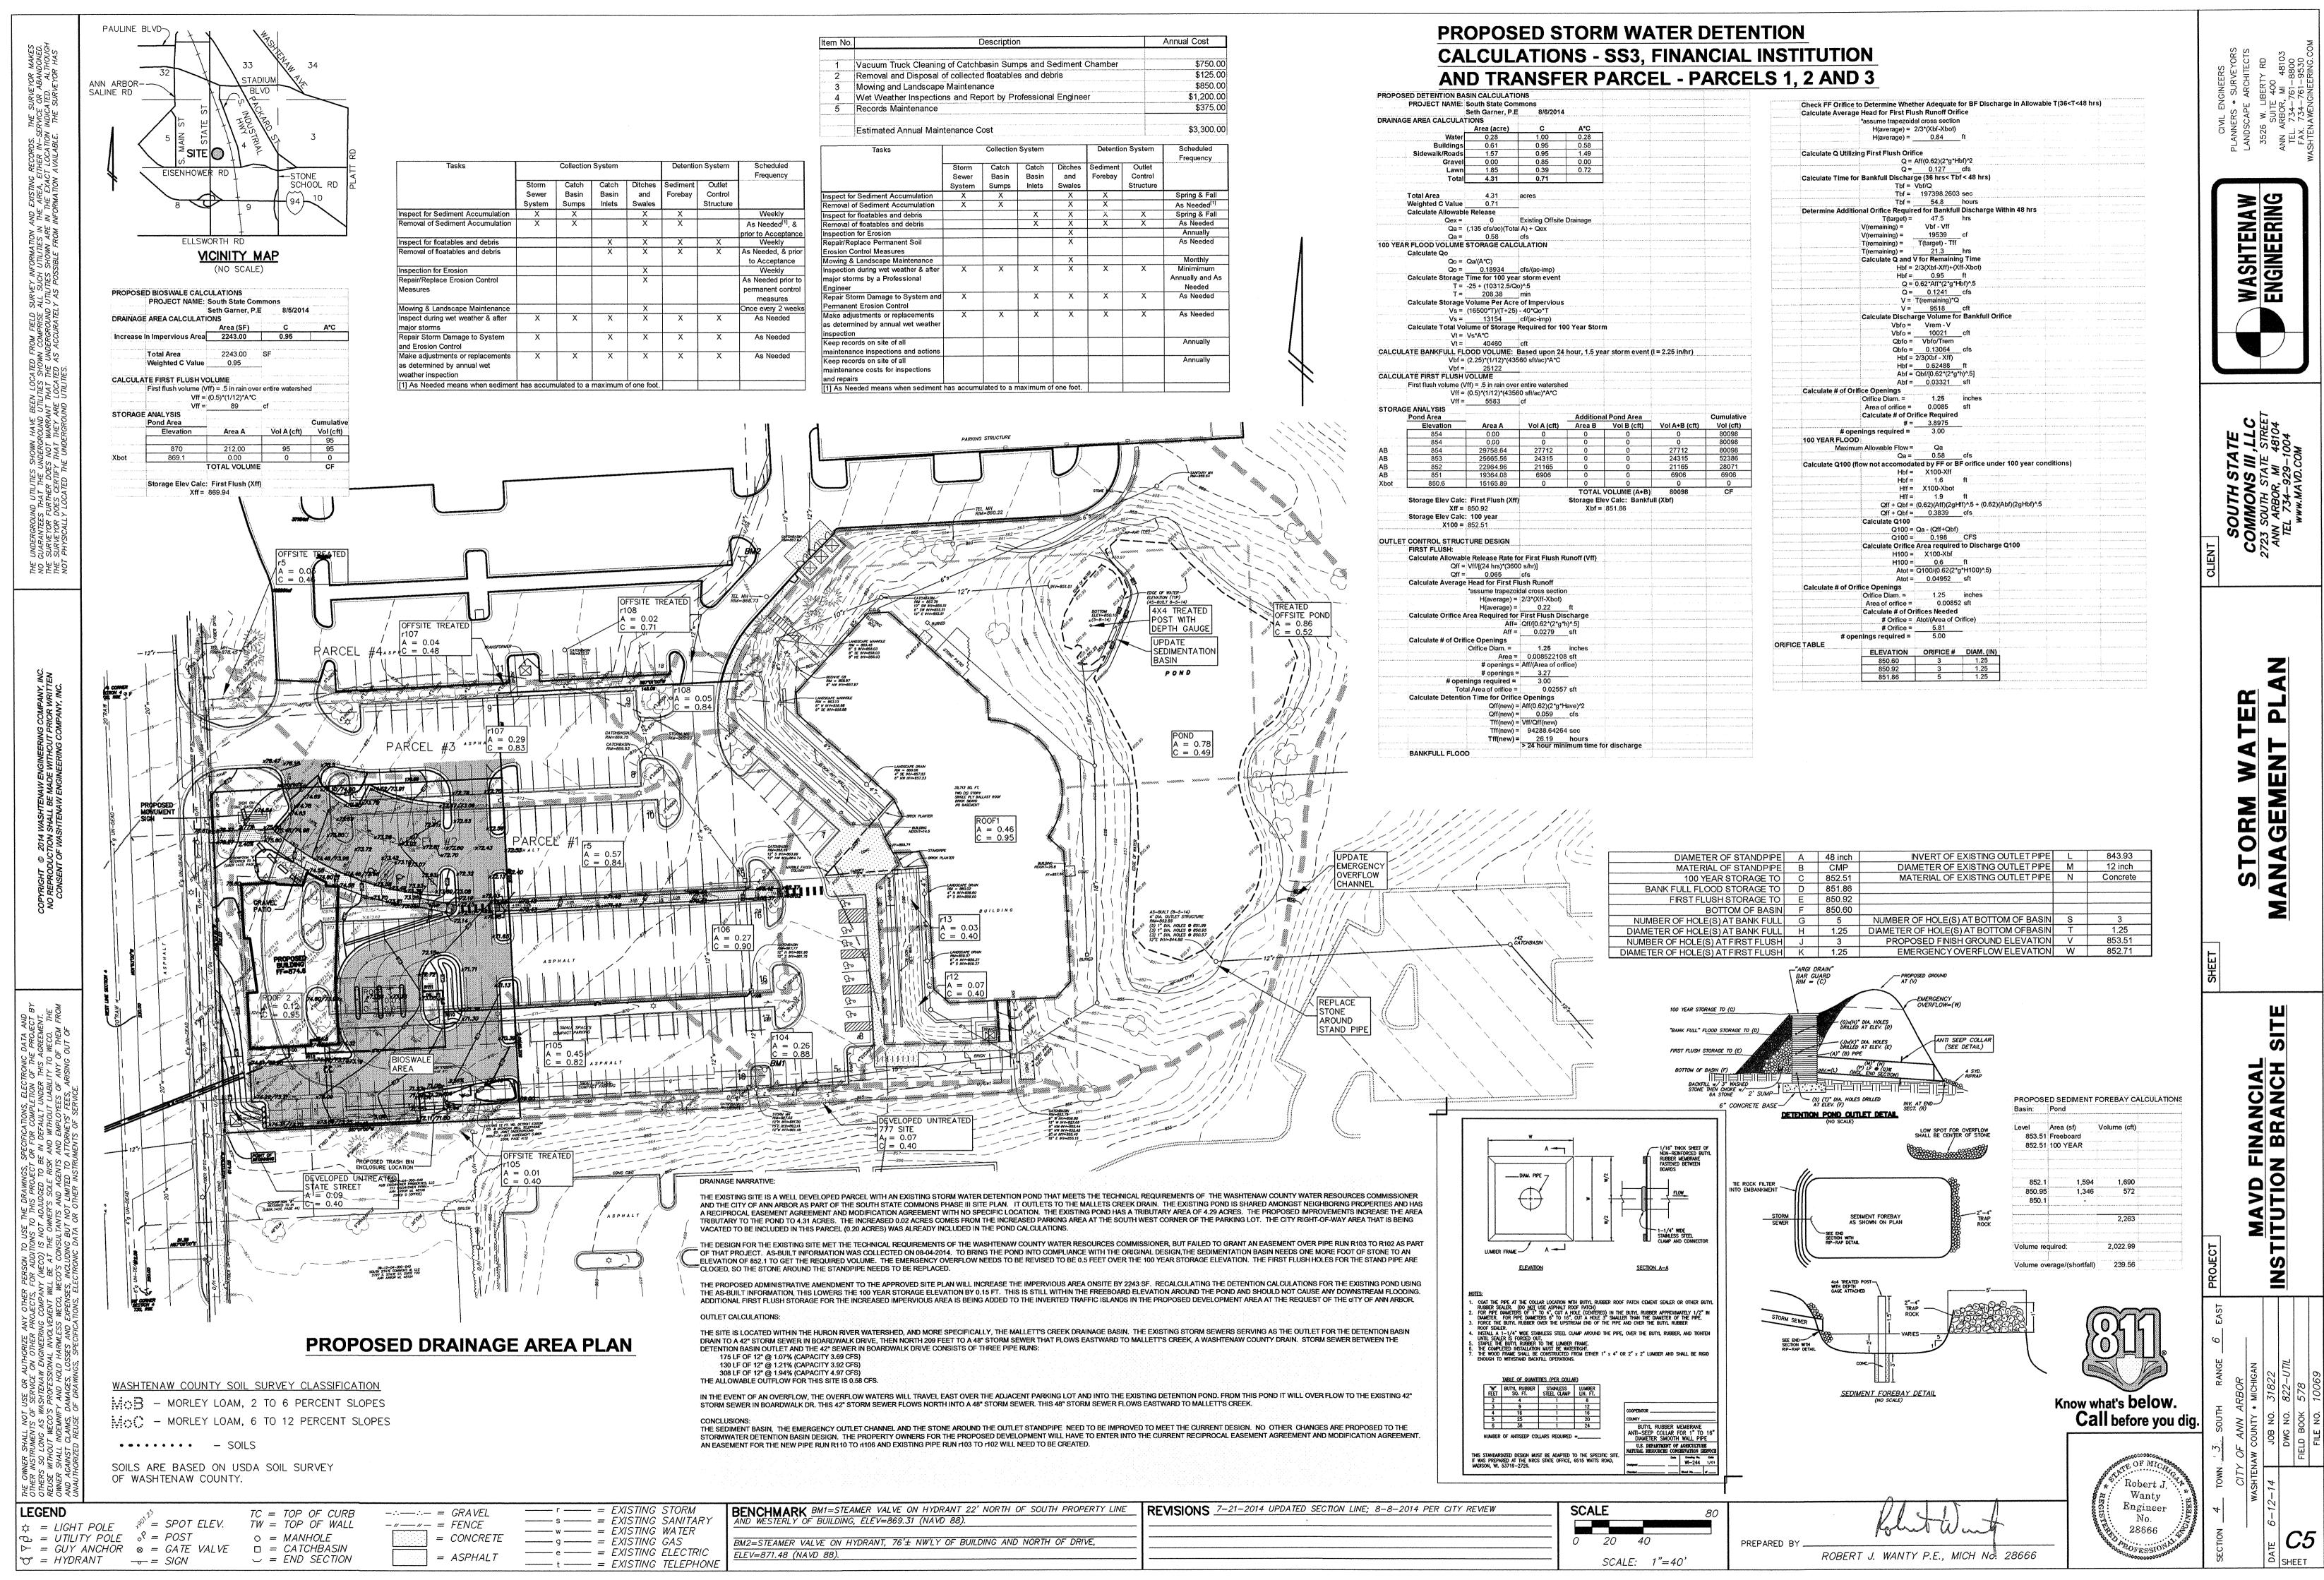


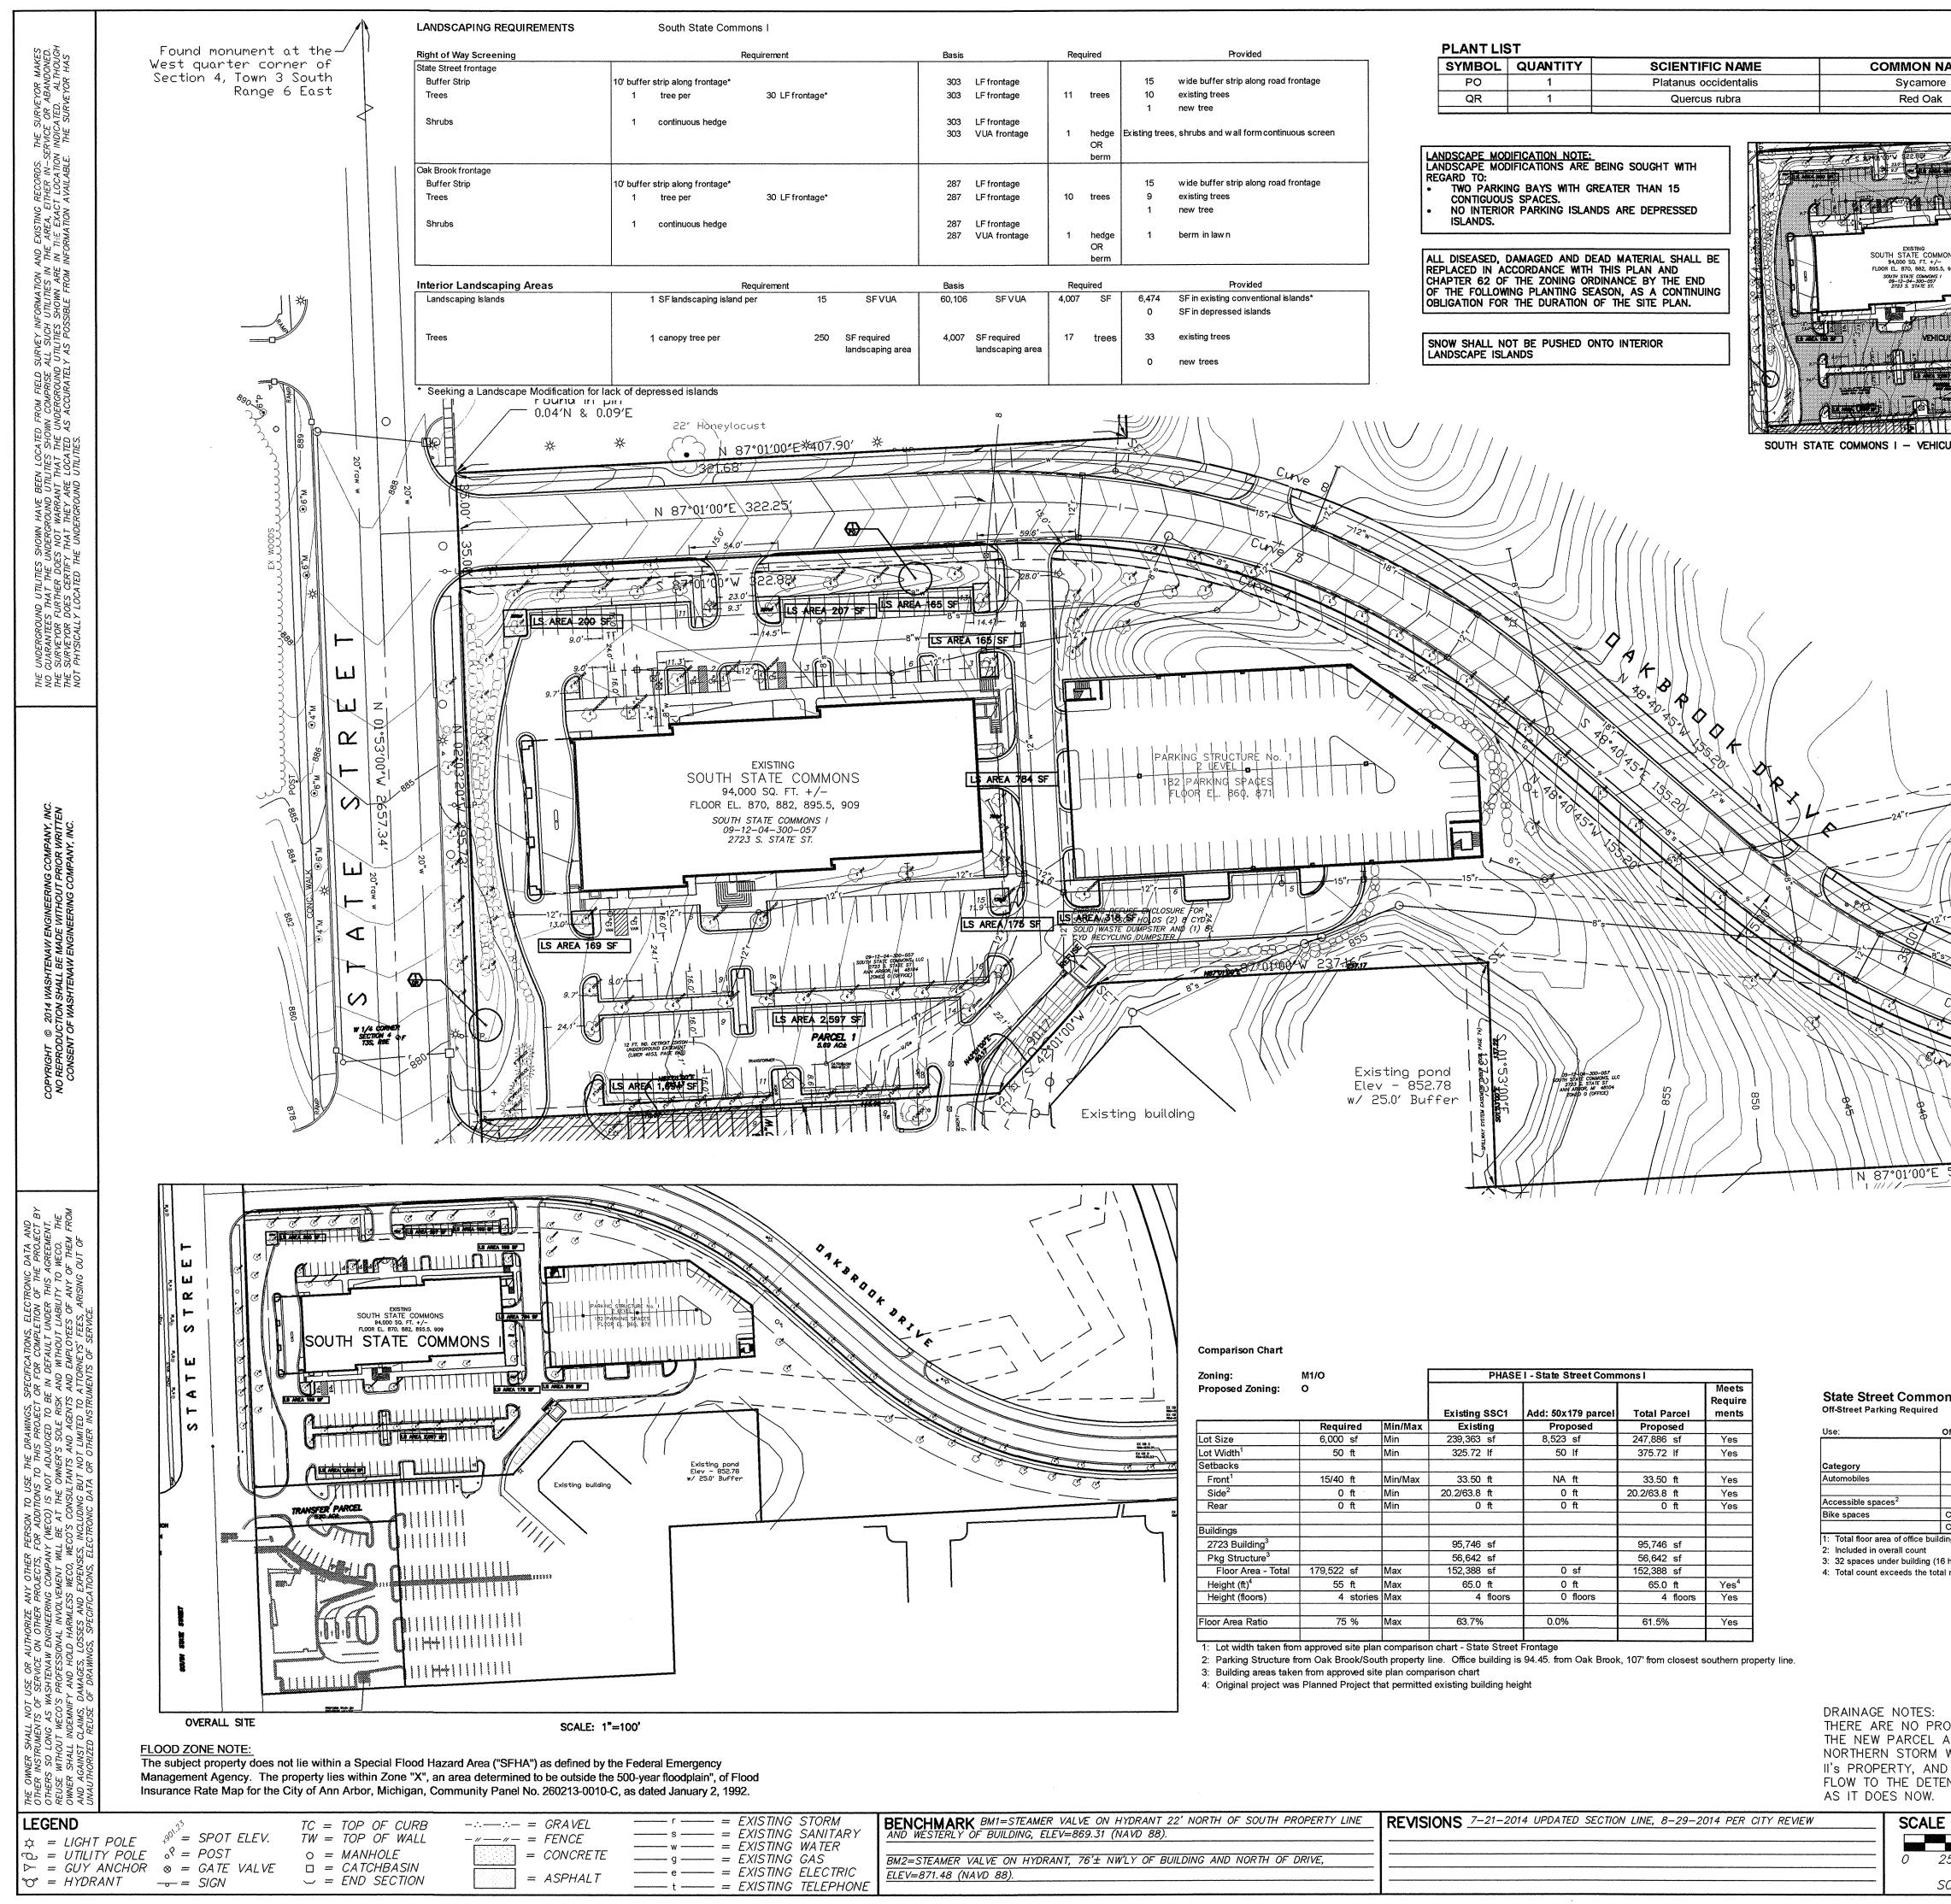


	M1/O		r		DUACE	EI-State S	tract Come	nonal	•••••••	
ıg: osed Zoning:	0			Existing			179 parcel	Total Pa	arcel	Me Req me
	Requi	red	Min/Max	Existi	ng	Prop	osed	Propo	sed	1
ze	6,000	sf	Min	239,363	sf	8,523	sf	247,886	sf	Ye
/idth <sup>1</sup>	50	ft	Min	325.72	lf	50	lf	375.72	lf	Ye
icks										
nt <sup>1</sup>	15/40	ft	Min/Max	33.50	ft	NA	ft	33.50	ft	Ye
nt <sup>1</sup> e <sup>2</sup>	0	ft	Min	20.2/63.8	ft	0	ft	20.2/63.8	ft	Ye
ar	0	ft	Min	0	ft	0	ft	0	ft	Ye
ngs										
3 Building <sup>3</sup>				95,746	sf			95,746	sf	
g Structure <sup>3</sup>				56,642	sf			56,642	sf	
loor Area - Total	179,522	sf	Max	152,388	sf	0	sf	152,388	sf	1
ght (ft)⁴	55	ft	Max	65.0	ft	0	ft	65.0	ft	Ye
ght (floors)	4	stories	Max	4	floors	0	floors	4	floors	Y
Area Ratio	75	%	Max	63.7%	)	0.0%		61.5%		Y


Basis     Required     Provided       303     LF frontage     11     trees     15     wide buffer strip along road frontage       303     LF frontage     11     trees     10     existing trees       303     LF frontage     1     hedge     1     new tree       303     LF frontage     1     hedge     Existing trees, shrubs and wall form continuous screen       303     VUA frontage     1     hedge     Derm       303     VUA frontage     10     trees     9       287     LF frontage     10     trees     9       287     LF frontage     10     trees     1       287     LF frontage     1     hedge     0       287     LF frontage     1     hedge     0       287     LF frontage     1     hedge     1       287     VUA frontage     1     hedge     1       0     Required     Provided       60,106     SF VUA     4,007     SF     6,474       4,007     SF required     17     trees     33       1     new trees     0     new trees       0     new trees     0     new trees	SNOW SHALL NOT BE PUSHED ON TO INTERIOR	COMMON NAME       MIN SIZE         Sycamore       2.5       Inches       Cal.         Red Oak       2.5       Inches       Cal.         Image: State Sta	COMMENTSB & BB &	tate Street Frontage \$1.30 per LF frontage 333 LF 9 trees 405 LF -72 LF \$0.00 CALCULATIONS ak Brook Frontage \$1.30 per LF frontage \$1.30 per LF frontage \$1.30 per LF frontage 1168 LF
Subject of the second s				CLIENT CLIENT RAV DEVELOPMENT 2723 S. STATE ST., SUITE 250 ANN ARBOR, MI 48104 TEL 734-929-1004 WWW.mavd.com
PARKING STRUCTURE No. 1 PARKING STRUCTURE No. 1 PARKING SPACES FLOOR EL BOO. \$711 PARKING SPACES PLOOR EL BOO. \$711 PLOOR EL BOO. \$7110 PLOOR EL BOO. \$7100 PLOOR EL BOO. \$7100 P	ting pond - 852.78 50' Buffer	N 87°01′00′E 523.63′	$   \begin{array}{c}             F_{N,0} \\             $	SITE PLAN FOR ADMINISTRATIVE 320.42
Image: Second	Max       63.7%       0.0%       61.5%       Yes         comparison chart - State Street Frontage         h property line.       Office building is 94.45. from Oak Brook, 107' from closest southern property line.         plan comparison chart	State Street Commons I         Off-Street Parking Required         Use:       Office - Business Professional         Category       Requirement         Automobiles       Min       1 space per       33 sf floor area         Accessible spaces <sup>2</sup> Per ADA table         Bike spaces       Class A       0.3 space per       3,000 sf floor area         1:       Total floor area of office building         2:       Included in overall count         3:       32 spaces under building (16 hoops) in well-lit area         4:       Total count exceeds the total number of bike spaces, with most a better-protect	BasisRequiredProvided³% of totalRequired95,476 sf¹287 spaces354 spaces - full sized100.0%Y95,476 sf382 spaces0 spaces - small car0.0%Y354 spaces8 spaces8 accessible spacesY95,476 sf10 spaces32 Class A bike spacesY95,476 sf23 spaces4 Class C bike spaces³Y	ent     es       es     es       es     es       es     es       es     es       es     es       nucleon     es       RBOR     PROJECT       AL     SOUTH       S1822     AL-SSI-SITE       S28     S22-AA-SSI-SITE
	REVISIONS 7-21-2014 UPDATED SECTION LINE, 8-29-2014 PER CITY REVIEW	DRAINAGE NOTES: THERE ARE NO PROPOSED DRAINAGE CHANGES T THE NEW PARCEL ADDED TO THE SITE CONTINUE NORTHERN STORM WATER DETENTION POND ON S II'S PROPERTY, AND THE NEW PROPERTY ADDITION FLOW TO THE DETENTION POND EAST OF THE BU AS IT DOES NOW. W     	TO FLOW TO THE TATE STREET COMMON N WILL CONTINUE TO ILDING ON PARCEL 1, BOUNDARY & TOPOGRAPHICAL INFORMATION PROVIDED BY OTH	ERS. Call before you dig. NON SOC OF MICH OF

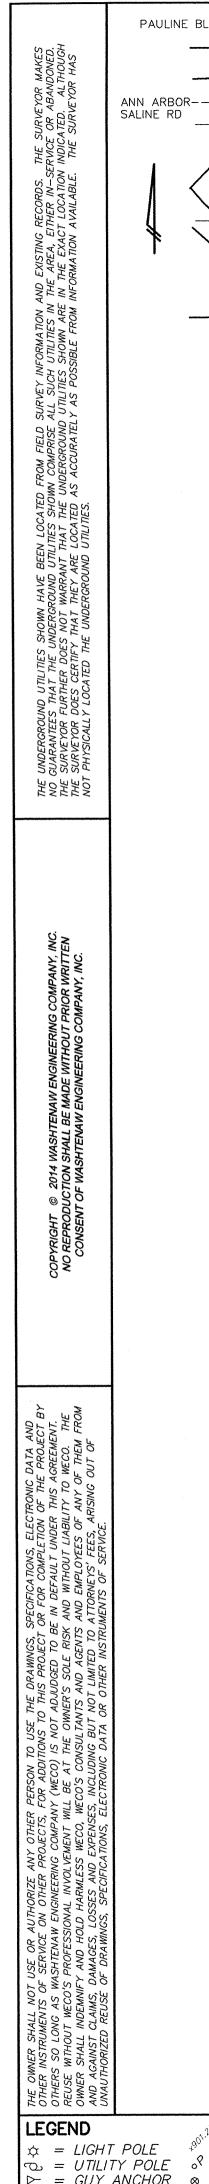

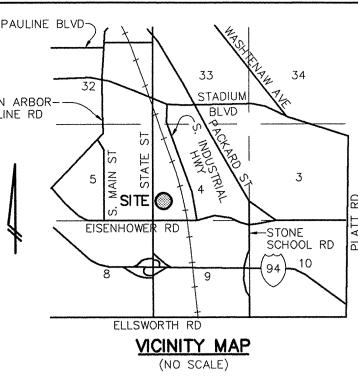

# LEGAL DESCRIPTIONS ON COVER SHEET

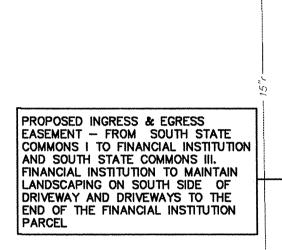

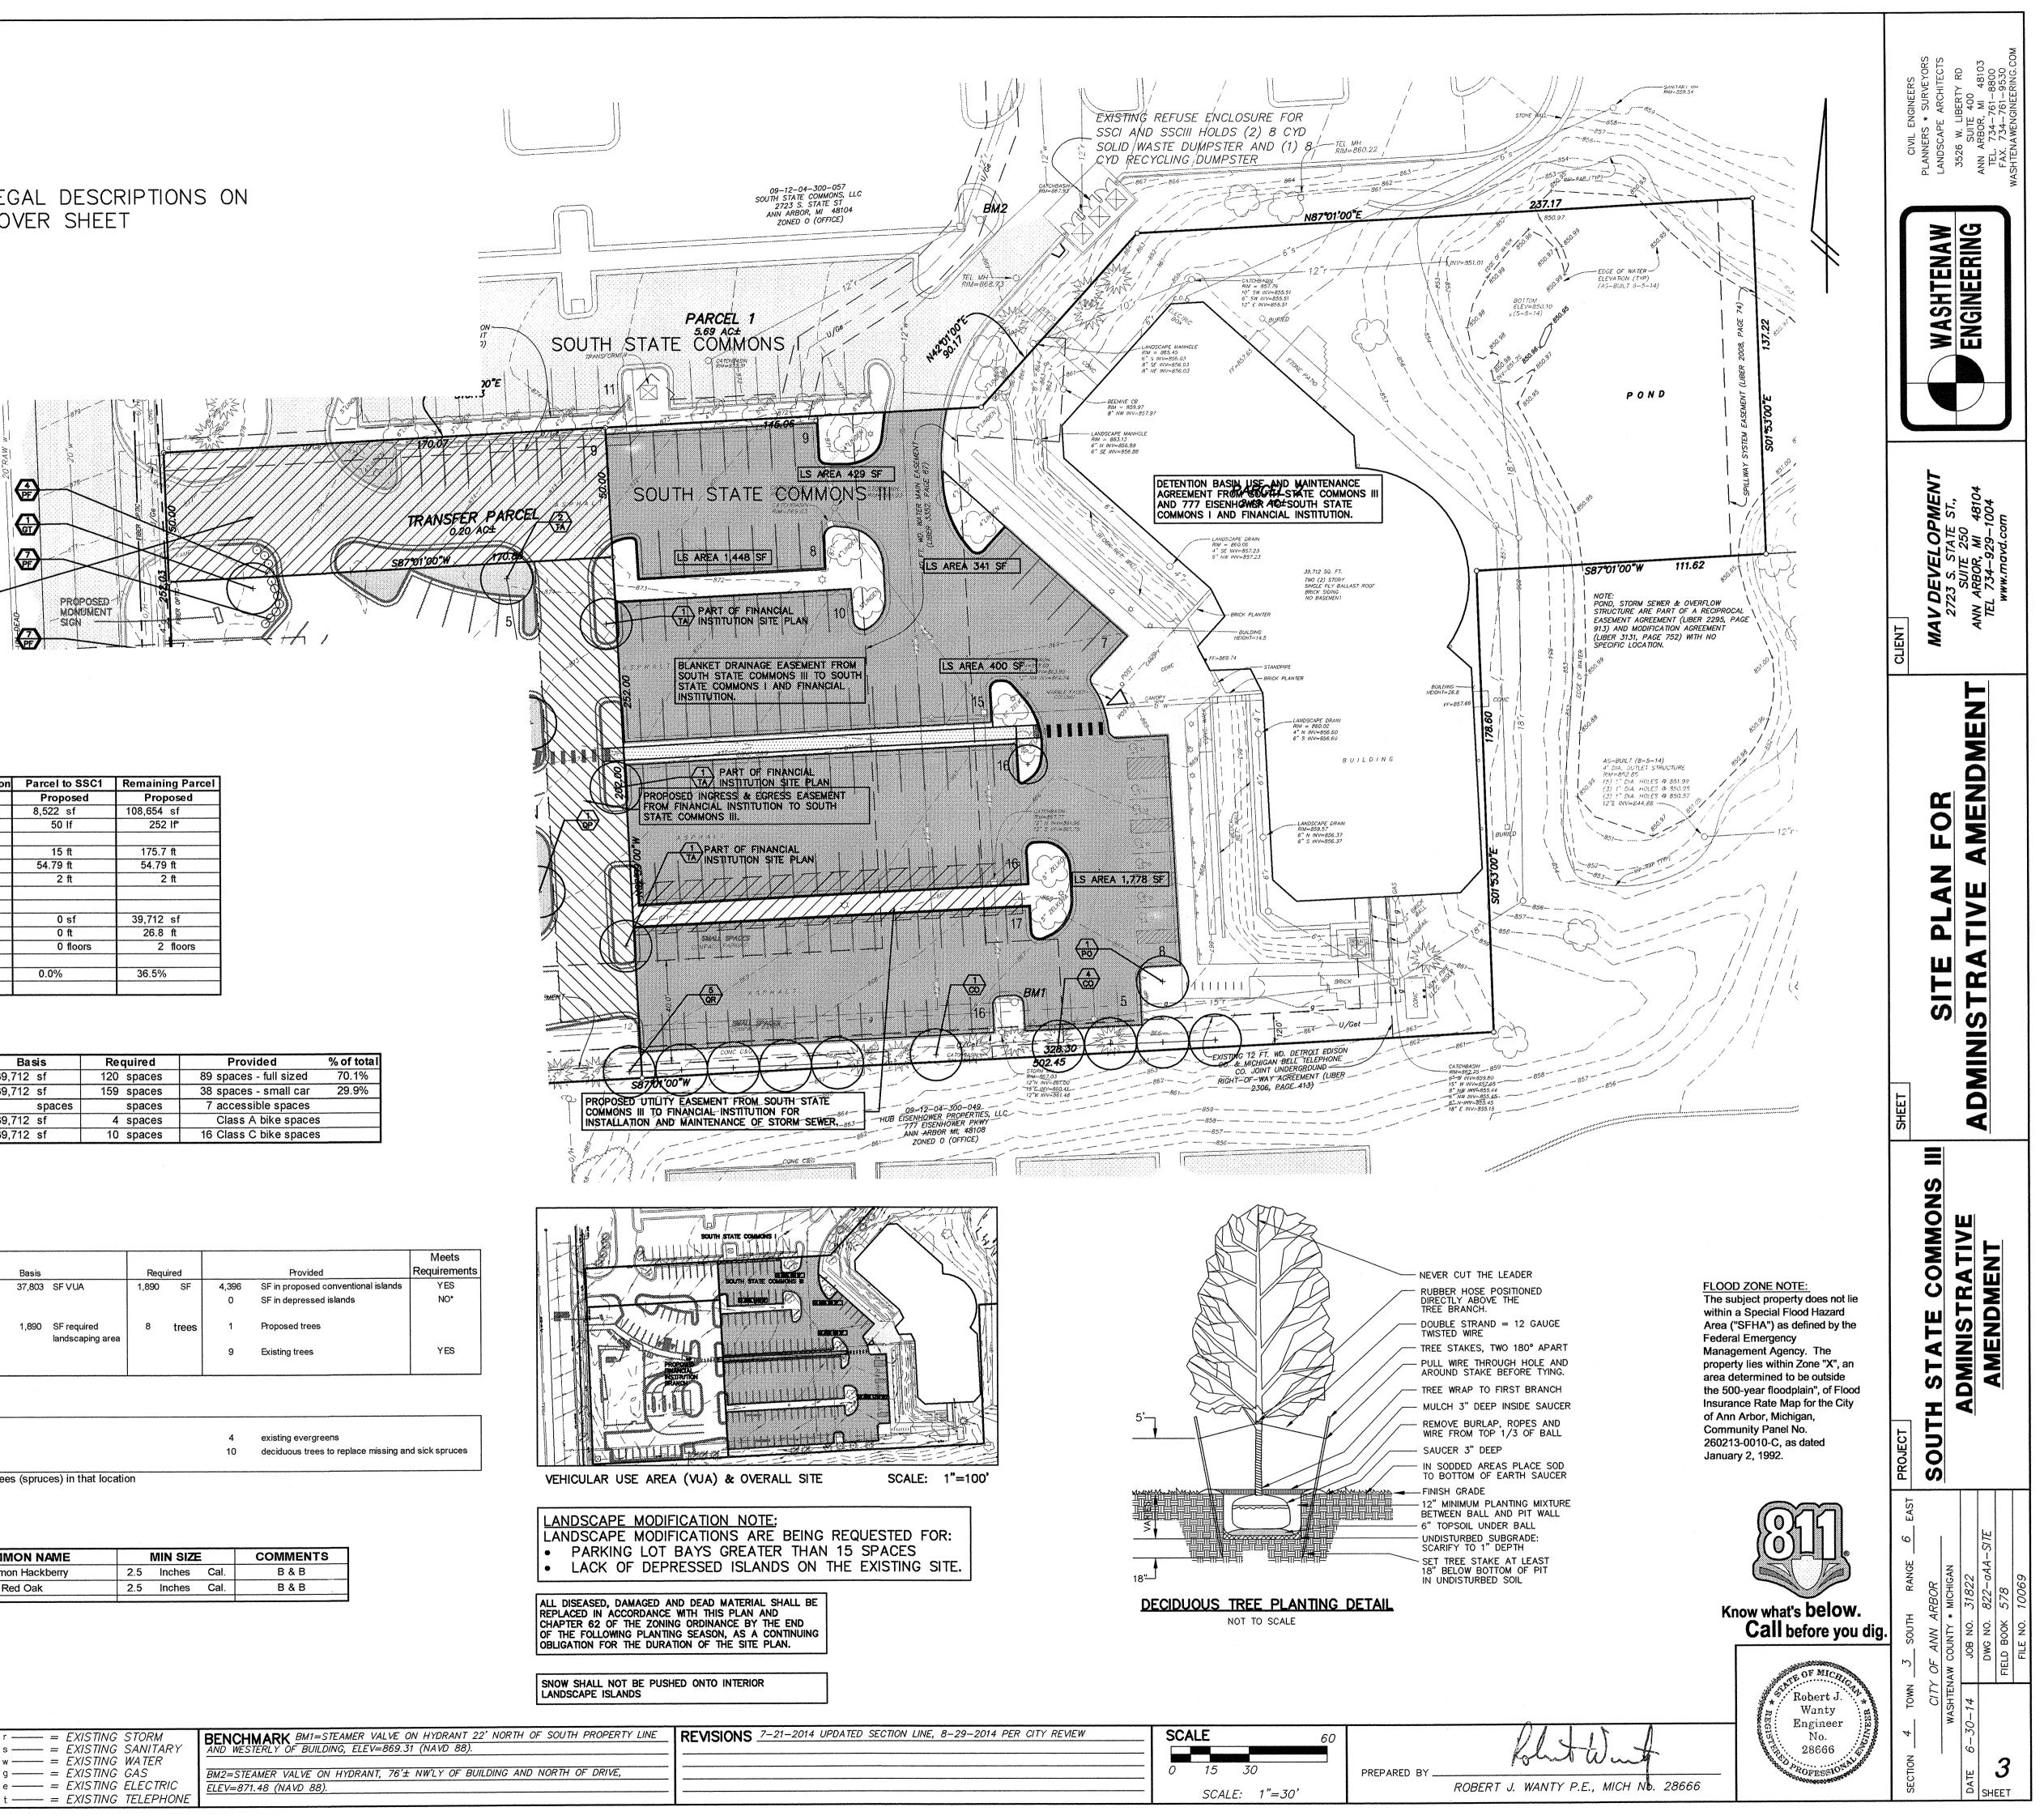

# State Street Commons III **Comparison Chart**

M1/O Zoning: Proposed Zoning: O

			TOTAL - PRE-SPLI	T Financial Institution	Parcel to SSC1	Remaining Parcel
Requi	red	Min/Max	Existing	Proposed	Proposed	Proposed
6,000	sf	Min	152,024 sf	34,848 sf	8,522 sf	108,654 sf
50	ft	Min	252.03 lf	202.03 lf	50 lf	252 lf*
*******						
15/40	ft	Min/Max	346.09 ft	15 ft	15 ft	175.7 ft
0	ft	Min	54.79 ft	49.33 ft	54.79 ft	54.79 ft
0	ft	Min	2 ft	104.51 ft	2 ft	2 ft
114,018	sf	Max	39,712 sf	4,900 sf	0 sf	39,712 sf
55	ft	Max	26.8 ft	26.8 ft	0 ft	26.8 ft
4	stories	Max	2 floors	2 floors	0 floors	2 floors
75	%	Max	26.1%	14.1%	0.0%	36.5%
	6,000 50 15/40 0 0 114,018 55 4	6,000 sf 50 ft 15/40 ft 0 ft 0 ft 114,018 sf 55 ft	6,000 sf Min 50 ft Min 15/40 ft Min/Max 0 ft Min 0 ft Min 114,018 sf Max 55 ft Max 4 stories Max	Required         Min/Max         Existing           6,000 sf         Min         152,024 sf           50 ft         Min         252.03 lf           15/40 ft         Min/Max         346.09 ft           0 ft         Min         54.79 ft           0 ft         Min         2 ft           114,018 sf         Max         39,712 sf           55 ft         Max         2 floors	Required         Min/Max         Existing         Proposed           6,000 sf         Min         152,024 sf         34,848 sf           50 ft         Min         252.03 lf         202.03 lf           15/40 ft         Min/Max         346.09 ft         15 ft           0 ft         Min         54.79 ft         49.33 ft           0 ft         Min         2 ft         104.51 ft           114,018 sf         Max         39,712 sf         4,900 sf           55 ft         Max         26.8 ft         26.8 ft           4 stories         Max         2 floors         2 floors	Required         Min/Max         Existing         Proposed         Proposed           6,000 sf         Min         152,024 sf         34,848 sf         8,522 sf           50 ft         Min         252.03 lf         202.03 lf         50 lf           15/40 ft         Min/Max         346.09 ft         15 ft         15 ft           0 ft         Min         54.79 ft         49.33 ft         54.79 ft           0 ft         Min         2 ft         104.51 ft         2 ft           114,018 sf         Max         39,712 sf         4,900 sf         0 sf           4 stories         Max         2 ftoors         2 ftoors         0 ftoors

### **Off-Street Parking Required**

Office - Du	siness Professional			
	Requirement	Basis	Required	Provi
Min	1 space per 333 sf floor area	39,712 sf	120 spaces	89 spaces
Max	1 space per 250 sf floor area	39,712 sf	159 spaces	38 spaces
	Pertable	spaces	spaces	7 accessi
Class A	0.3 space per 3,000 sf floor area	39,712 sf	4 spaces	Class A
Class C	0.7 space per 3,000 sf floor area	39,712 sf	10 spaces	16 Class C
	Min Max Class A	Requirement         Min       1 space per       333       sf floor area         Max       1 space per       250       sf floor area         Per table       Class A       0.3 space per       3,000       sf floor area	RequirementBasisMin1 space per333sf floor area39,712sfMax1 space per250sf floor area39,712sfPer tablePer tablespacesClass A0.3 space per3,000sf floor area39,712sf	RequirementBasisRequiredMin1 space per333sf floor area39,712 sf120 spacesMax1 space per250sf floor area39,712 sf159 spacesPer tablespacesspacesspacesspacesClass A0.3 space per3,000sf floor area39,712 sf4 spaces

\* Included in total automobile spaces

### LANDSCAPING REQUIREMENTS State Street Commons III

Right of Way Screening - no road frontage

	Requirement			Basis		Requ	ired	
Landscaping Islands	1 SF landscaping island area per	20	SF VUA	37,803	SF VUA	1,890	SF	4,39
								0
Trees	1 canopy tree per	250	SF required landscaping area	1,890	SF required landscaping area	8	trees	1
								9

Original Site Plan Plantings


Trees along south parking lot border


14 evergreen trees

Note: Deciduous trees were used to replace evergreens due to repeated loss of evergreen trees (spruces) in that location

## PLANT LIST

QUANTITY	SCIENTIFIC NAME	COMMON NAME	MIN SIZE
5	Celtis occidentalis	Common Hackberry	2.5 Inches Cal.
5	Quercus rubra	Red Oak	2.5 Inches Cal.
	QUANTITY55	5 Celtis occidentalis	5 Celtis occidentalis Common Hackberry

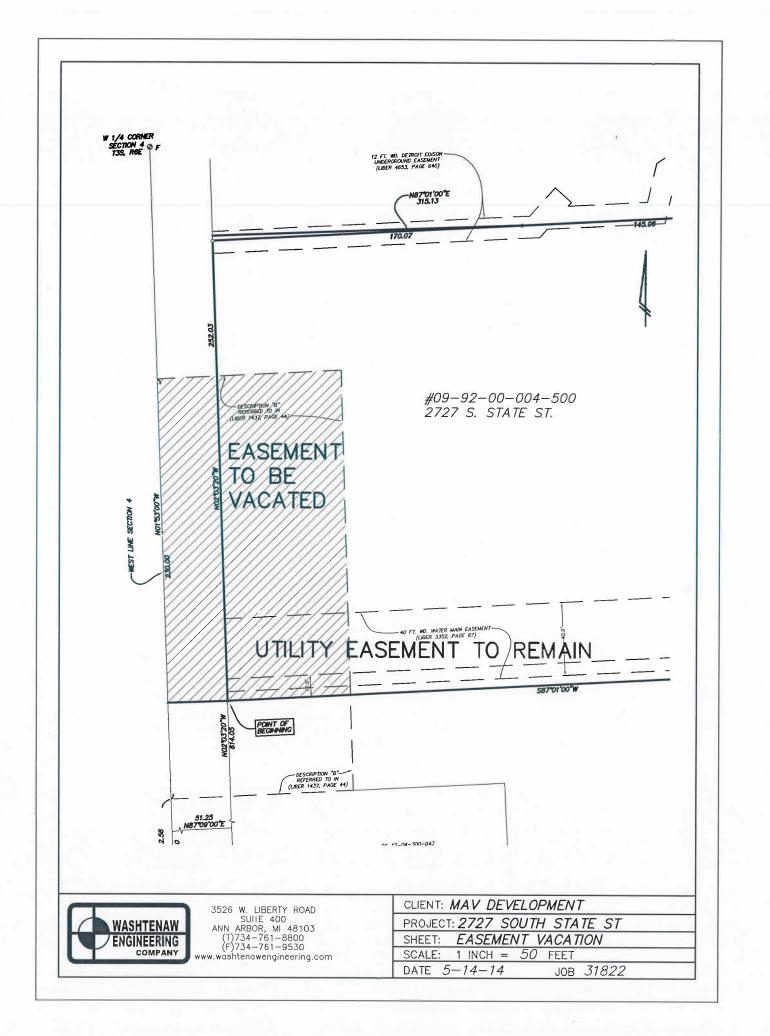

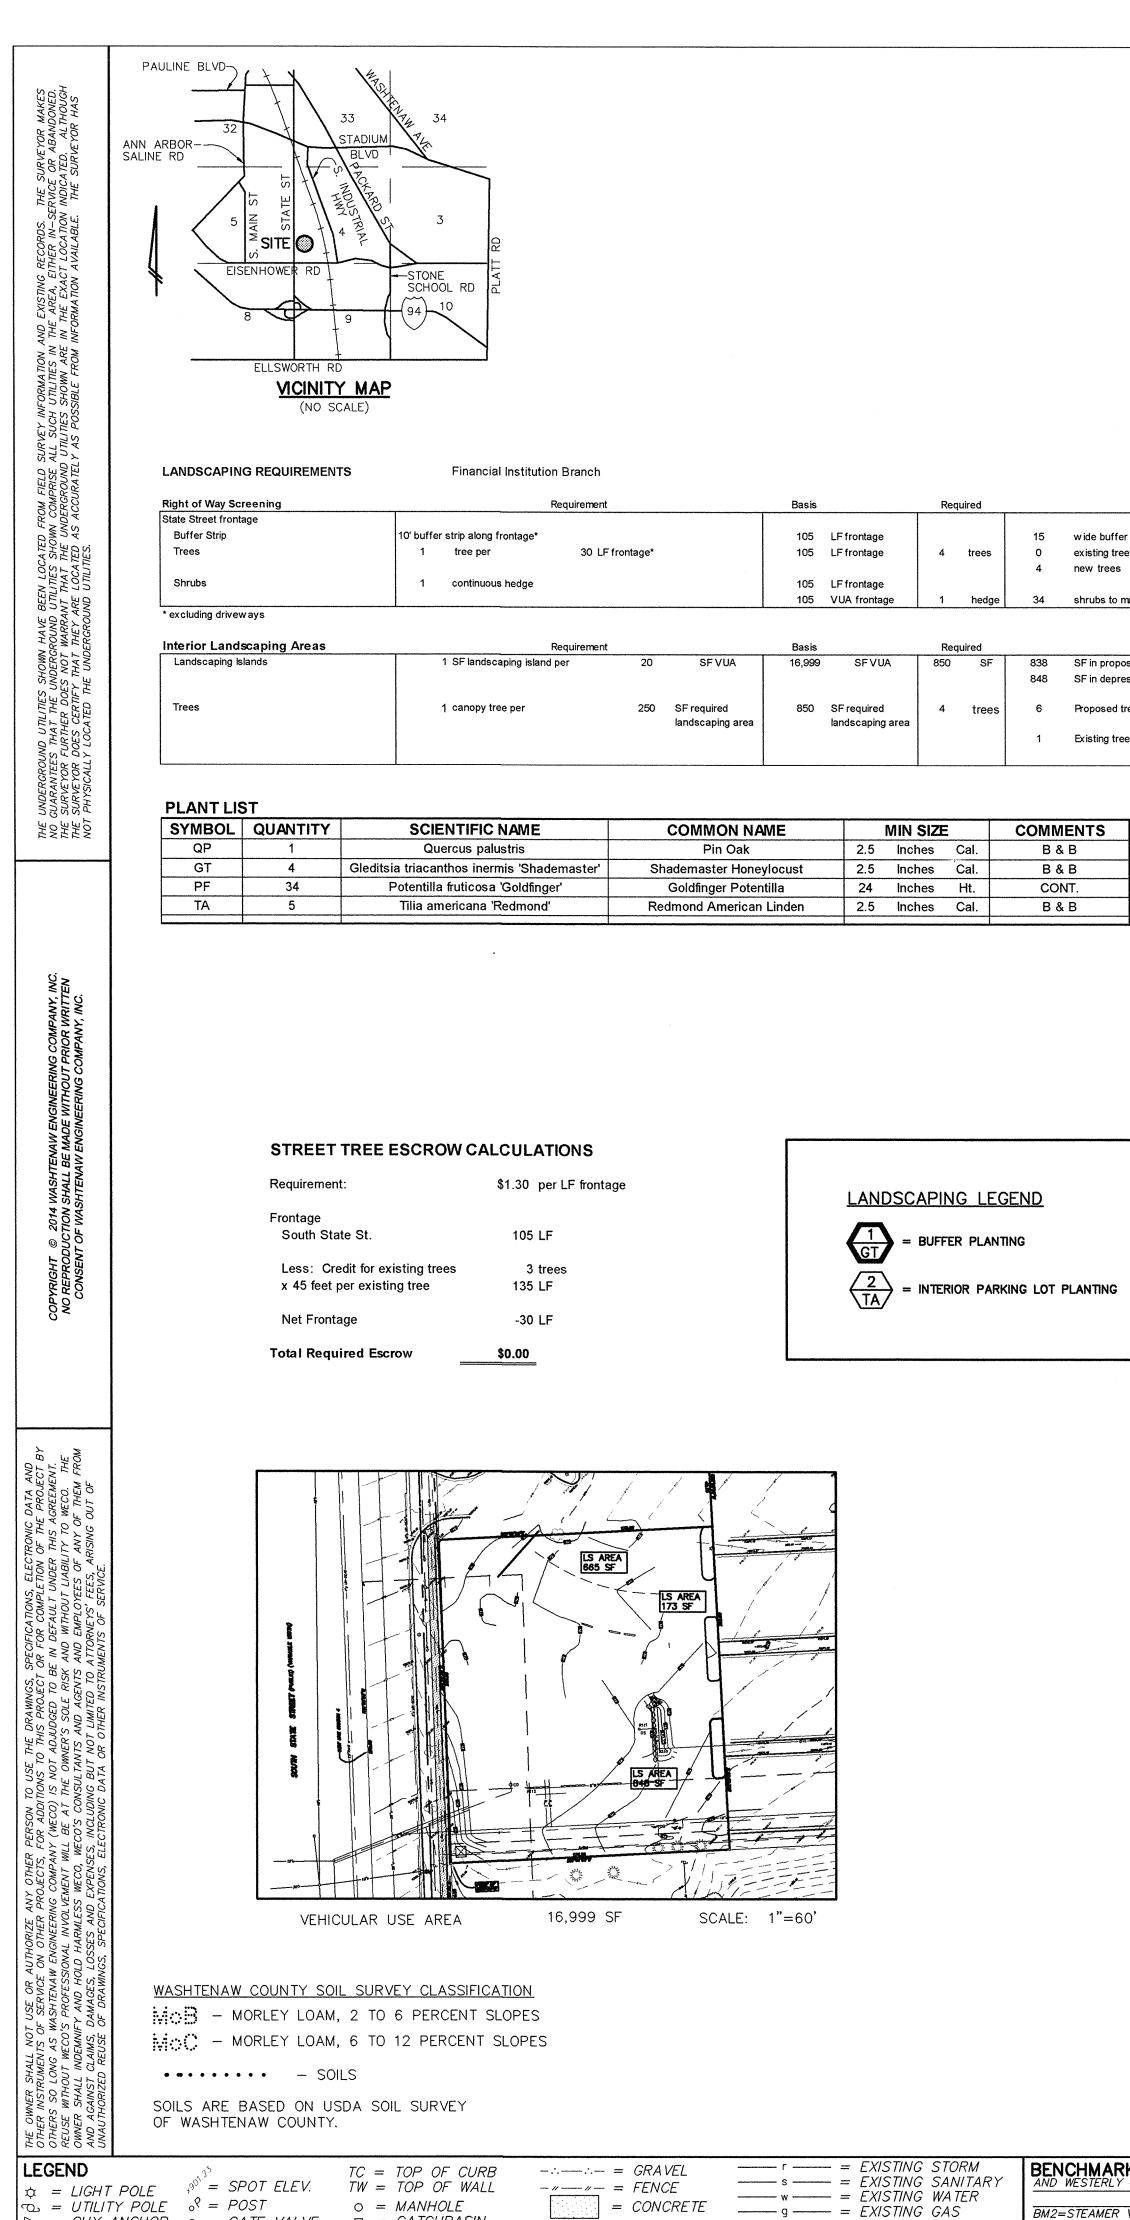


 $\succ = GUY ANCHOR \otimes = GATE VALVE$ 

 $\heartsuit = HYDRANT \longrightarrow = SIGN$ 

 $\Box = CATCHBASIN$ 

 $\smile$  = END SECTION

<u>NC</u>	) TES PLAN IRRIG ALL	NTS GATIO	DN	SY
•	REPL			-
				• •
	THE	FOL	LOV	٧N
	FOR	THE	DI	JR/
•	SNO	N Sł	IAL	LI
	ISLA	NDS.		
•	APPI		TIOI	٧S
	SEED	DING	SH	IAL

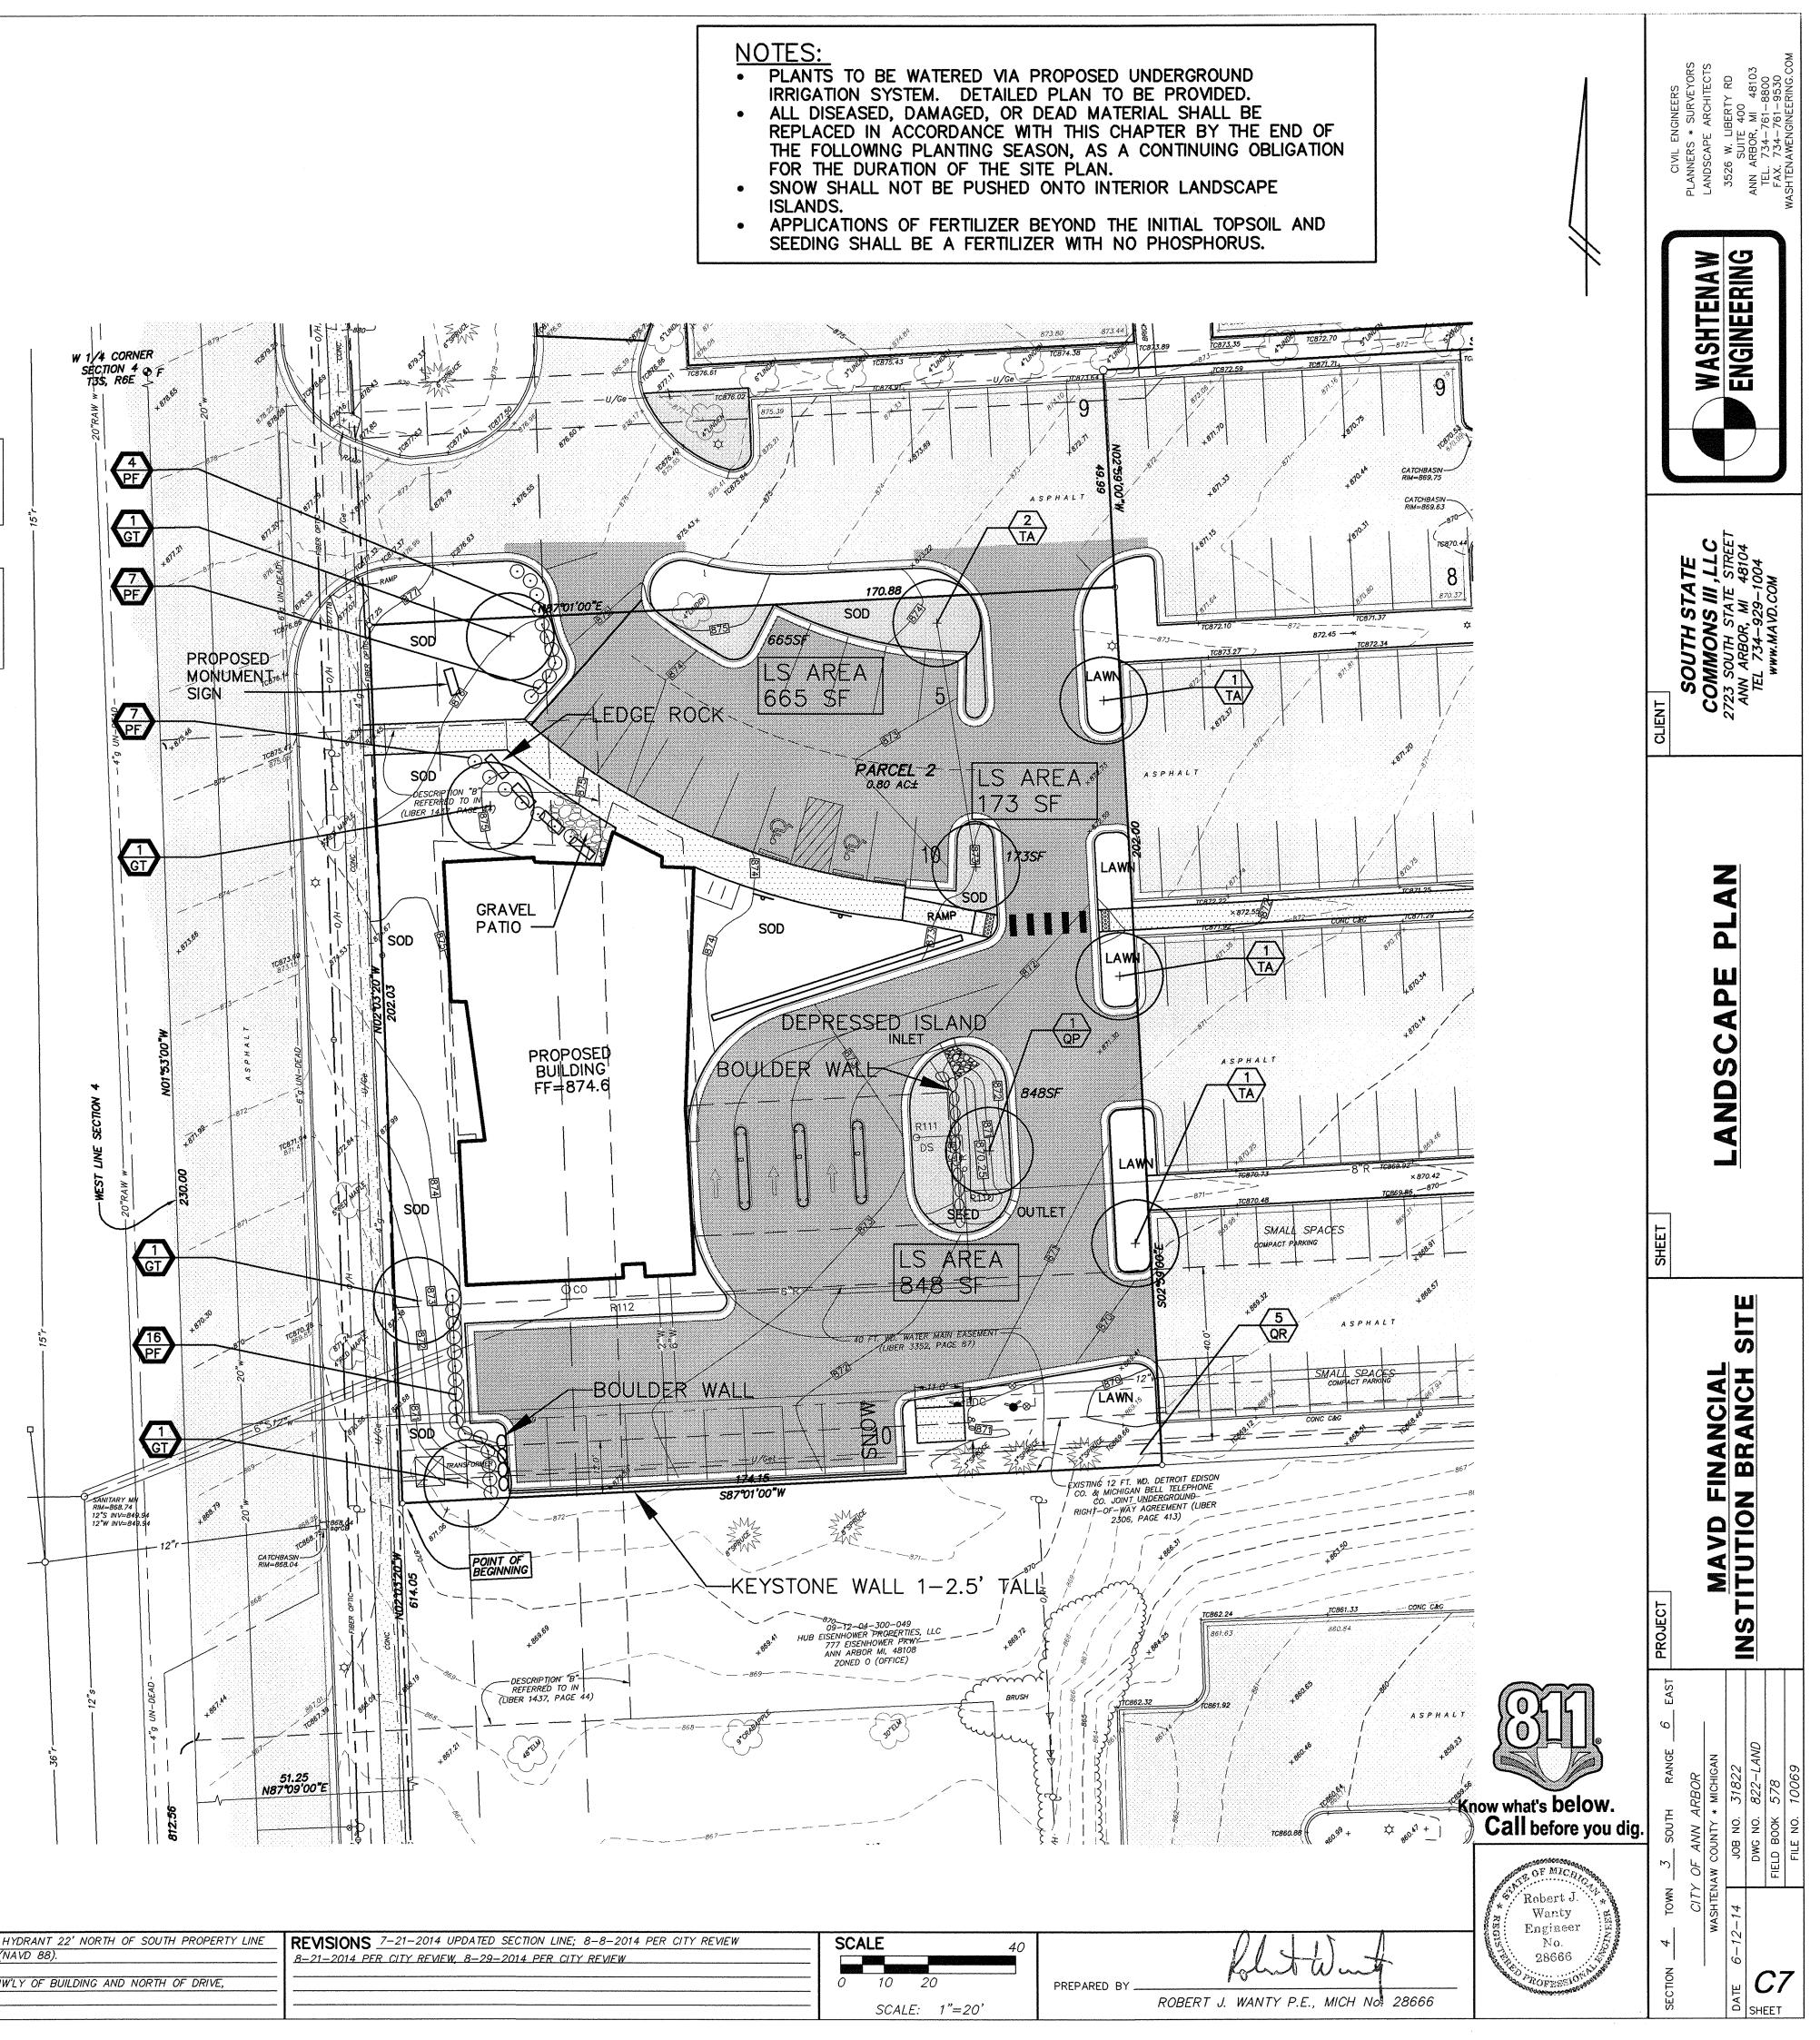

wide buffer strip along road frontage existing trees new trees			
shrubs to make continuous hedge			
Provided			
SF in proposed conventional islands			
SF in depressed islands			
Proposed trees Existing trees			
<b>:NTS</b> 3 3 т.			


Provided

-----e ----- = EXISTING ELECTRIC

----- t ----- = EXISTING TELEPHONE

= ASPHALT

BENCHMARK BM1=STEAMER VALVE ON HYDRANT 22' NORTH OF SOUTH PROPERTY LINE	REVISIONS 7-21-2014 UPDATED SECTION LINE; 8-8-2014 PER CITY REVIEW	SCALE
AND WESTERLY OF BUILDING, ELEV=869.31 (NAVD 88).	8-21-2014 PER CITY REVIEW, 8-29-2014 PER CITY REVIEW	
BM2=STEAMER VALVE ON HYDRANT, 76'± NW'LY OF BUILDING AND NORTH OF DRIVE,		0 10
<u>ELEV=871.48 (NAVD 88).</u>		sc

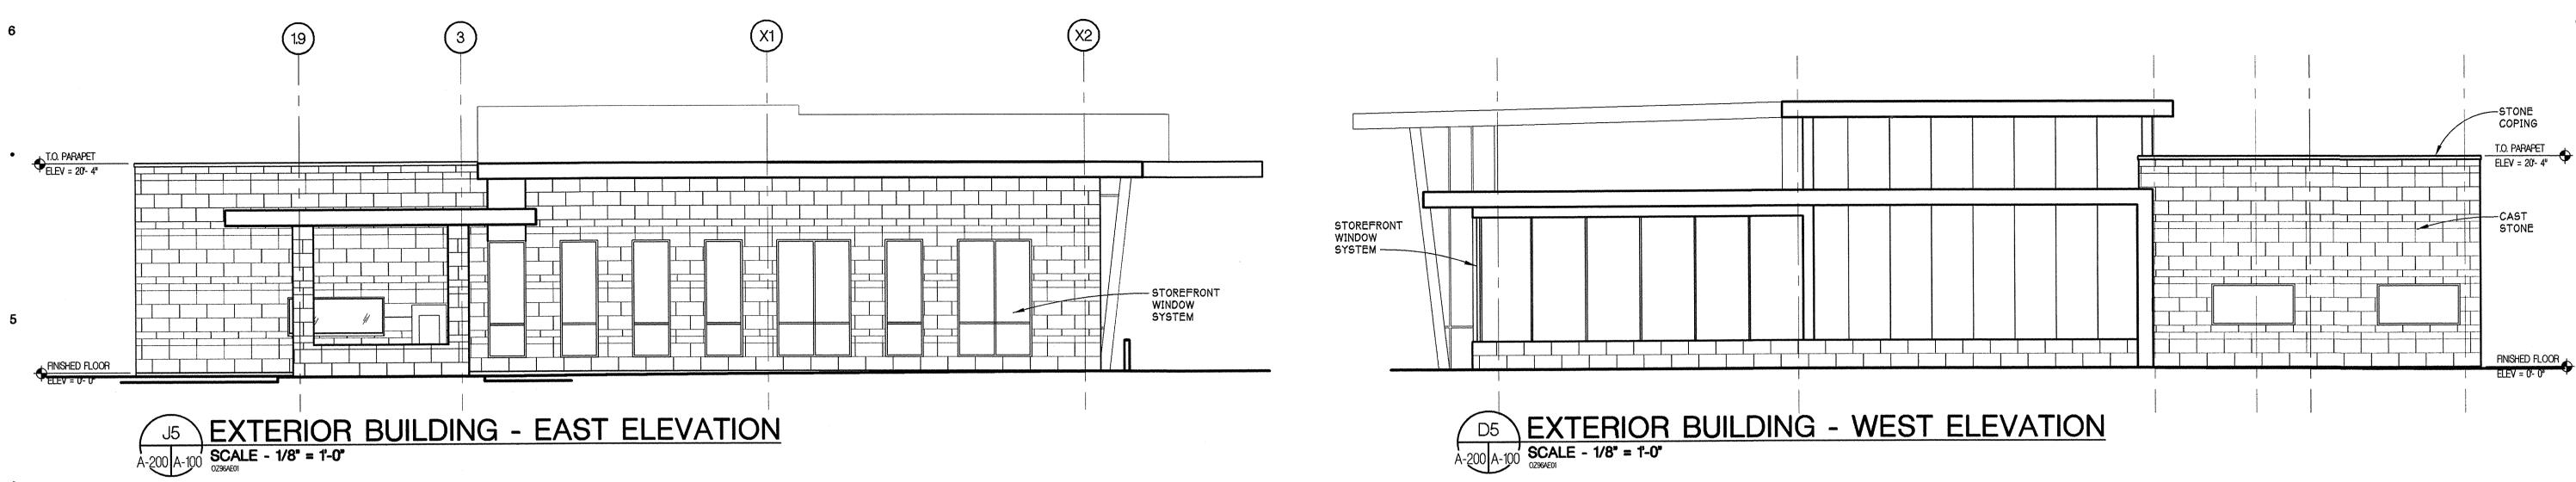

٠

Ε

•

G

•

G

٠

٠

Н


٠


3

F

F

٠

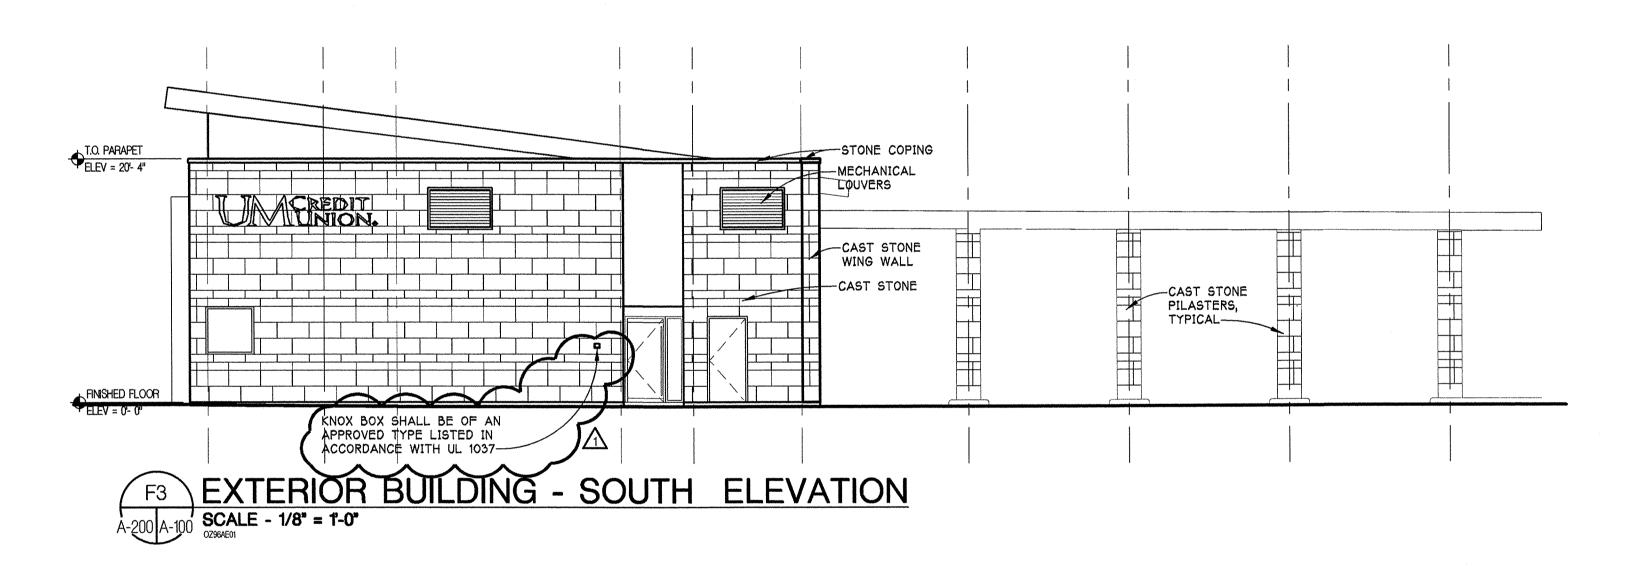

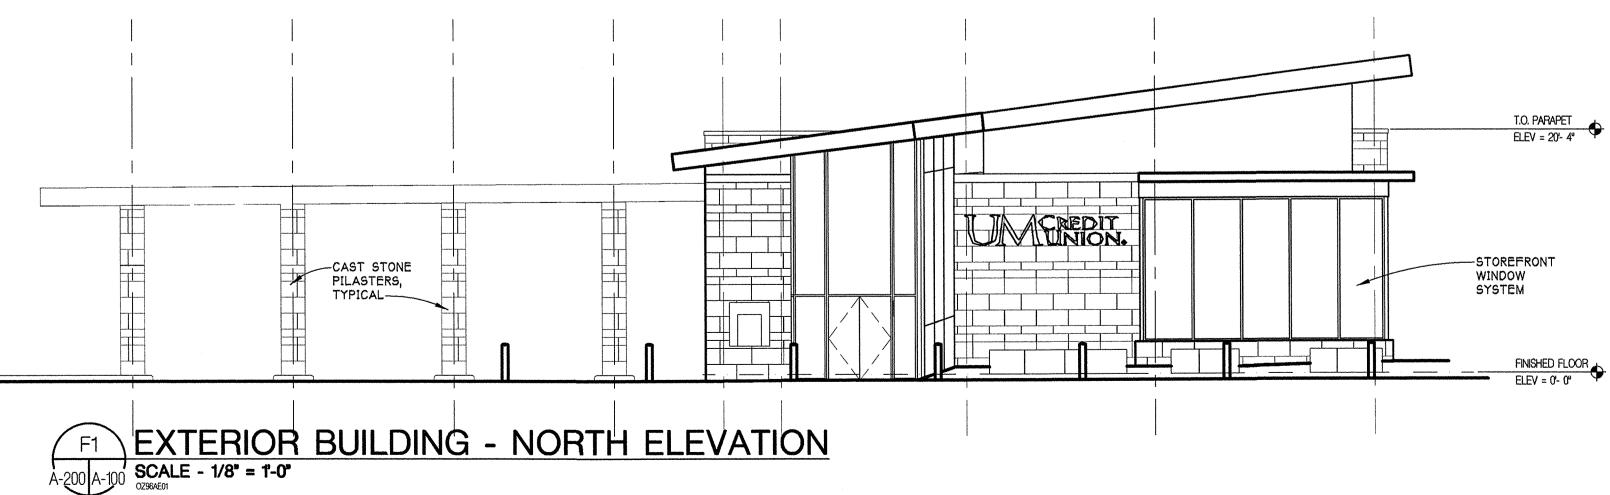

•

D

٠

Ε

٠

٠

Н

D

٠

С

٠

•

С

T.O. PARAPET ELEV = 20'- 4"

В

٠

Α

٠

В

٠

2

CONSULTANT

SHEET TITLE

PROJECT

EXTERIOR ELEVATIONS

14-201

A-200

PROJECT NUMBER

SHEET NUMBER

60 S 8

 $\mathbf{Y}$ 

CHECKED BY

DRAWN BY

SITE PLAN 8/08/14 6/30/14 SITE PLAN APPROVAL 6/25/14 SITE PLAN REVIEW SET SITE PLAN PRE-APPLICATION 4/23/14 DATE ISSUED

Sheet Size - 24x36 © Copyright 2012 Hobbs+Black Associates, Inc ALL RIGHTS RESERVED



### **City of Ann Arbor**

PLANNING & DEVELOPMENT SERVICES - PLANNING DIVISION

301 East Huron Street P.O. Box 8647 Ann Arbor, Michigan 48107-8647 p. 734.794.6265 | f. 734.994.8312 | planning@a2gov.org

### **APPLICATION FOR MODIFICATIONS FROM** CHAPTER 62 (LANDSCAPE AND SCREENING)

See www.a2gov.org/planning for submittal requirements.

#### TO: Ann Arbor City Planning Commission

We, the undersigned, respectfully petition the City Planning Commission or City Council to approve these modifications from the landscape and/or screening requirements of Sections 5:602, 5:603, 5:604 or 5:606 of Chapter 62, as they relate to the property hereinafter described.

### A. Project Information

(Give name of site plan project and tax code number of property)

South State Commons I

2723 South State Street, Ann Arbor, MI 48104

09-12-04-300-057

### **B.** Petitioner Information

The petitioner(s) requesting the modifications are:

(List petitioners' name; address; telephone number; and interest in the land; i.e., owner, land contract, option to purchase, etc.)

MAV Development (Owner)

2723 South State Street, Suite 250

Ann Arbor, MI 48104

Phone 734-929-1004

Also interested in the petition are: (List others with legal or equitable interest)

S:/PROJECTS/UM CREDIT UNION/ADMINISTRATIVE AMENDMENT SUBMITTAL/Application for Landscape Modification SS1.doc

### **C. Modification Request**

The petitioner requests approval to modify the above landscape and/or screening requirements in the following ways (if necessary, attach additional page):

Section S:602 , Paragraph (2)g Section 5:608 Paragraph (2)(c) vii

There are no depressed parking islands on the remaining parcel. The petitioner requests to leave the

parcel and islands in their current configuration.

Section <u>S:602</u>, Paragraph (2)d Section 5:608 Paragraph (2)(c) vii

There are 16 contiguous parking spaces in 1 bay and the southern most bay forms a total of 18 spaces

in one bay with the adjacent 2727 bay.

#### D. Standards for Approval

Flexibility in the application of the landscape and screening regulations may be allowed if certain standards are met. The modifications must be consistent with the intent of Chapter 62; be included on a site plan and in a motion approved by the City Planning Commission or City Council; and be associated with specific site conditions as listed in Section 5:608(2)(c).

1. What are the specific site conditions that necessitate this request and how do they warrant the modifications of Chapter 62 requirements? (See Section 5:608(2)(c)) List relevant subsection and explain how and to what extent the modifications are justified.

A portion of the 2727 South State property is being transferred to the 2723 South State property. The

existing and proposed enlarged 2723 South State property meets all current landscaping standards with the

exceptions listed on this application.

2. How does the proposal meet the spirit and intent of Chapter 62? (See Section 5:600)

The parcel meets or exceeds all existing standards that existed when it was revised in 2006 and

meets all current standards regarding screening, interior landscape island and interior landscaping

canopy trees.

S:\PROJECTS\UM CREDIT UNION\ADMINISTRATIVE AMENDMENT SUBMITTAL\Application for Landscape Modification SS1.doc

The undersigned states he/she is interested in the property as aforesaid and that the foregoing statements are true and correct to the best of his/her knowledge and belief.

June 262014 Dated:

Signature: South State Commons III, L.L.C., a Michigan Limited Liability Company

> By: Vlasic Properties, L.L.C., a Michigan Limited Liability Company Its: Sole Member

By: MAV Development Company Its: Manager

a. and By:

Robert A. Aldrich It's President

### STATE OF MICHIGAN

COUNTY OF WASHTENAW

) ) ss:

)

On this *H* day of \_\_\_\_\_\_, 20 *H* before me personally appeared the above named petitioner(s), who being duly sworn, say that they have read the foregoing petition and by them signed, and know the contents thereof, and that the same is true of their knowledge, except as to the matter therein stated to be upon their information and belief, and as to those matters they believe it to be true.

LORELEI E SMITH	- 77	
Gerege Michigan	Signature:	- 3
Genesee anty My Commission Extrast aug 9, 2020	Lorelei E. Smith.	
Westienae	(Print name of Notary Public)	-

My Commission Expires: Uluncot 92020



### City of Ann Arbor

PLANNING & DEVELOPMENT SERVICES --- PLANNING DIVISION

301 East Huron Street | P.O. Box 8647 | Ann Arbor, Michigan 48107-8647 p. 734.794.6265 | f. 734.994.8312 | planning@a2gov.org

### APPLICATION FOR MODIFICATIONS FROM CHAPTER 62 (LANDSCAPE AND SCREENING) See www.a2gov.org/planning for submittal requirements.

TO: Ann Arbor City Planning Commission

We, the undersigned, respectfully petition the City Planning Commission or City Council to approve these modifications from the landscape and/or screening requirements of Sections 5:602, 5:603, 5:604 or 5:606 of Chapter 62, as they relate to the property hereinafter described.

### A. Project Information

(Give name of site plan project and tax code number of property)

South State Commons III

2727 South State Street, Ann Arbor, MI 48104

09-92-00-004-500

### B. Petitioner Information

The petitioner(s) requesting the modifications are: (List petitioners' name; address; telephone number; and interest in the land; i.e., owner, land contract, option to purchase, etc.)

MAV Development (Owner)	
2723 South State Street, Suite 250	
Ann Arbor, MI 48104	
Phone 734-929-1004	

Also interested in the petition are: (List others with legal or equitable interest)

S:\PROJECTS\UM CREDIT UNION\ADMINISTRATIVE AMENDMENT SUBMITTAL\Application for Landscape Modification SS3.doc

#### C. Modification Request

The petitioner requests approval to modify the above landscape and/or screening requirements in the following ways (if necessary, attach additional page):

 Section S:602
 Paragraph (2)g
 Section 5:608 Paragraph (2)(c) vii

 There are no depressed parking islands on the remaining parcel. The petitioner requests to leave the

 parcel and islands in their current configuration.

 Section S:602
 Paragraph (2)d

 Section S:602
 Paragraph (2)d

 Section S:602
 Paragraph (2)d

 Section S:608 Paragraph (2)(c) vii

 There are more than 15 contiguous parking spaces in 4 bays – 17 in one and 16 in three; and the northern

 most bay forms a total of 18 spaces in one bay with the adjacent 2723 bay.

#### D. Standards for Approval

Flexibility in the application of the landscape and screening regulations may be allowed if certain standards are met. The modifications must be consistent with the intent of Chapter 62; be included on a site plan and in a motion approved by the City Planning Commission or City Council; and be associated with specific site conditions as listed in Section 5:608(2)(c).

1. What are the specific site conditions that necessitate this request and how do they warrant the modifications of Chapter 62 requirements? (See Section 5:608(2)(c)) List relevant subsection and explain how and to what extent the modifications are justified.

A portion of the property is being sold. The new parcel will meet all current landscape requirements but the

remaining parcel will remain as is. This landscape modification reflects these areas of noncompliance with

current standards.

2. How does the proposal meet the spirit and intent of Chapter 62? (See Section 5:600)

The parcel meets or exceeds all existing standards that existed when it was revised in 2006 and

meets all current standards regarding screening, interior landscape island and interior landscaping

canopy trees.

The undersigned states he/she is interested in the property as aforesaid and that the foregoing statements are true and correct to the best of his/her knowledge and belief.

24,201 Dated:

Signature: South State Commons III, L.L.C.,

a Michigan Limited Liability Company

By: Vlasic Properties, L.L.C., a Michigan Limited Liability Company Its: Sole Member

By: MAV Development Company Its: Manager

. alch By:

Robert A. Aldrich It's President

### STATE OF MICHIGAN

COUNTY OF WASHTENAW

) ss:

)

On this day of \_\_\_\_\_\_, 20 Upefore me personally appeared the above named petitioner(s), who being duly sworn, say that they have read the foregoing petition and by them signed, and know the contents thereof, and that the same is true of their knowledge, except as to the matter therein stated to be upon their information and belief, and as to those matters they believe it to be true.

LORELEI E SMITH Notary Public - Michigan Genesee County My Commission Expires Aug 9, 2020 Acting in the County of

Signature

(Print name of Notary Public)

My Commission Expires: Queust 9,202